

COLONNADE
PROFESSIONAL
PLAZA


Floor 02

Suite 230

AS-BUILT

2,688 SF

AVAILABLE

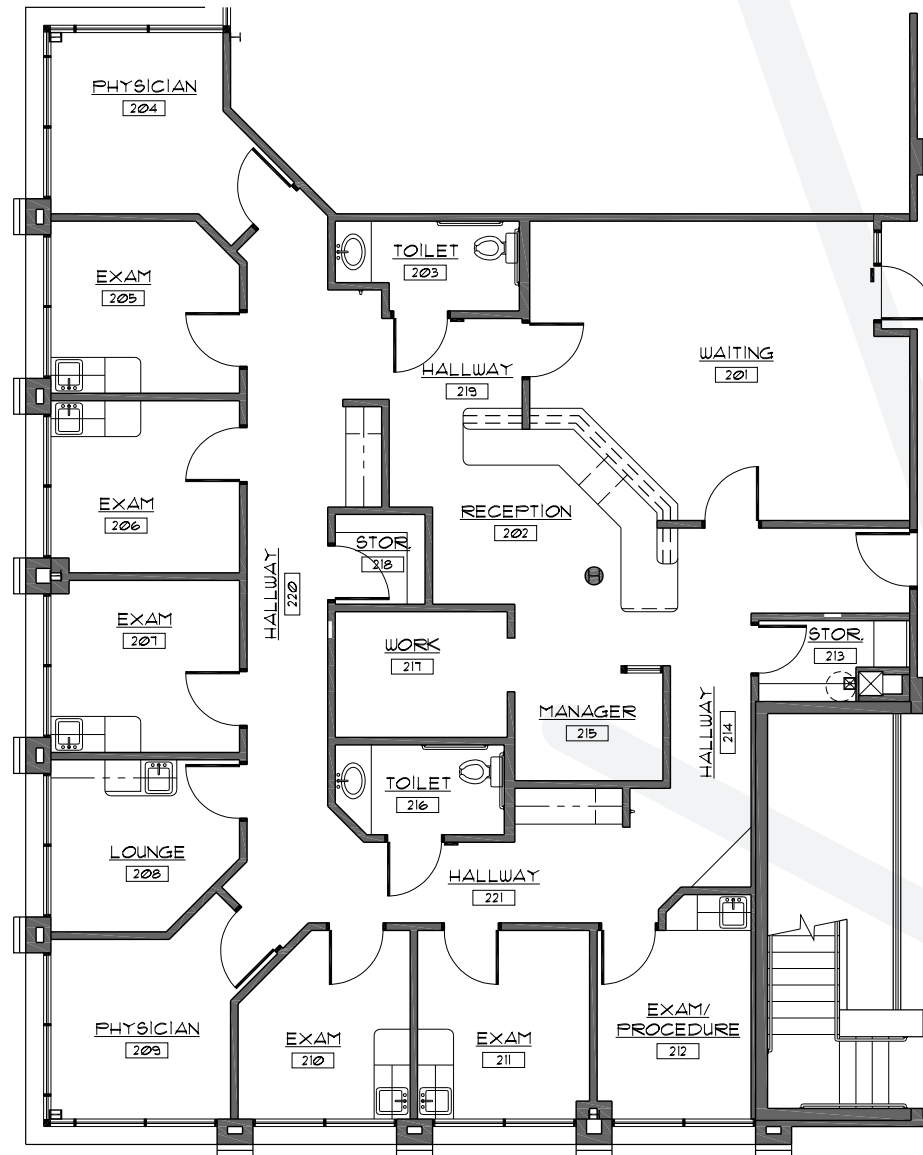

RACHAEL THOMPSON
Senior Vice President
602.513.5122
rachael.thompson@kidder.com

PERRY GABUZZI, CCIM
Executive Vice President
602.513.5116
perry.gabuzzi@kidder.com

COLONNADE
PROFESSIONAL
PLAZA


Floor 02

Suite 240

AS-BUILT

1,616 SF

AVAILABLE

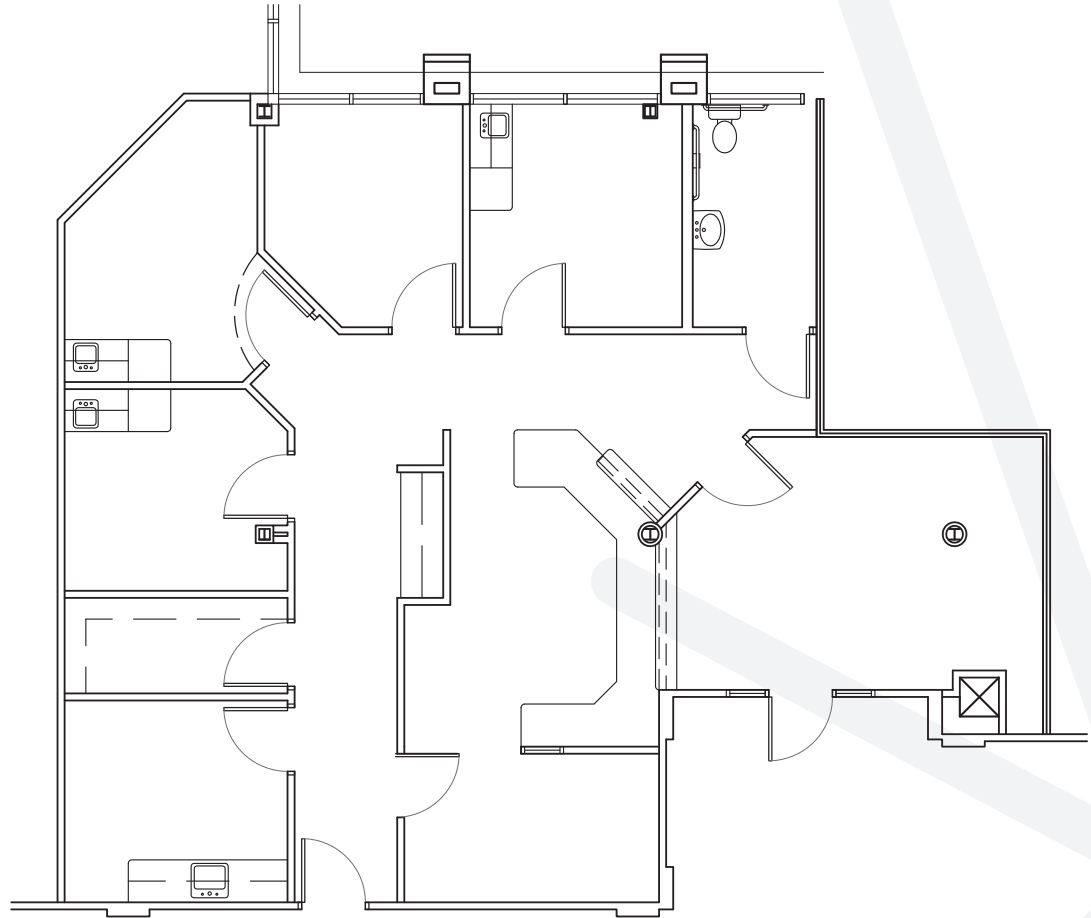

RACHAEL THOMPSON
Senior Vice President
602.513.5122
rachael.thompson@kidder.com

PERRY GABUZZI, CCIM
Executive Vice President
602.513.5116
perry.gabuzzi@kidder.com

COLONNADE
PROFESSIONAL
PLAZA


Floor 02

Suite 250

AS-BUILT

3,446 SF

AVAILABLE

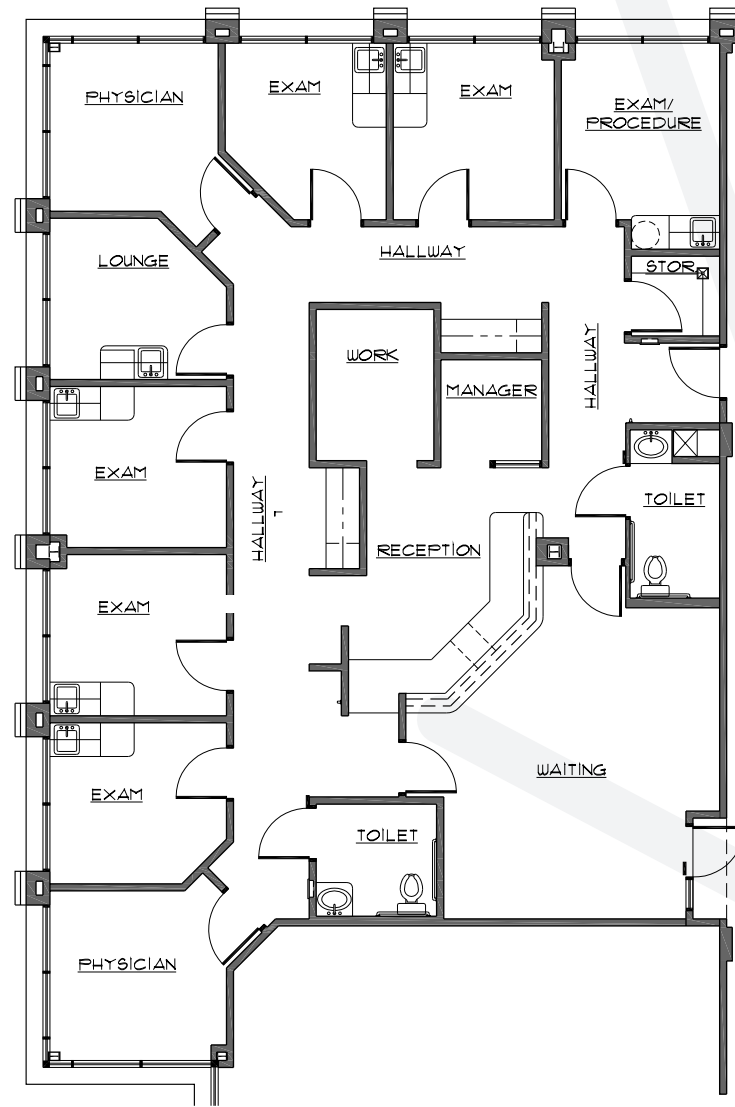

RACHAEL THOMPSON
Senior Vice President
602.513.5122
rachael.thompson@kidder.com

PERRY GABUZZI, CCIM
Executive Vice President
602.513.5116
perry.gabuzzi@kidder.com