


Key Plan

TOTAL SF AVAILABLE -1,812 RSF

OFFICE - 300 RSF

WAREHOUSE - 1,512 RSF

[Click to access CADD file](#)

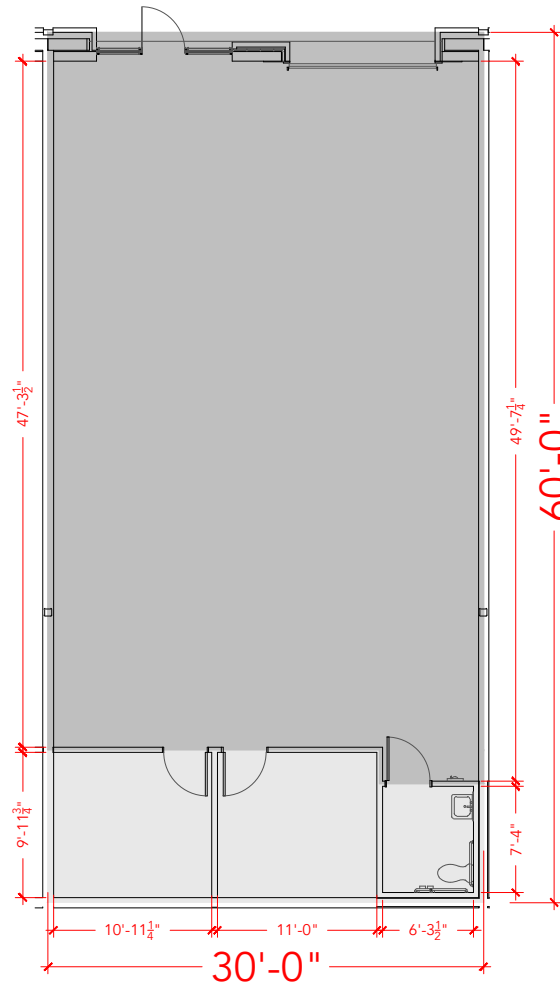

Floor Plan