

**WEBB
MEDICAL
PLAZA A**

14420 W MEEKER BLVD | SUN CITY WEST, AZ 85375

Floor 02


Suite 211A

AS-BUILT

1,632 SF

AVAILABLE

*CONTIGUOUS TO SUITE 211B
FOR 4,116 SF

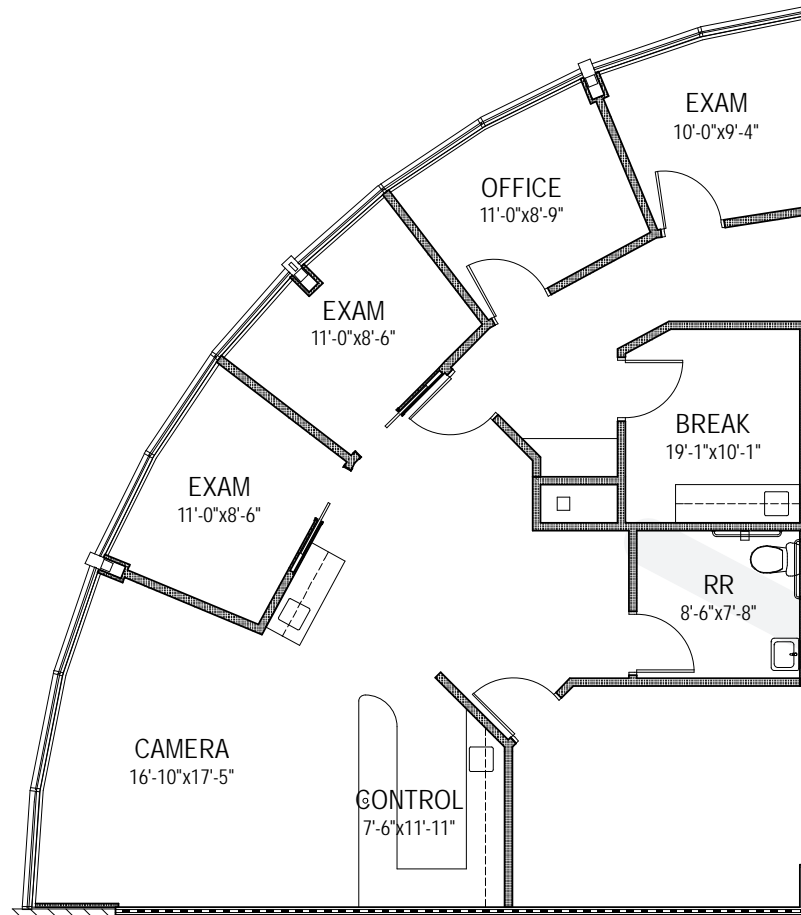

RACHAEL THOMPSON
Senior Vice President
602.513.5122
rachael.thompson@kidder.com

PERRY GABUZZI, CCIM
Senior Vice President
602.513.5116
perry.gabuzzi@kidder.com