



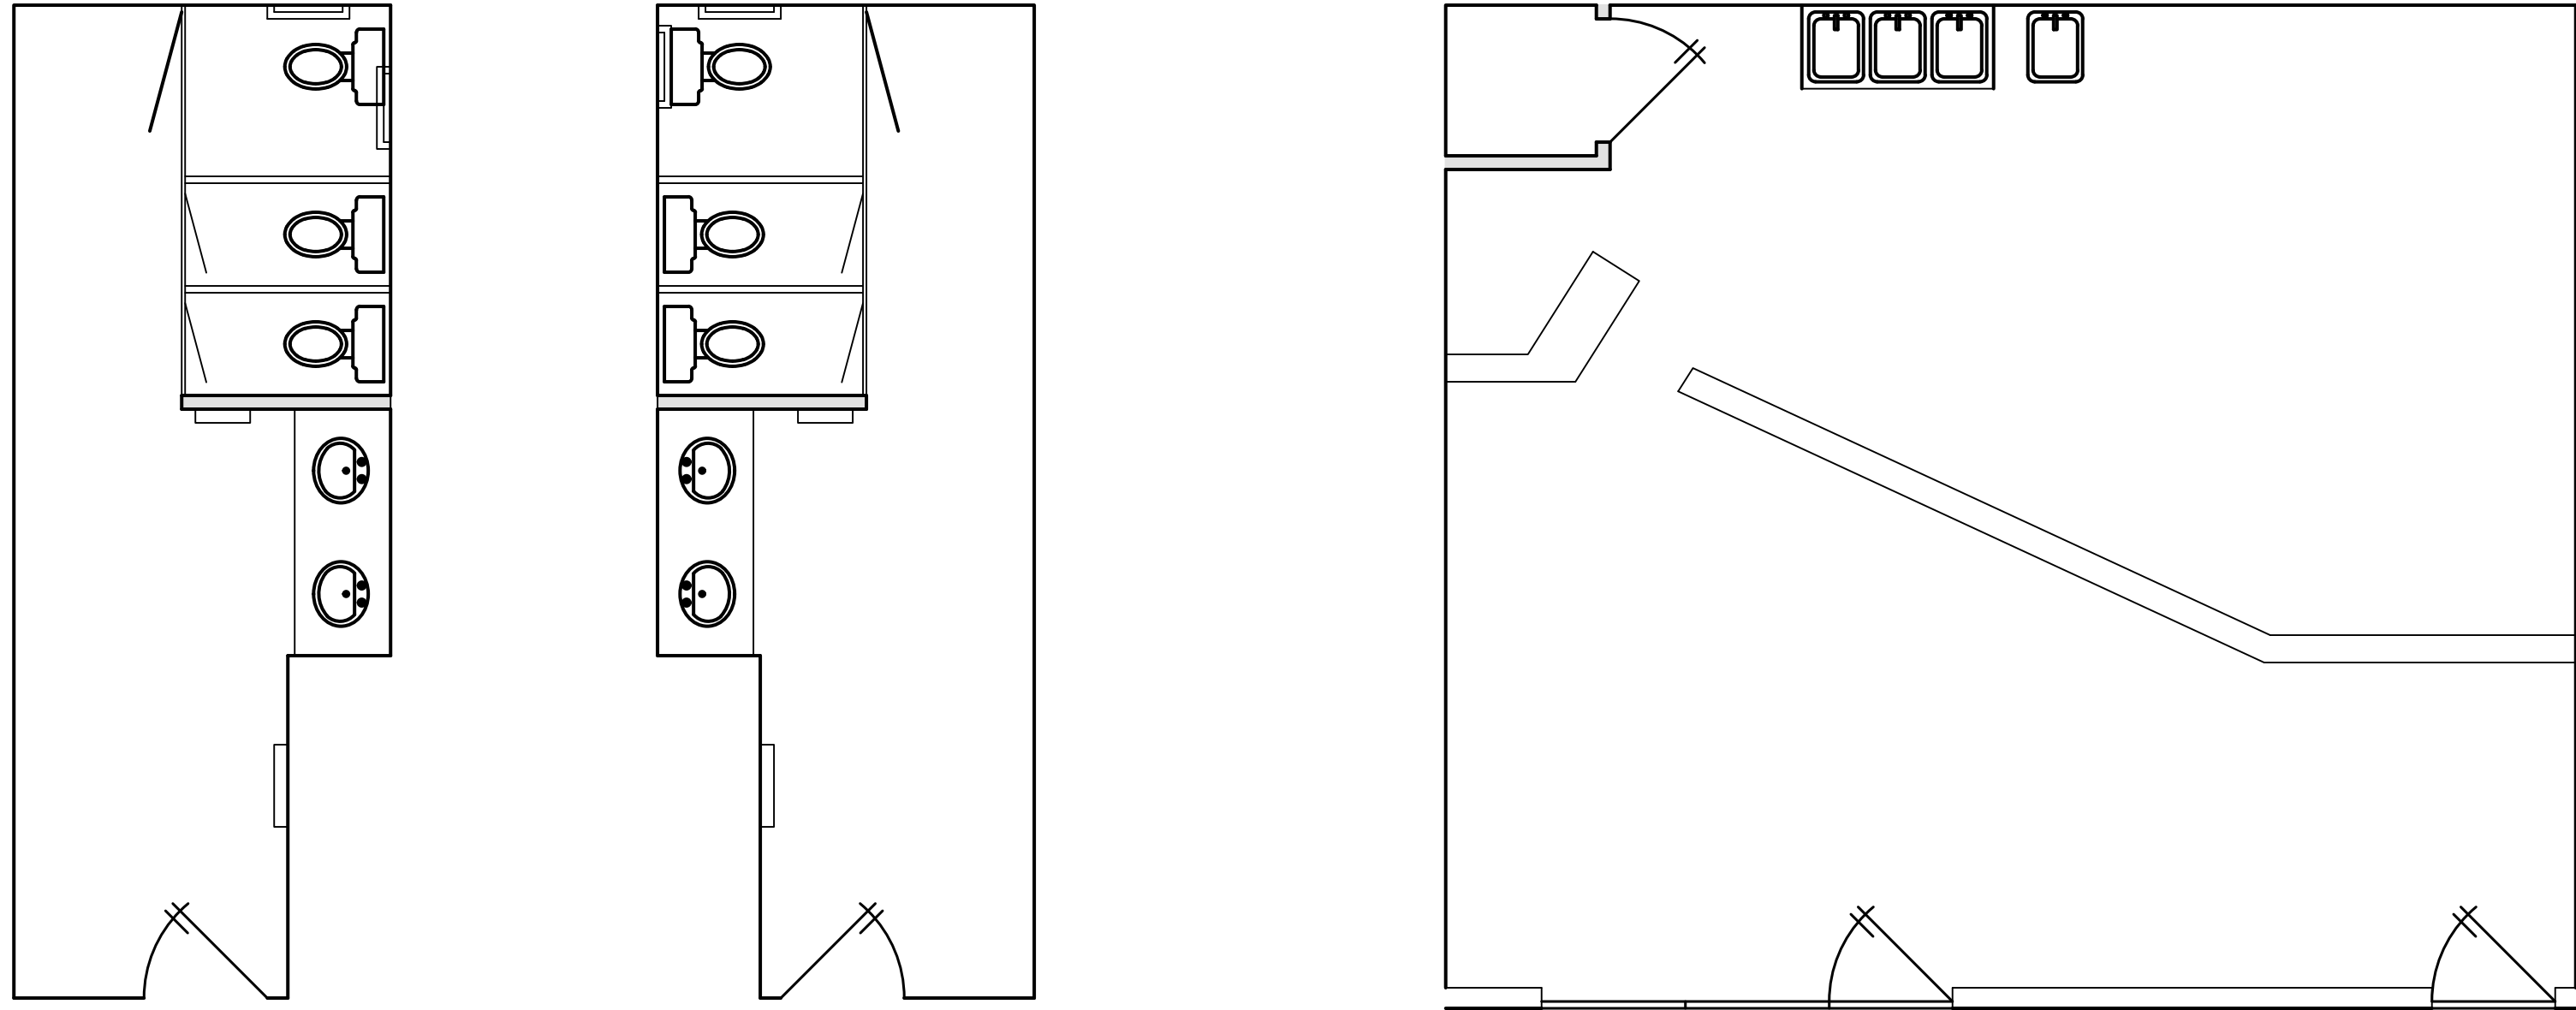

GENERAL FLOOR PLAN NOTES


1. VERIFY ALL EXISTING WALL LOCATIONS. MEASUREMENTS WERE TAKEN 'AS-BUILT.'
2. VERIFY ALL EXISTING DOOR/WINDOW SIZE AND LOCATIONS.
3. VERIFY ALL FLOOR AND CEILING FINISHES.
4. VERIFY EXISTING ELECTRICAL OUTLETS, LIGHTING AND SWITCHES.
5. VERIFY LOCATION OF EXISTING ELECTRICAL PANELS.
6. VERIFY ALL CEILING HEIGHTS.
7. UNLESS OTHERWISE NOTED, ALL DOORS ARE 3' WIDE

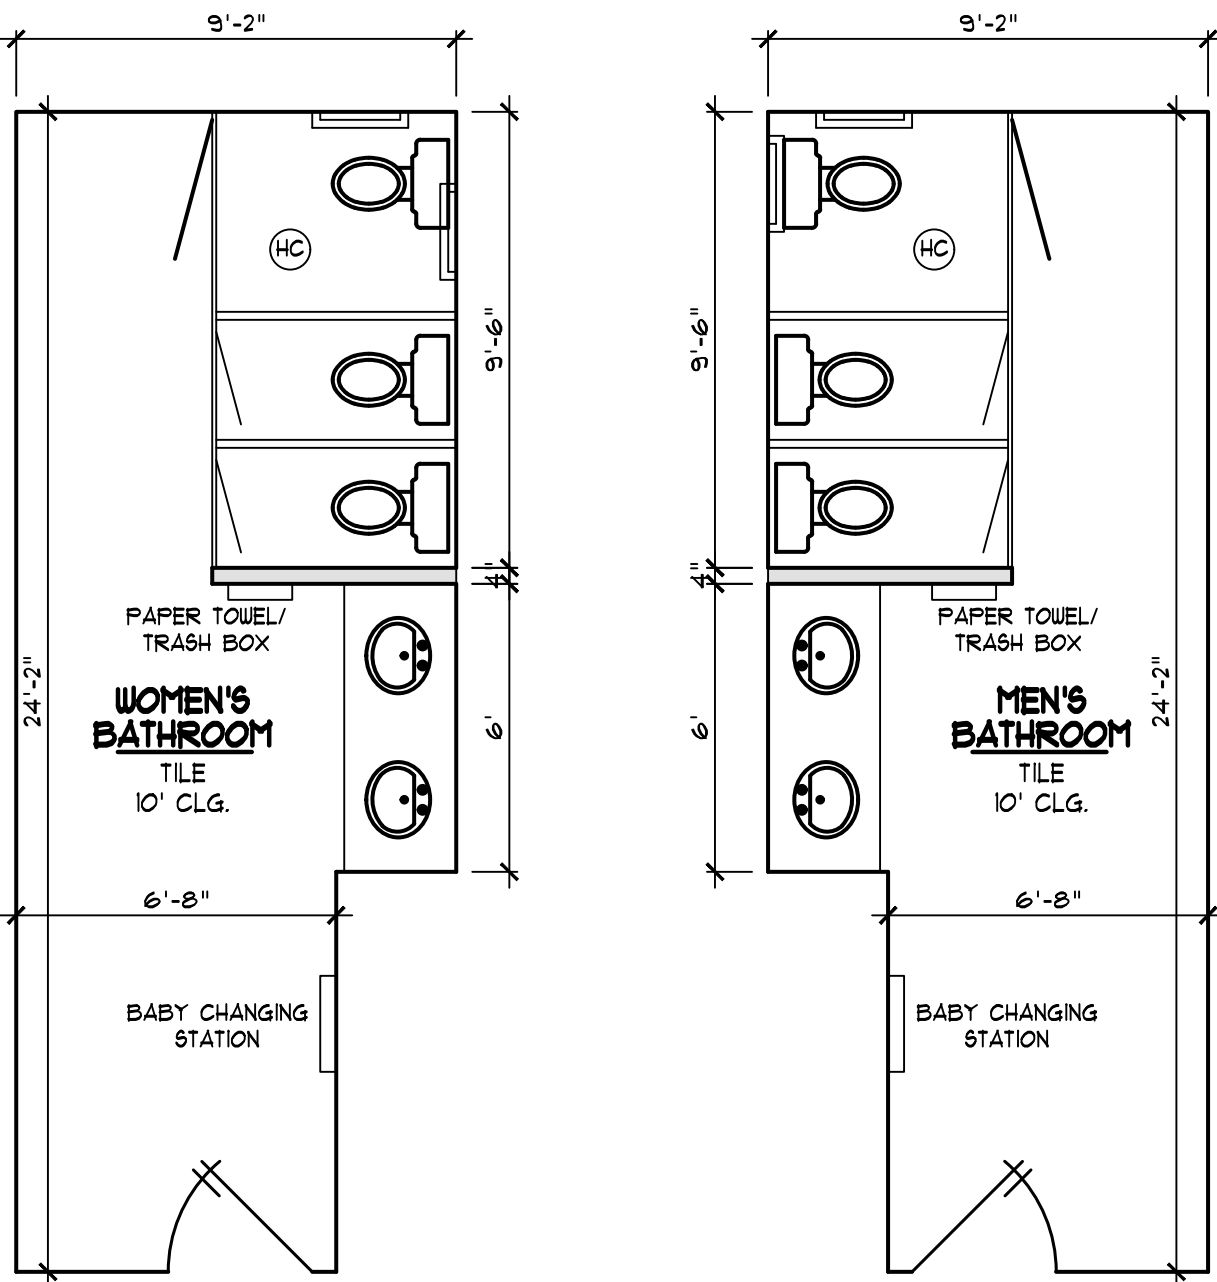

11001 BATHROOMS

SCALE: 1/4"=1'-0"

ESTIMATED 200 TOTAL SQ. FT. AREA
(EACH BATH)

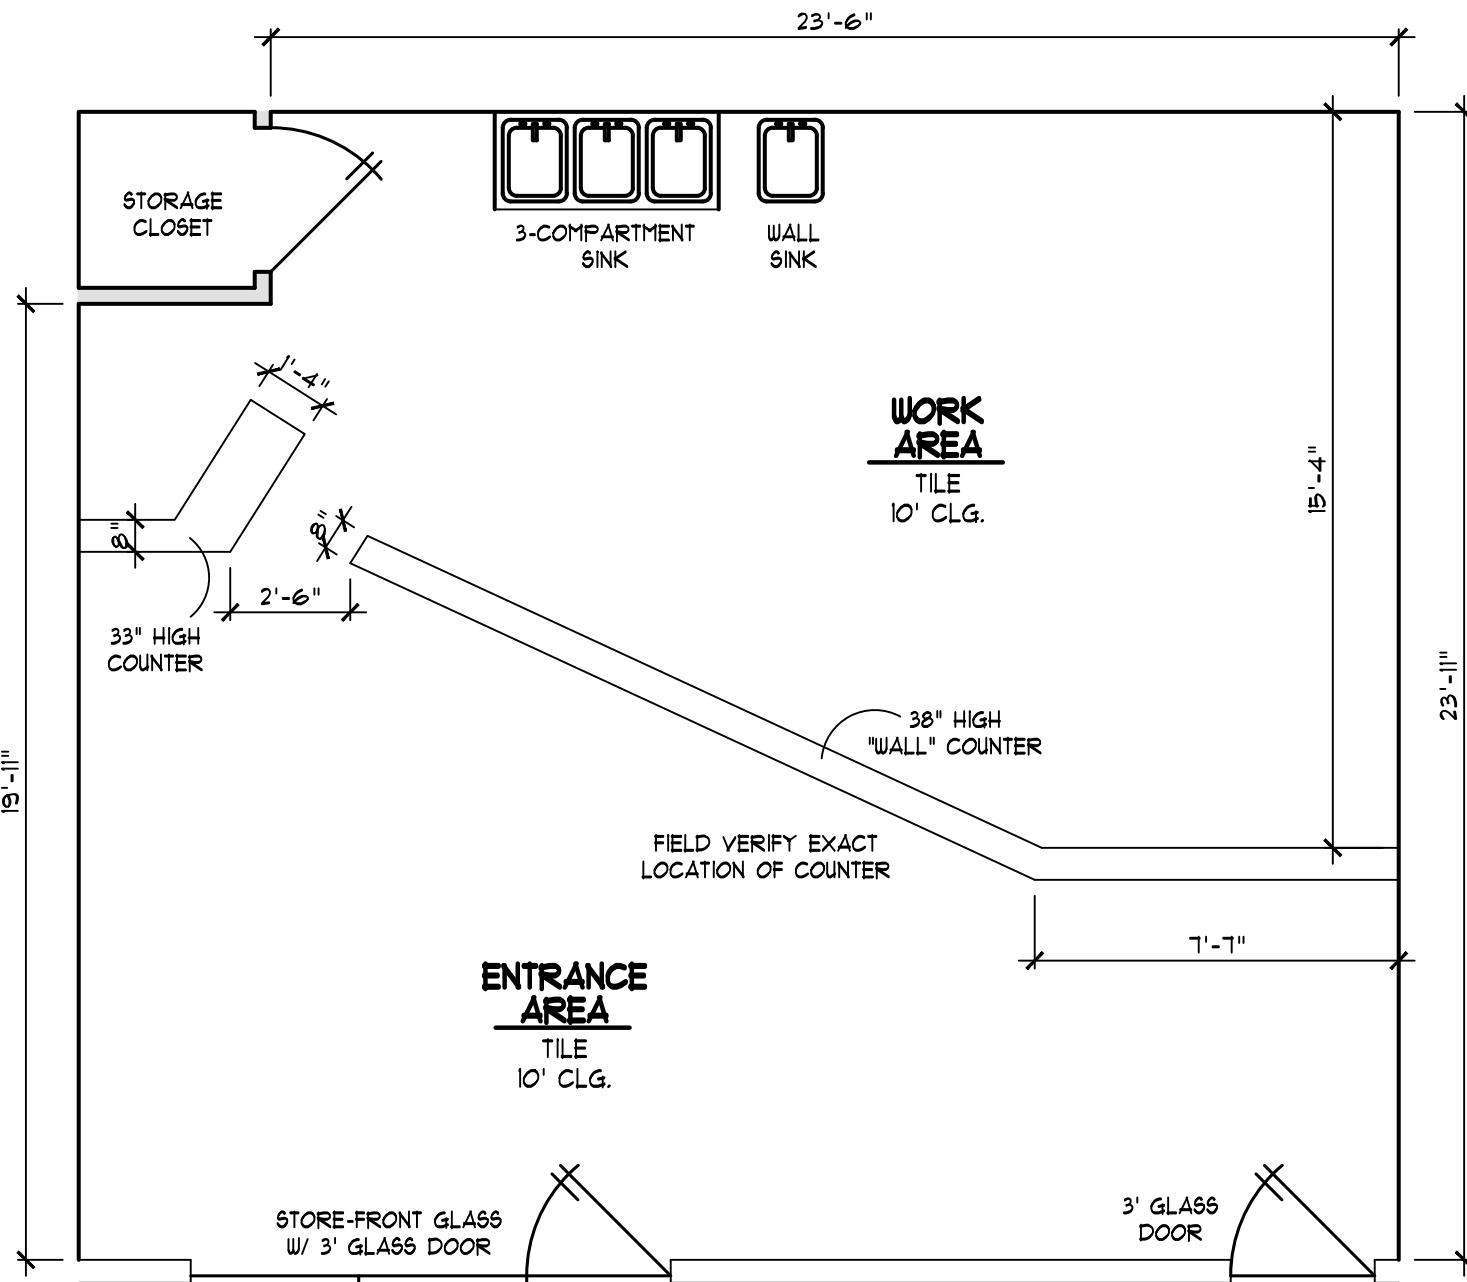

11001 OFFICE SUITE

SCALE: 1/4"=1'-0"

ESTIMATED 650 TOTAL SQ. FT. AREA

CAD Designs
The measurements, dimensions, and other specifications shown on this document are guidelines for construction use only. The actual specifications of the finished structure may vary. This document may not be relied on as a representation of what the completed structure will look like.

CAD DESIGNS

PH. 214-797-2814

D.B. R.R.B. Scale: 1/4" = 1'-0"

Date: 5.15.2026 Rev.: REV DATE

GULFWAY PLAZE
11000 DELANEY ST.
LA MARQUE, TX. 77568

Proj. No.:	Lot:
PXXX	
Job No.:	Blk:
XXXX	
	Sect:

FLOOR 1

GULFWAY PLAZE