

# Farnsworth GROUP

100 WALNUT STREET, SUITE 200  
PEORIA, ILLINOIS 61602  
(309) 689-9888 / info@f-w.com

www.f-w.com  
Engineers | Architects | Surveyors | Scientists

ISSUE:  
# DATE: DESCRIPTION:

**PRELIMINARY**  
NOT FOR CONSTRUCTION

PROJECT:  
Cohen Development

## Westlake Shopping Center

2601 W Lake Ave.  
Peoria, Illinois 61615


DATE: 12/01/2020  
DESIGNED: Designer  
DRAWN: Author  
REVIEWED: Approver

SHEET TITLE:  
**B-1c As-Built**

SHEET NUMBER:

# A1.1

PROJECT NO.: 0171444.00

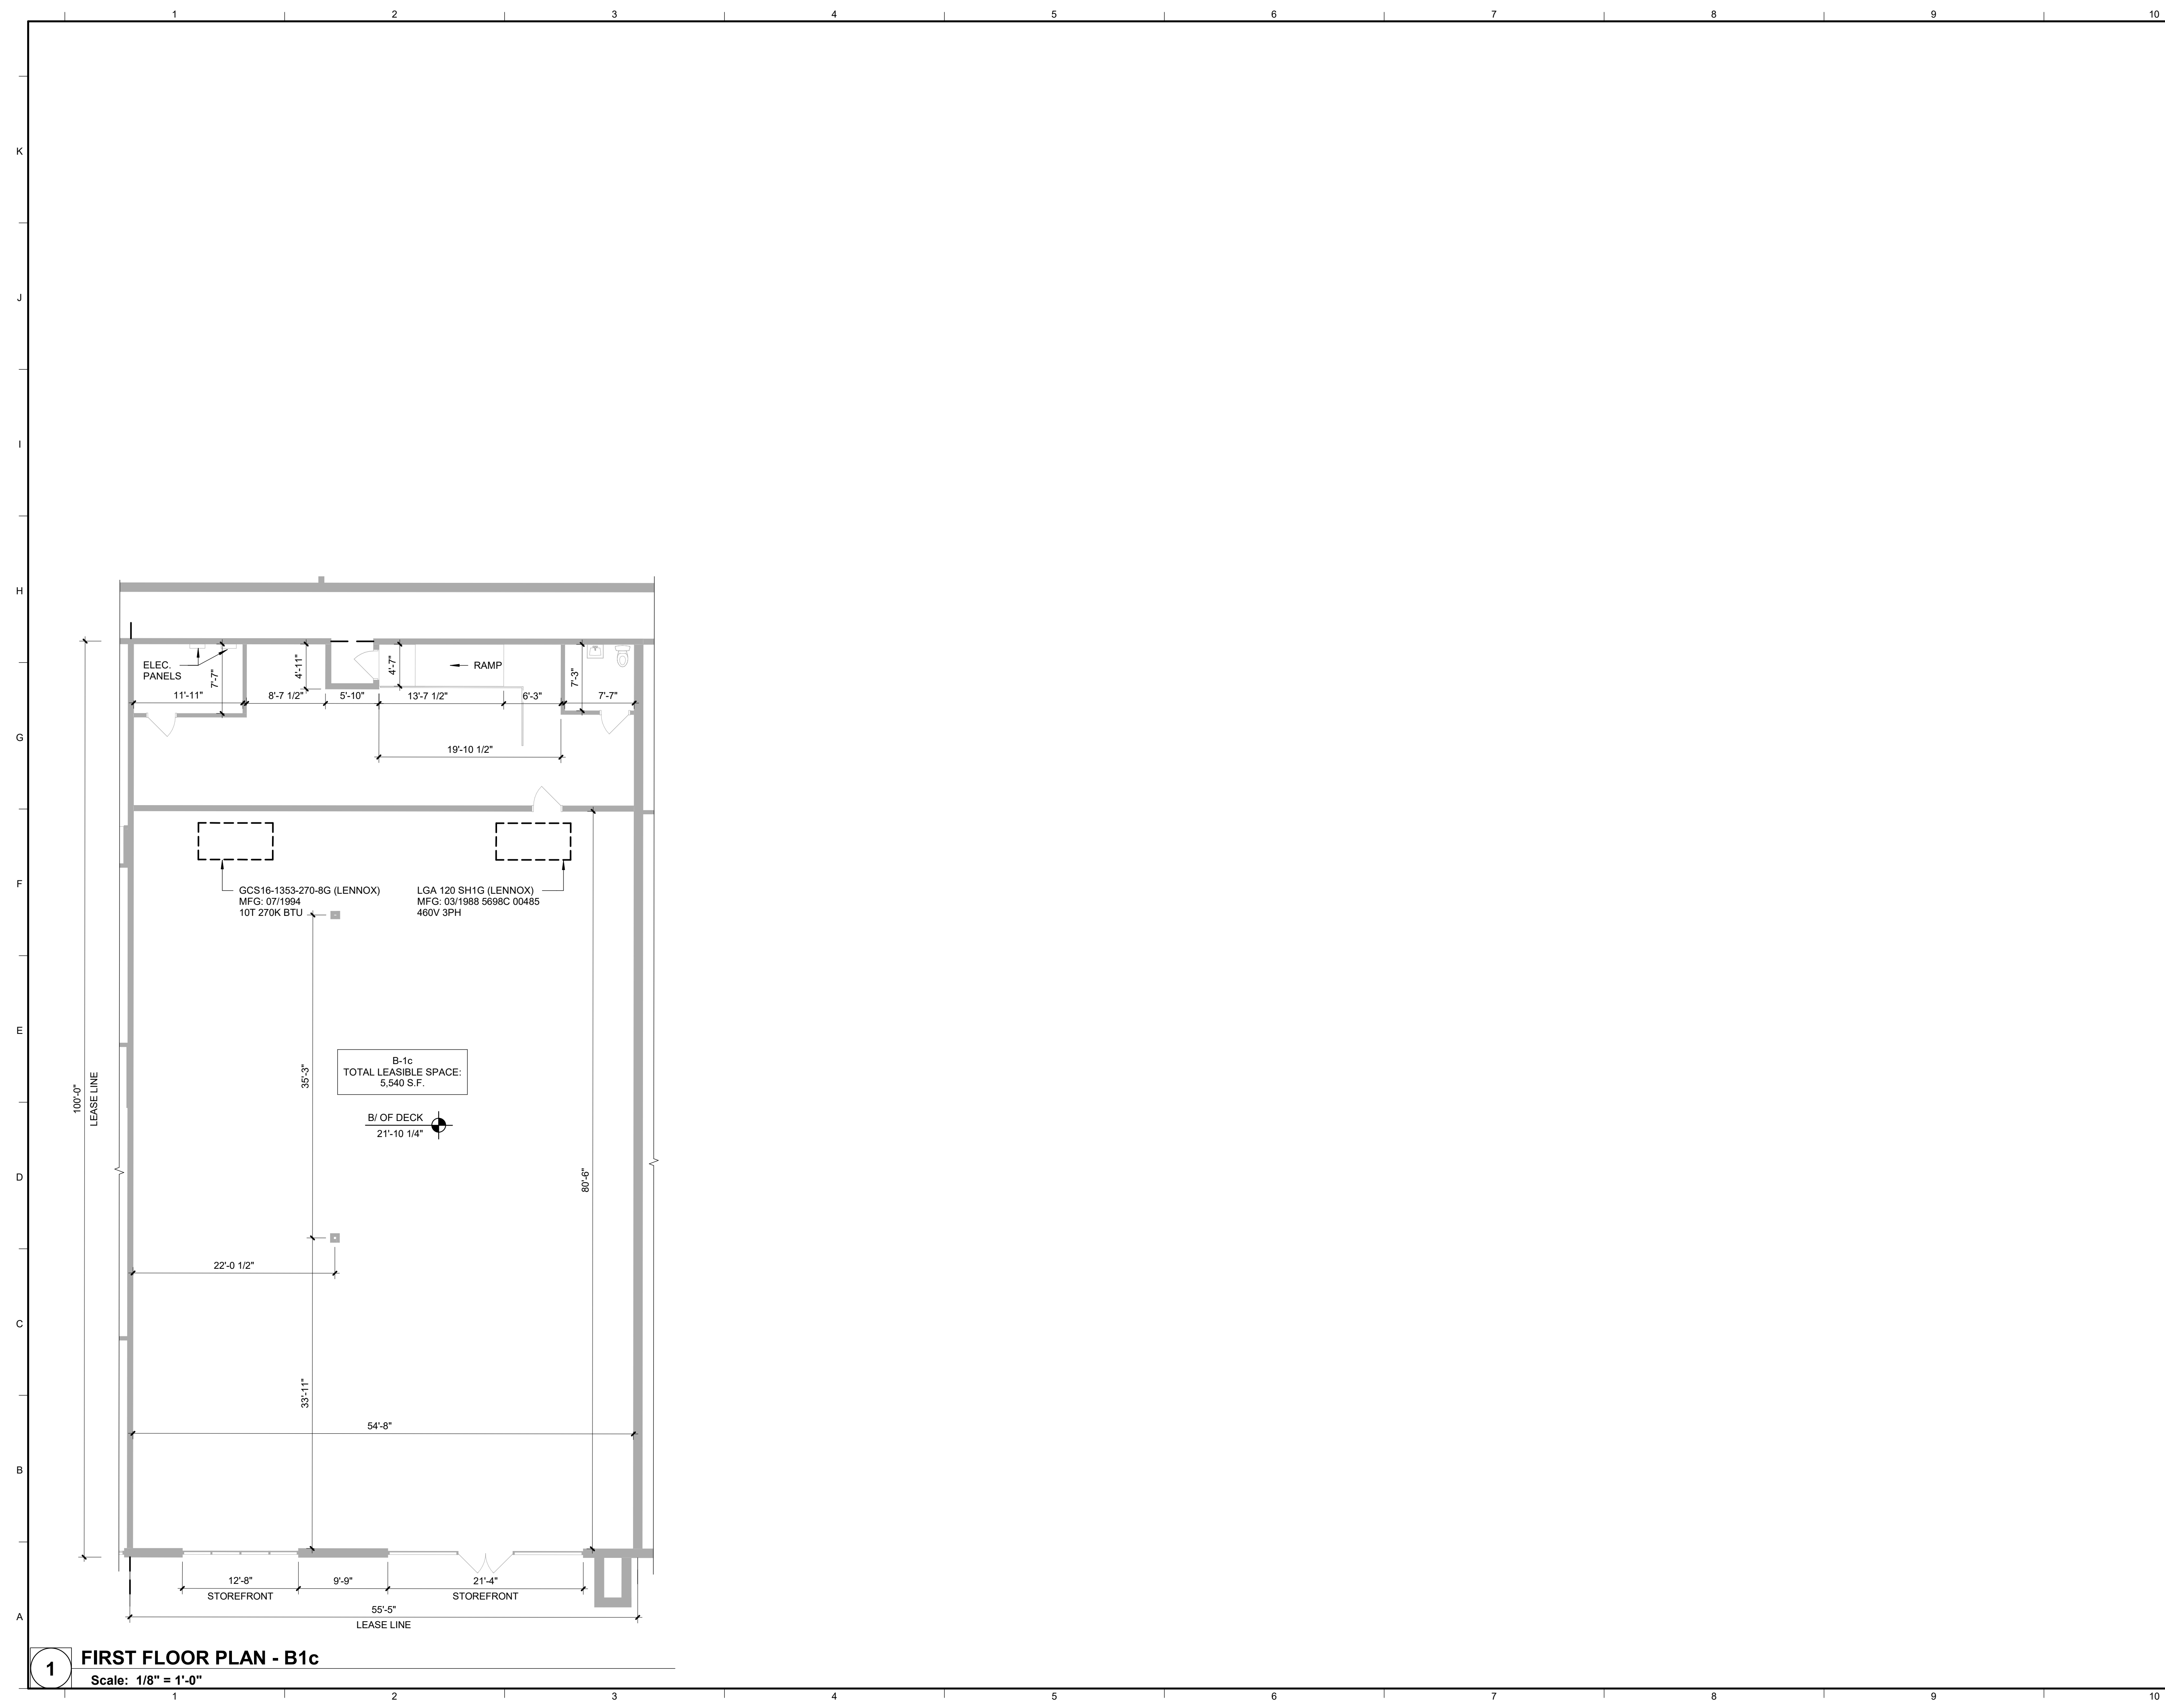

**1 FIRST FLOOR PLAN - B1c**  
Scale: 1/8" = 1'-0"

12/1/2020 4:50:41 PM