


AREA = 6032

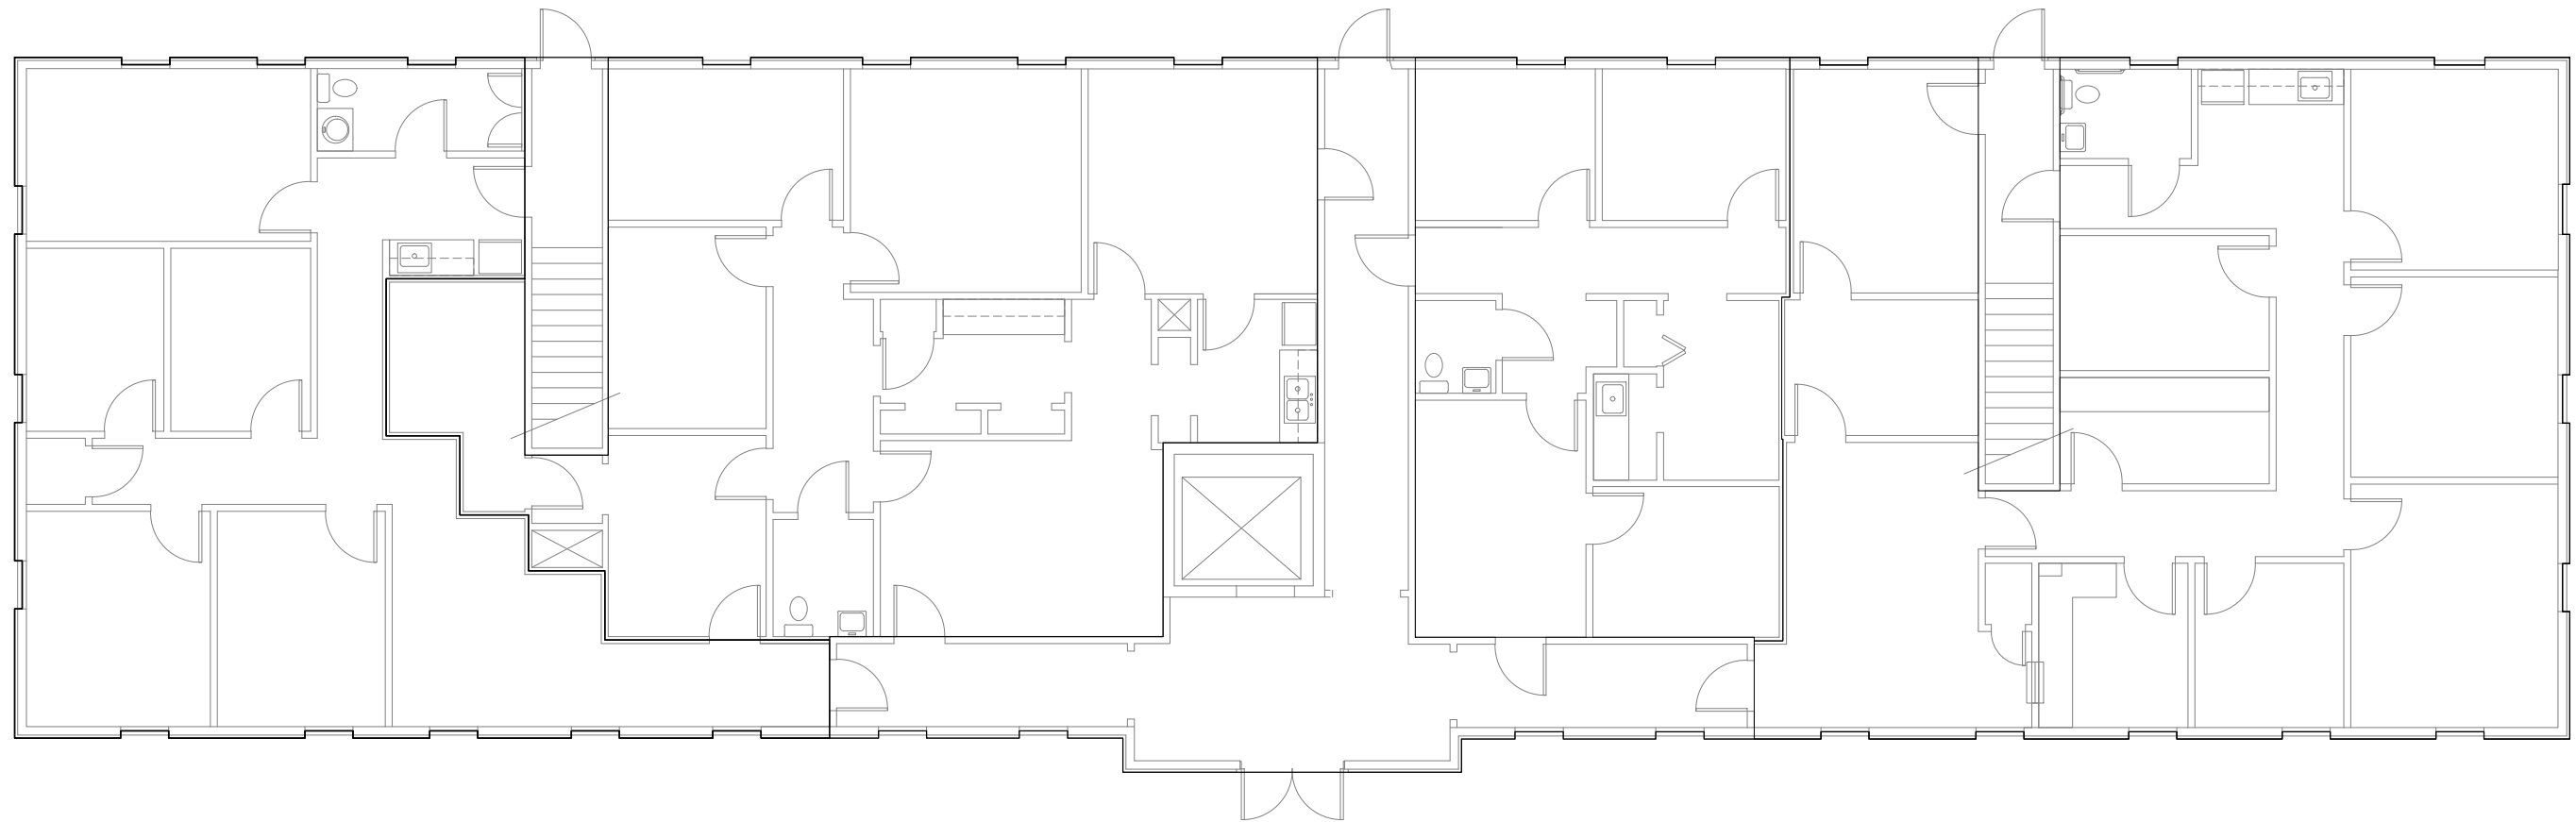


SUITE 1 = 1220

SUITE 2 = 1445

SUITE 4 = 742

SUITE 4 = 1727

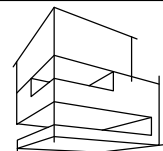

SORCI DESIGN GROUP
interior commercial architecture

PROJECT: HAZEL PATH WREN BUILDING 1ST FLOOR
LOCATION: 109 HAZEL PATH HENDERSONVILLE, TN

RE: AS-BUILT
SCALE: NOT TO SCALE

DATE: 05/21/2024

JOB #: 11968-000