


GRAYMARK OFFICE BUILDING

16801 Addison Road, Addison, Texas

SUITE 405
3,098 RSF

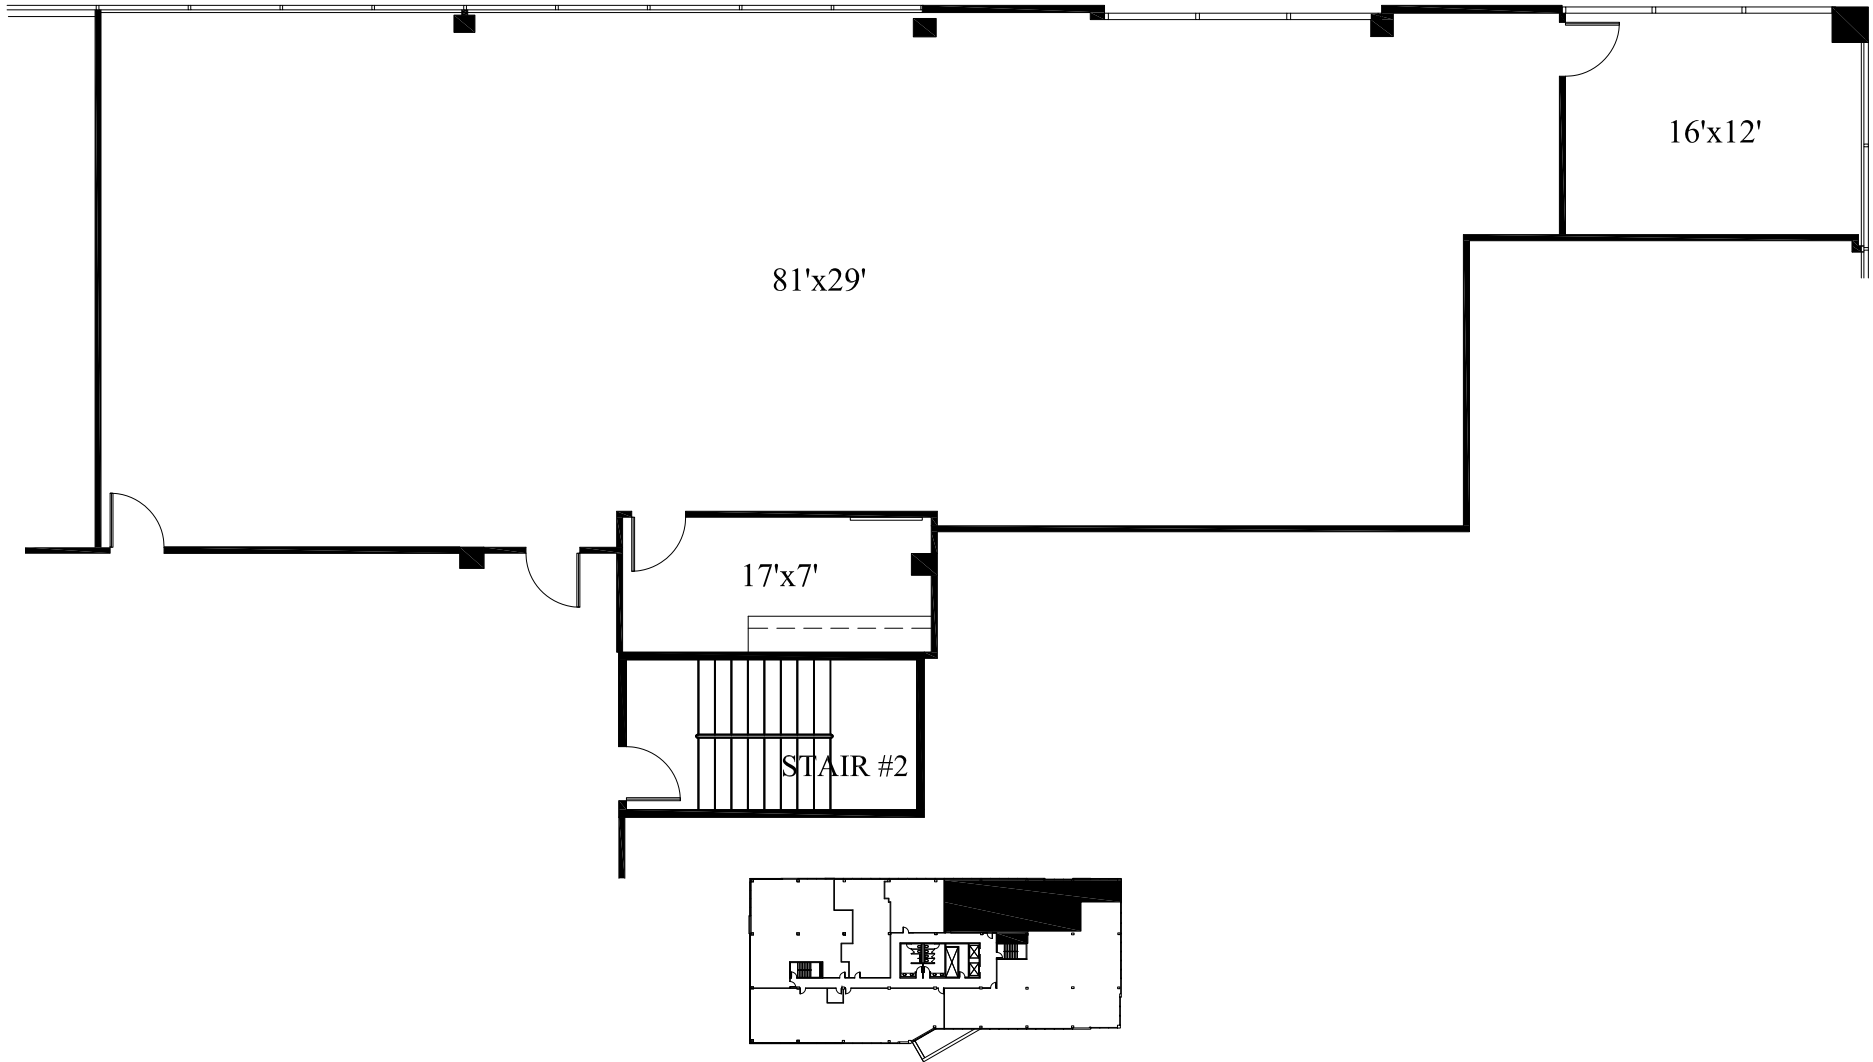

Scale: 3/32"=1'-0"

All dimensions and square footages are approximate.

January 5, 2022

