
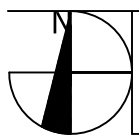


# 212 West Superstition Boulevard

Apache Junction . Arizona

**Suite 103 - 1,767 SF**

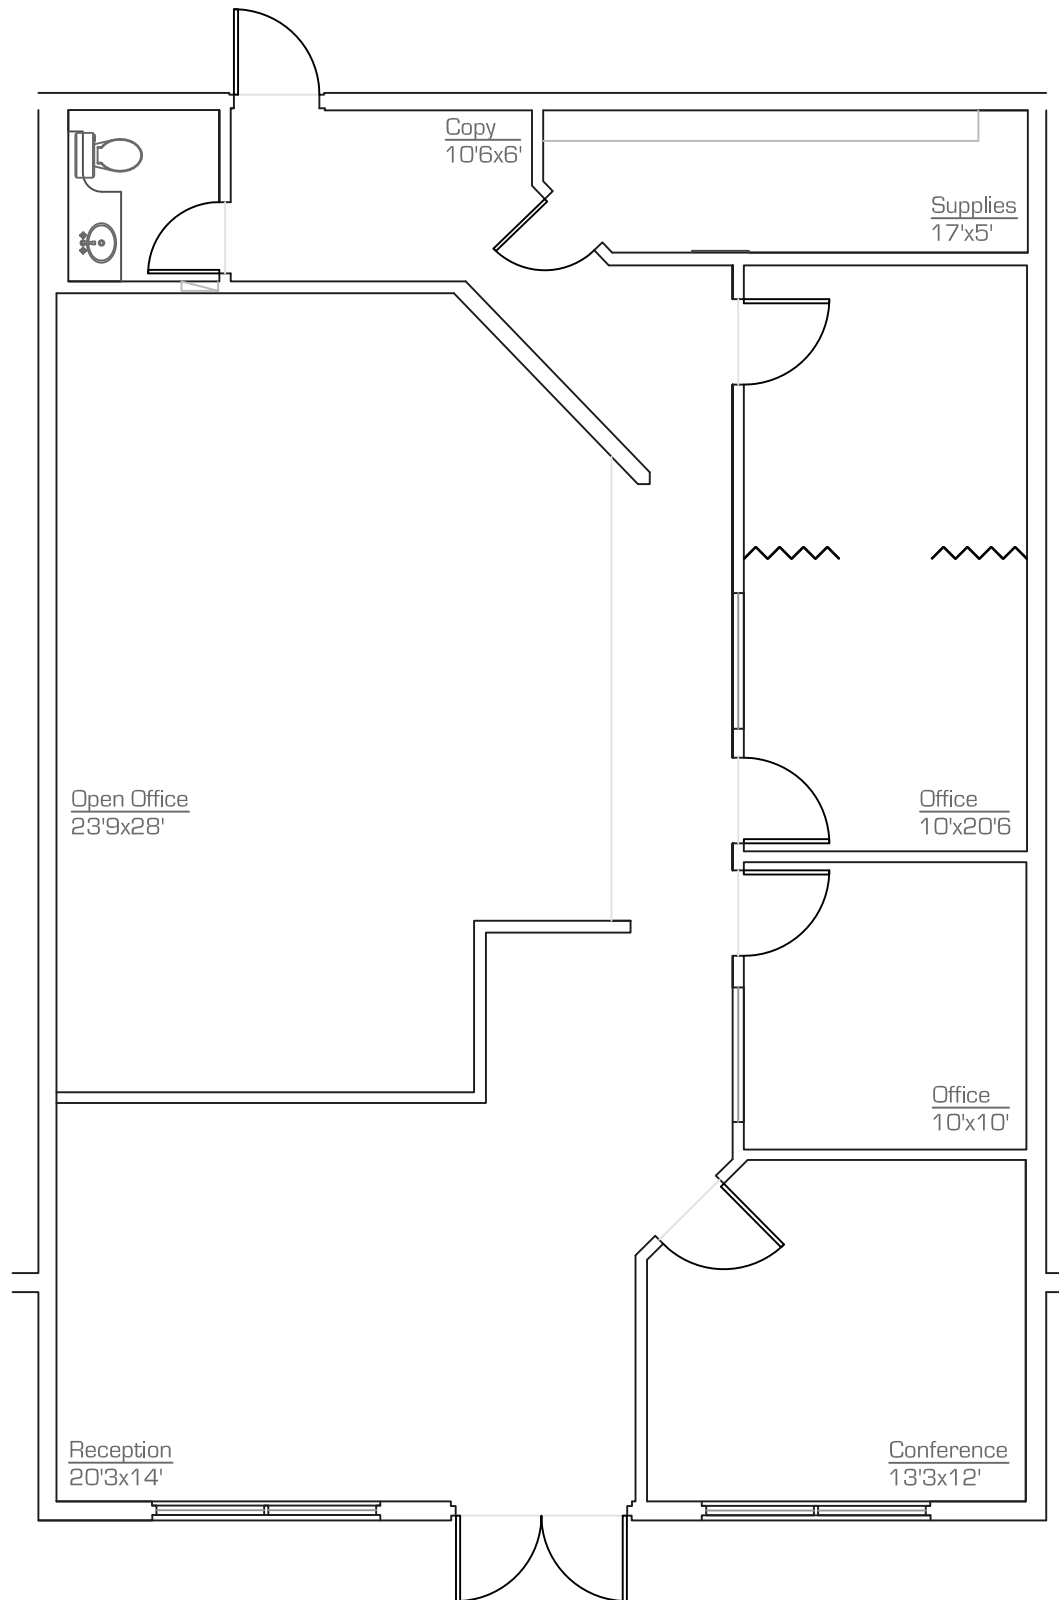

**As-Built**

scale: nts

15.June.2017

\*All dimensions are approximate at  $\pm 3"$

\*All information is of general nature

precision**DIMENSIONS**

as-built & design  
**602. 790. 6412**

