


**SUITE  
450**

EXECUTIVE  
CENTER II  
4TH FLOOR

08.30.X222


AS-BUILT  
PLAN

**AS.4**

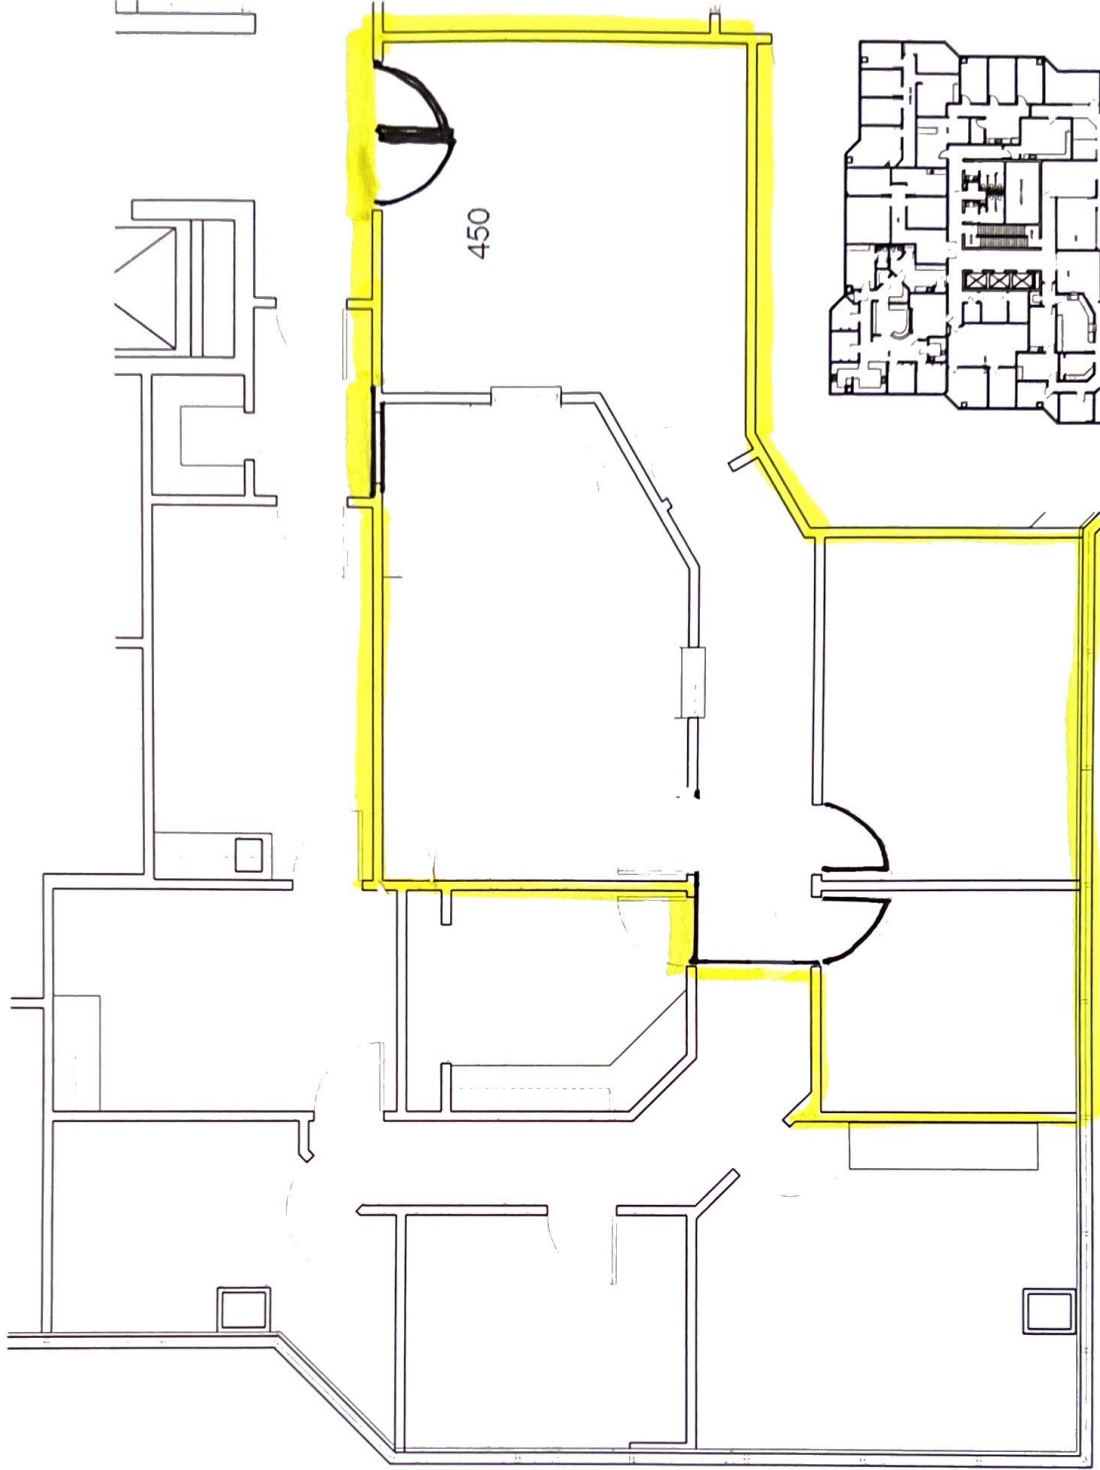

SUITE 450  
AVAILABLE  
2371.48 RSF

**A FLOOR PLAN** NORTH  
SCALE: N.T.S.

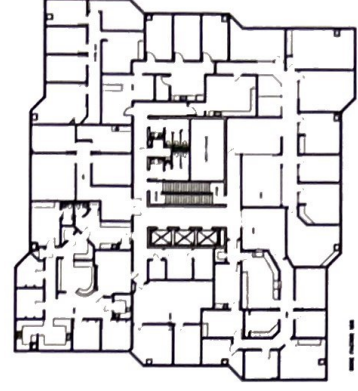

**B KEY PLAN** NORTH  
SCALE: N.T.S.