


TOTAL SF AVAILABLE -7,233 SF


OFFICE - 3,078 SF

WAREHOUSE - 4,155 SF

[Click to access 3D model](#)

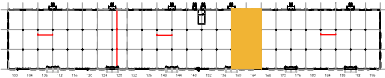

Key Plan

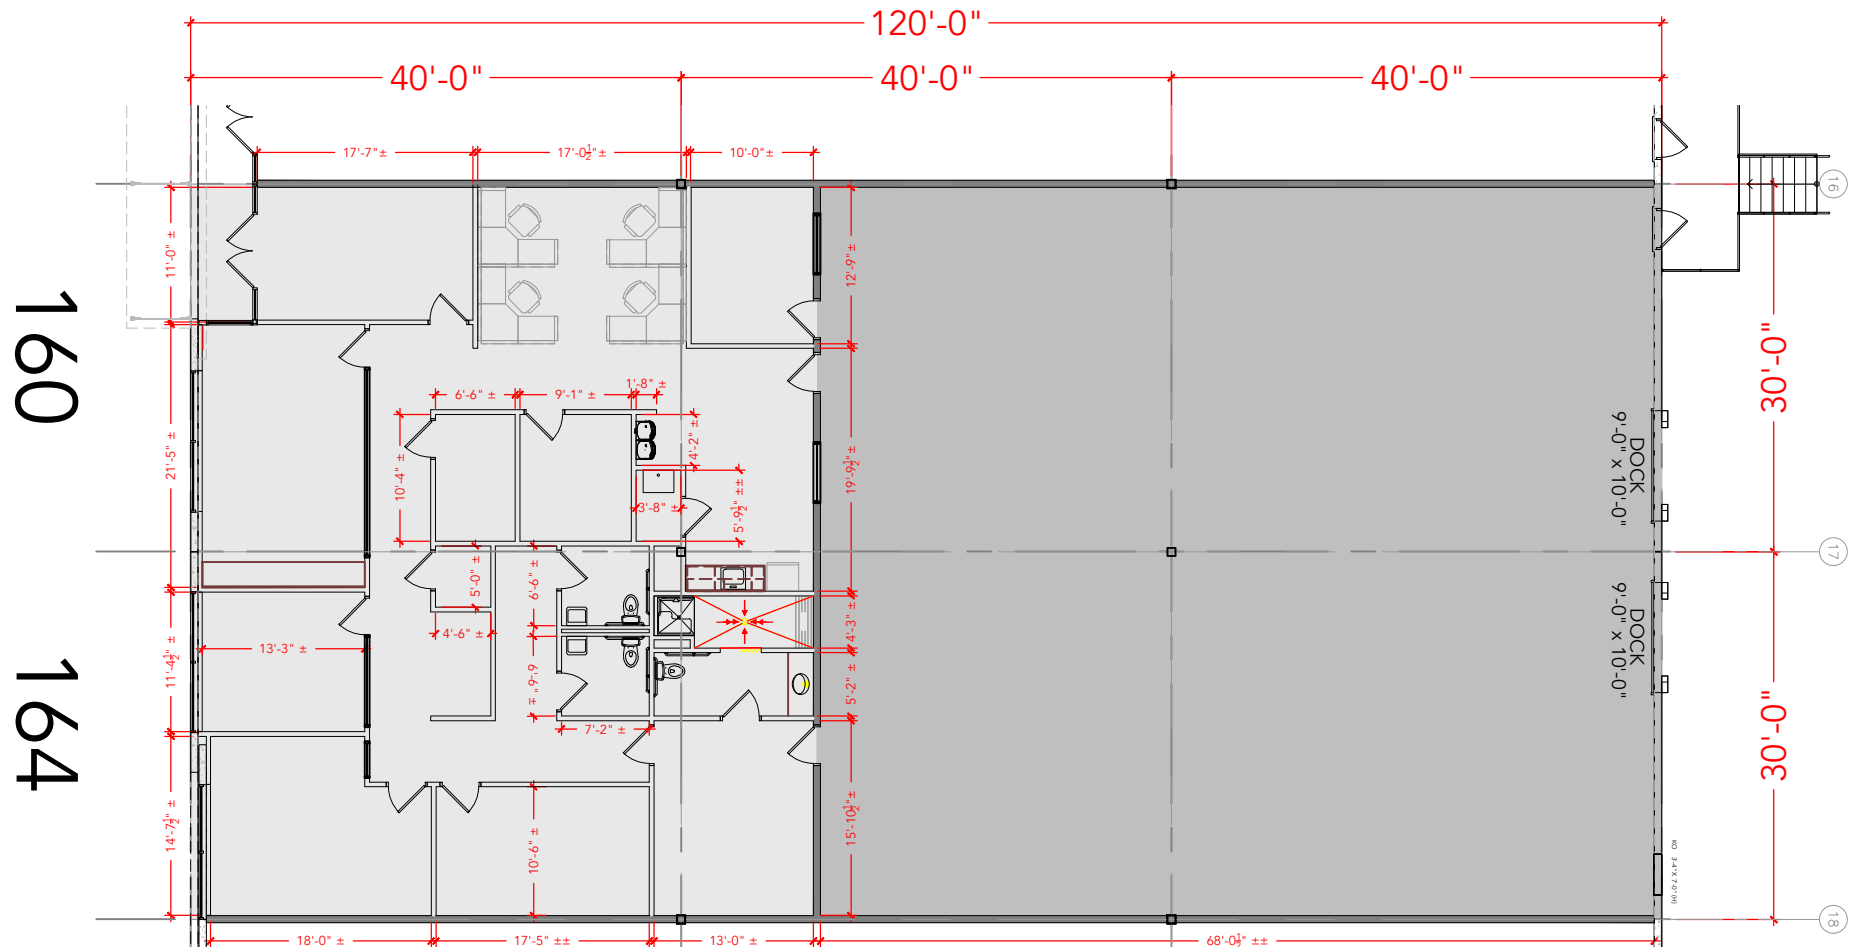

Floor Plan