


3028 Dolores

Site Plan

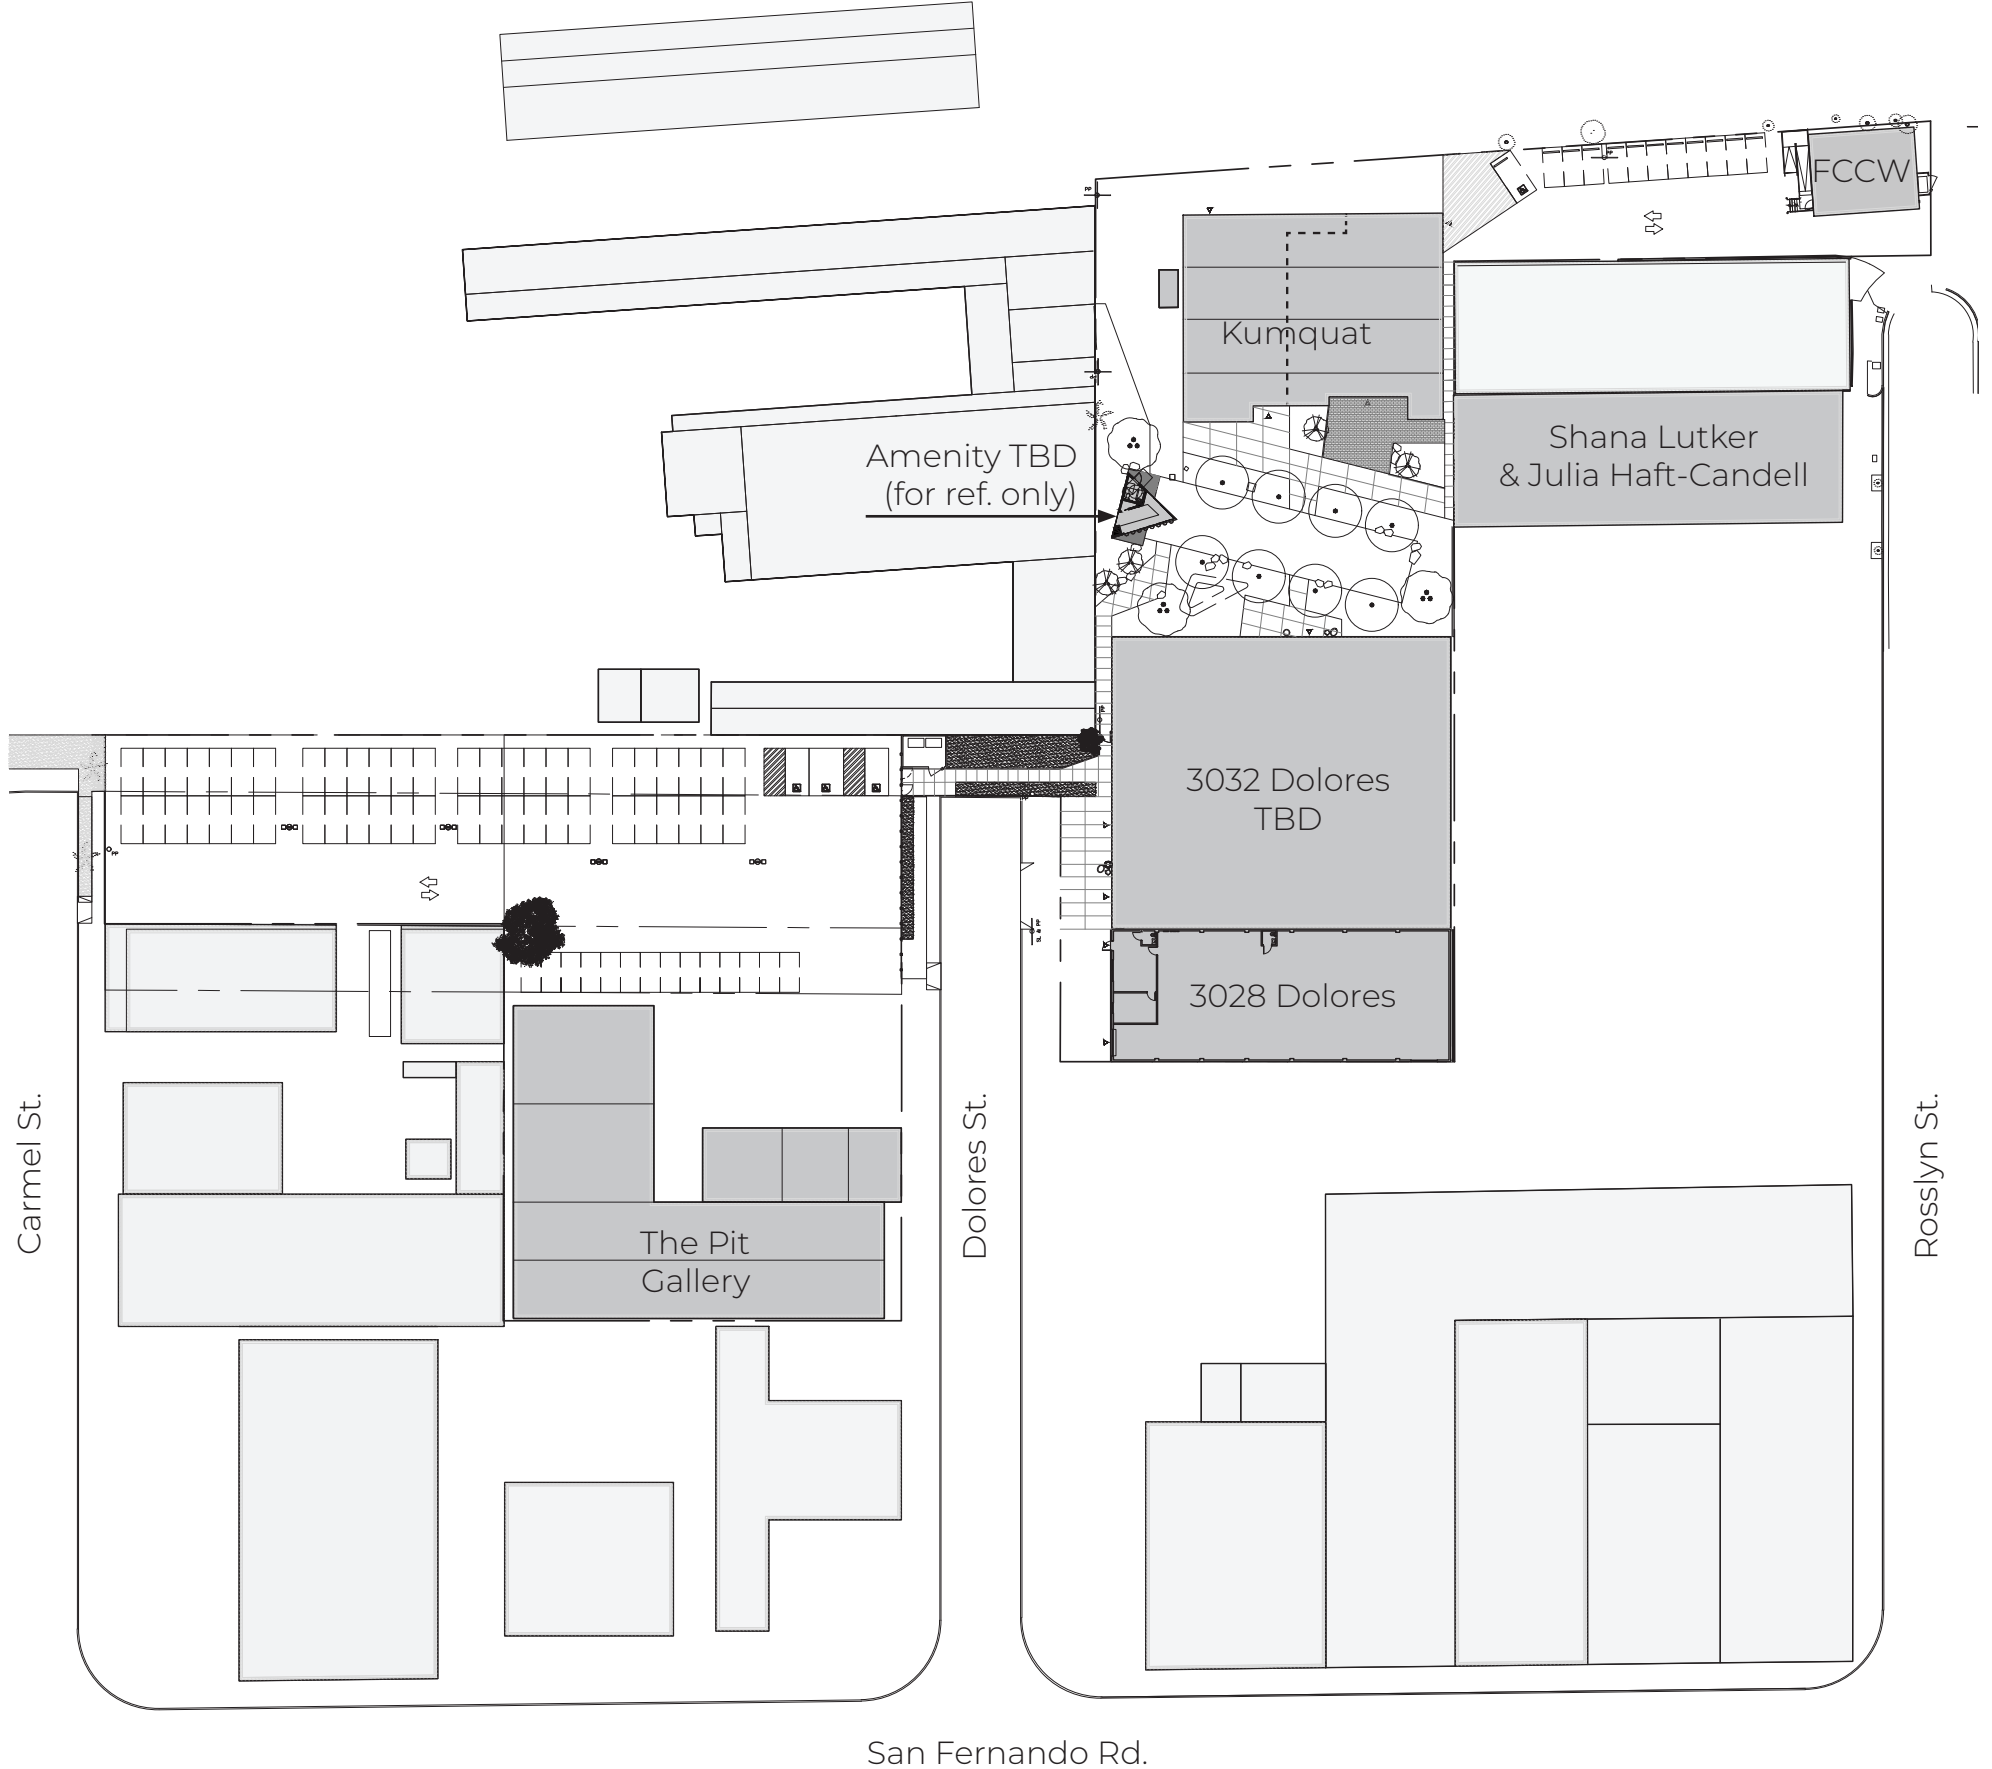


Dolores-Rosslyn Creative Campus
3028 Dolores
Los Angeles, CA 90065
August 15, 2023



3028 Dolores

Existing Plan

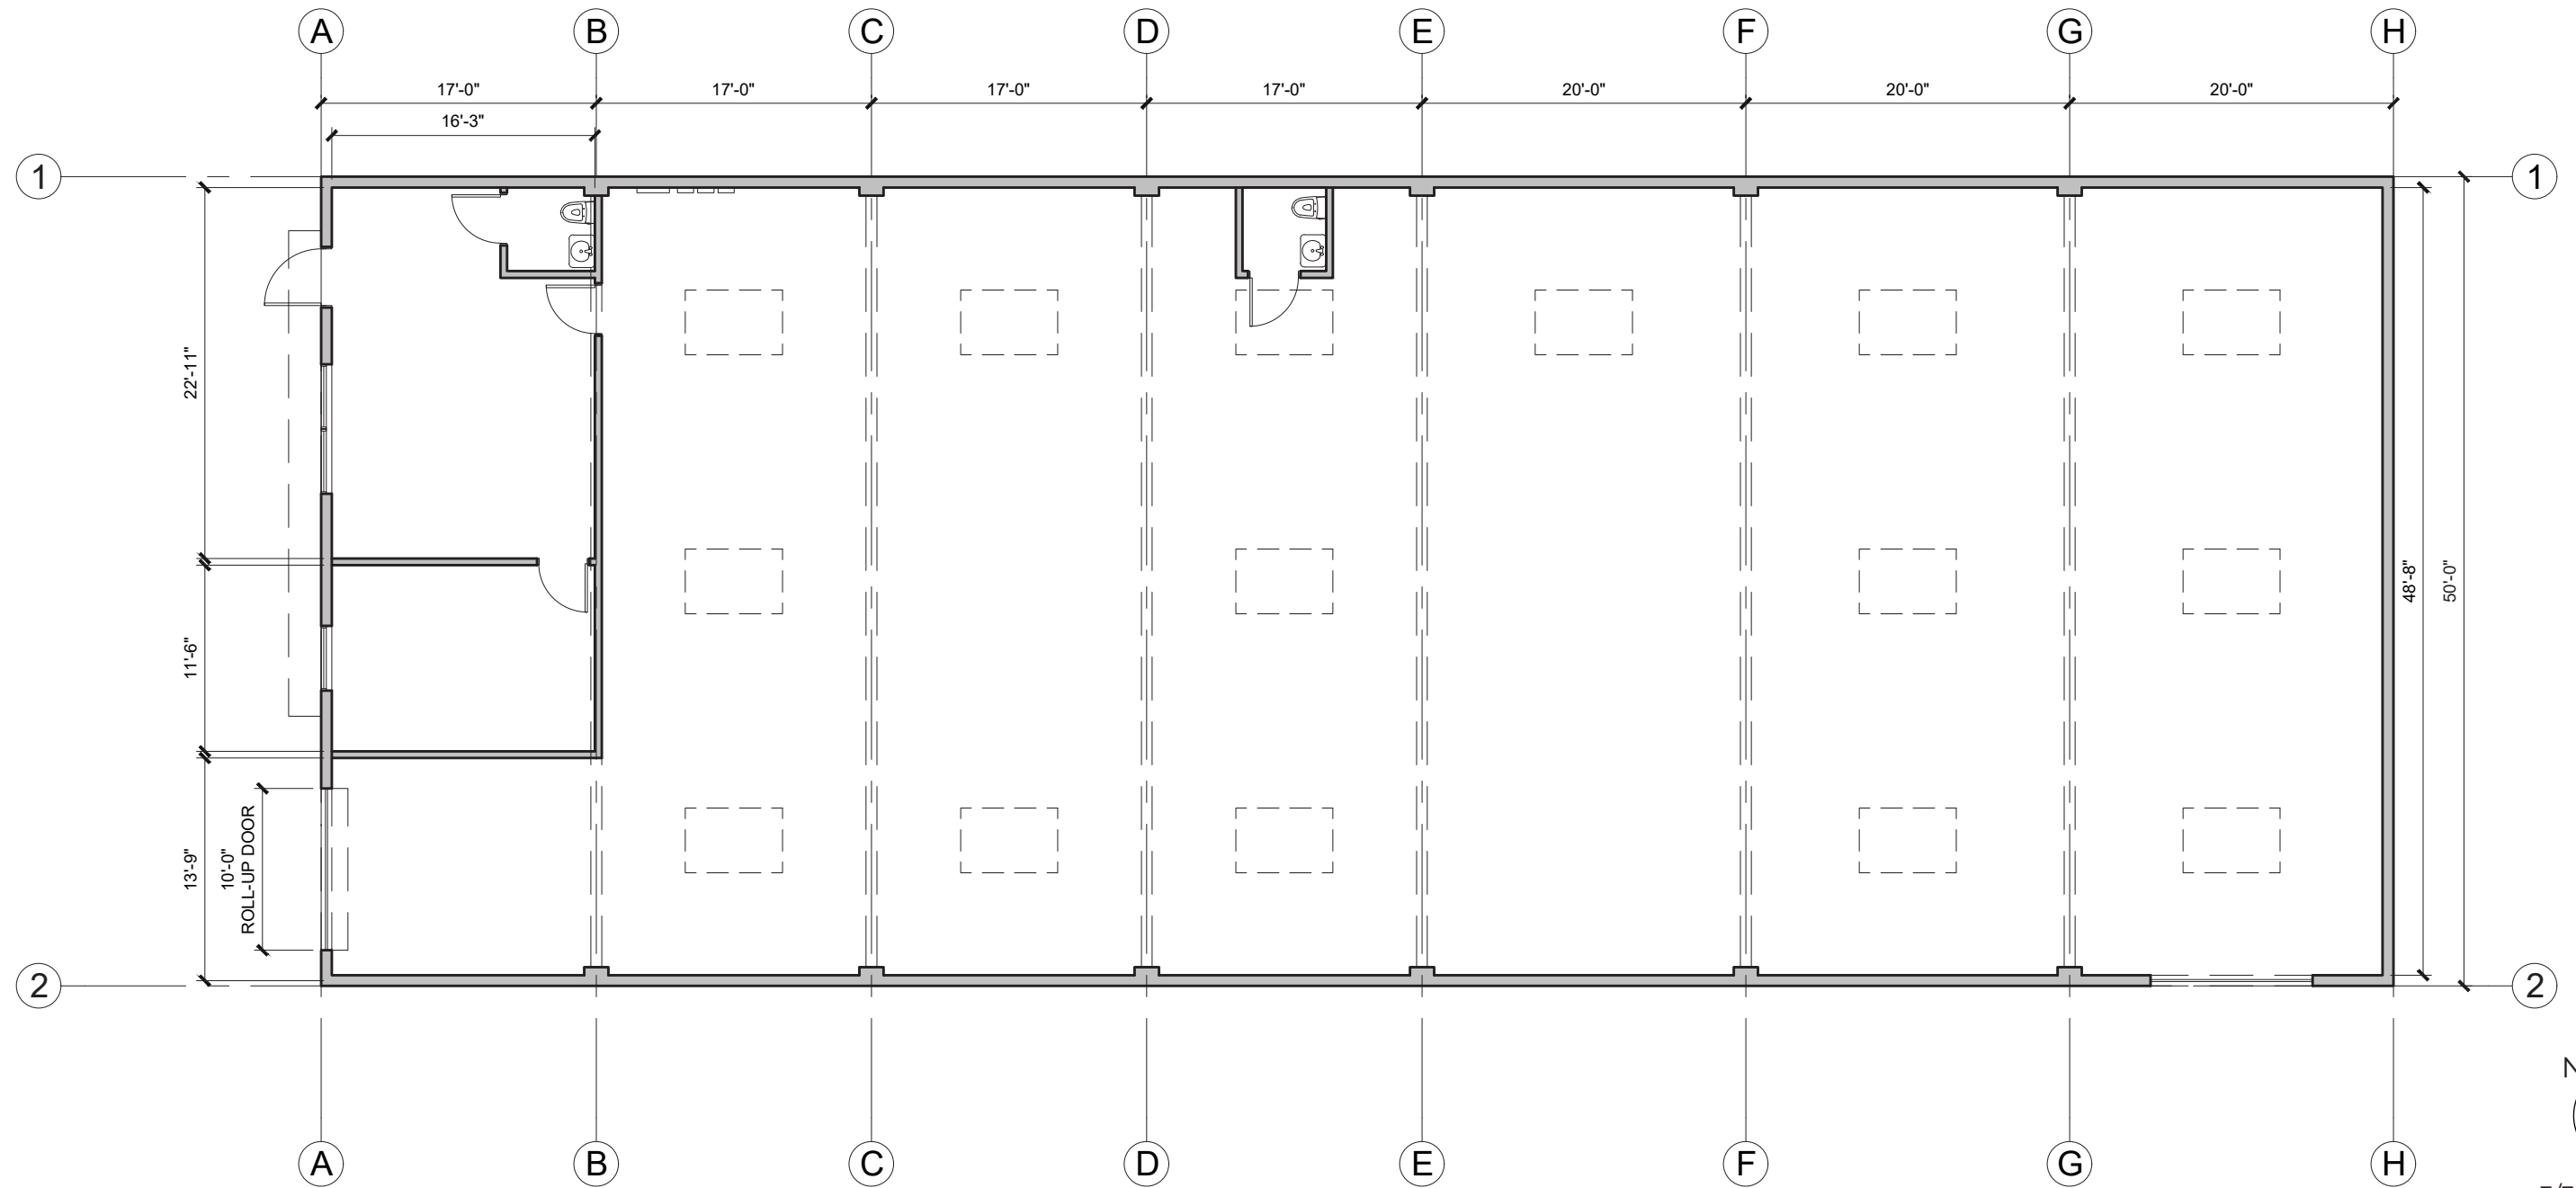


Dolores-Rosslyn Creative Campus
3028 Dolores
Los Angeles, CA 90065
August 15, 2023

J.K.&Co.

3028 Dolores

Dolores Storefront

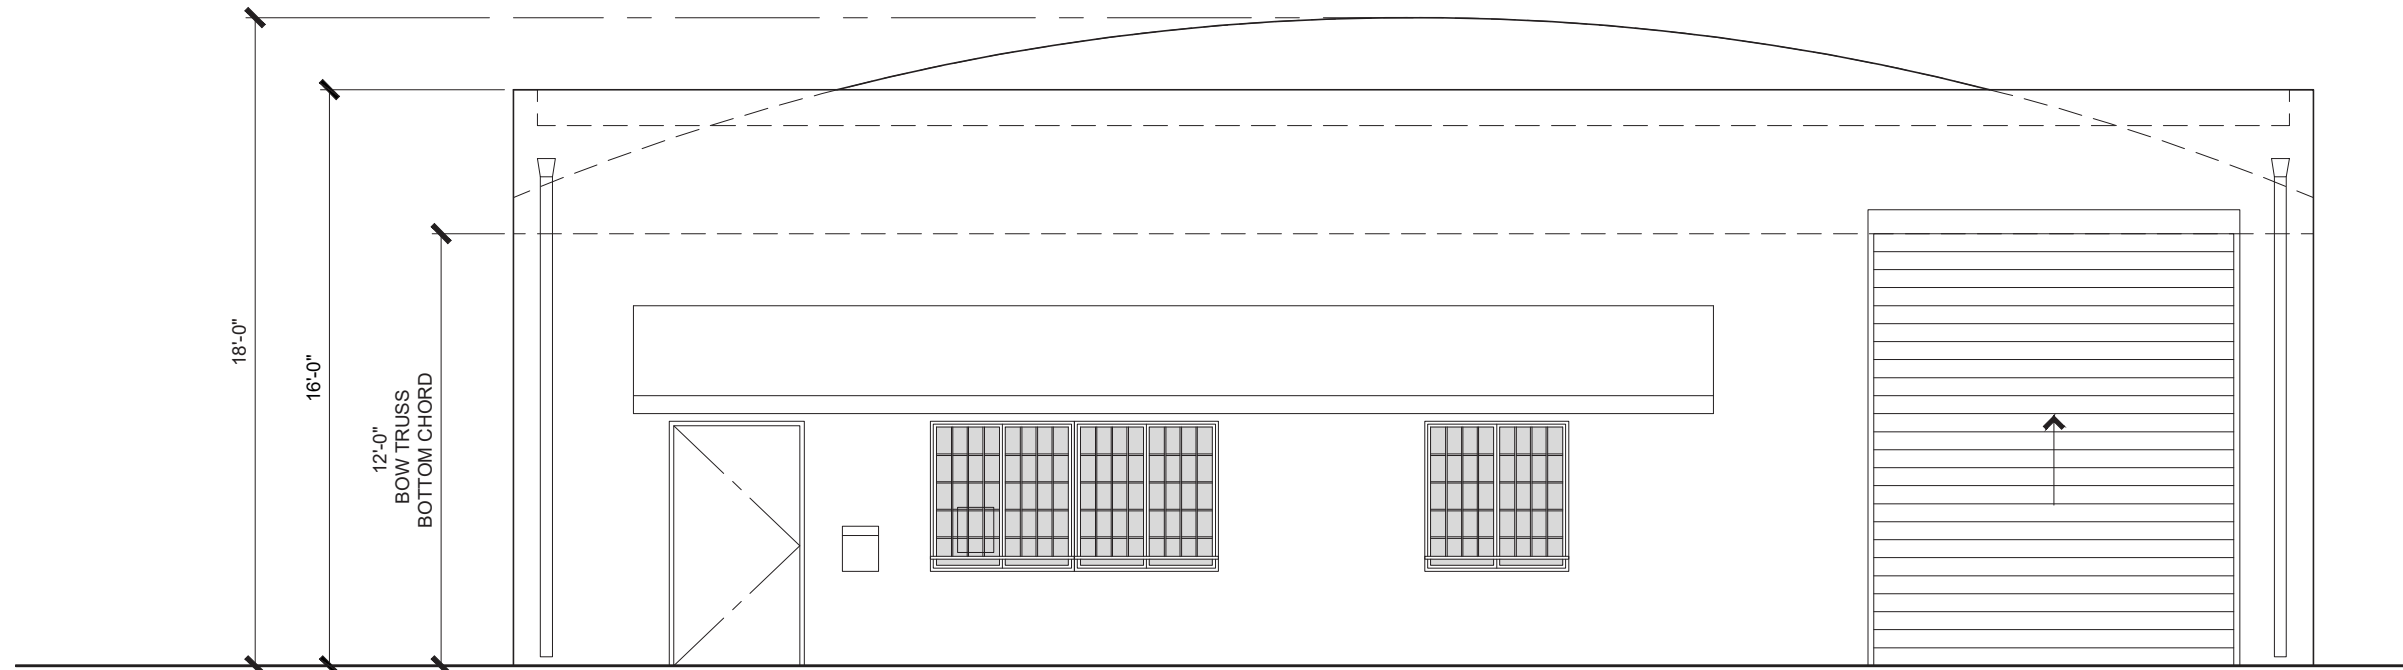

Dolores-Rosslyn Creative Campus
3028 Dolores
Los Angeles, CA 90065
August 15, 2023

J.K.&Co.