

AHWATUKEE
FOOTHILLS
HEALTH CENTER

4545 E CHANDLER BOULEVARD, PHOENIX, AZ 85050


Floor 03

Suite 300

AS-BUILT

3,843 SF

AVAILABLE

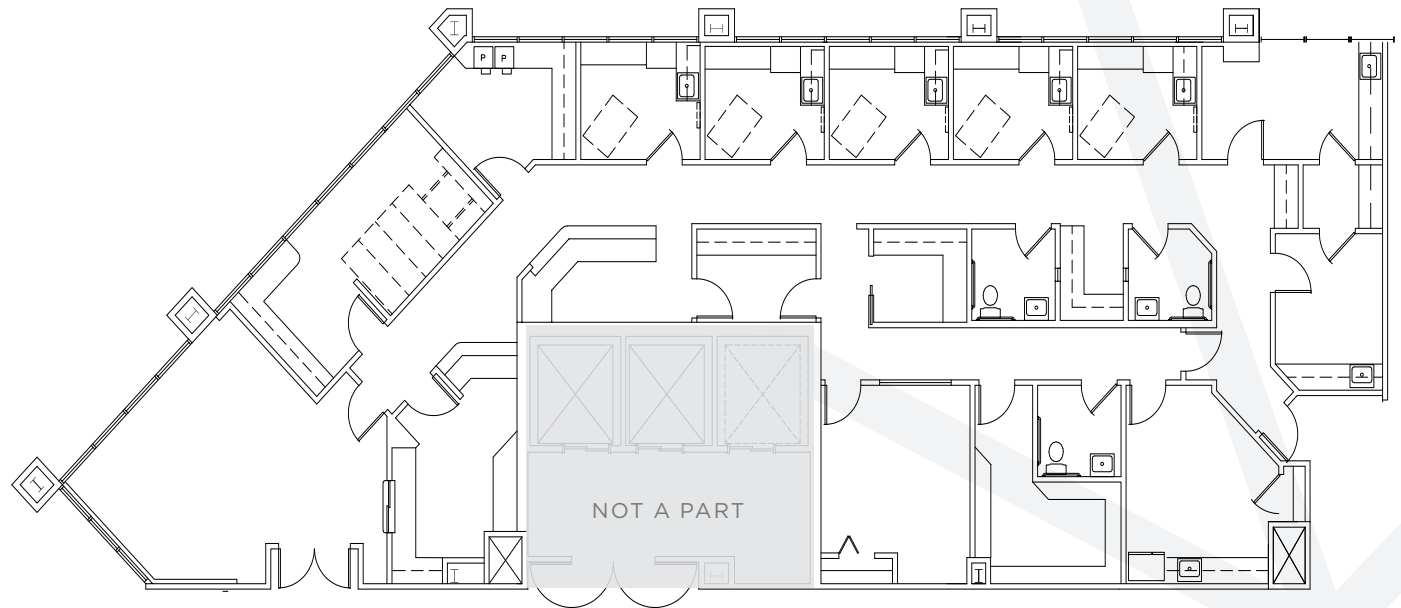

RACHAEL THOMPSON
Senior Vice President
602.513.5122
rachael.thompson@kidder.com

PERRY GABUZZI, CCIM
Executive Vice President
602.513.5116
perry.gabuzzi@kidder.com