


OFFICE/WAREHOUSE FLOOR PLAN

SCALE: 1/8" = 1'-0"

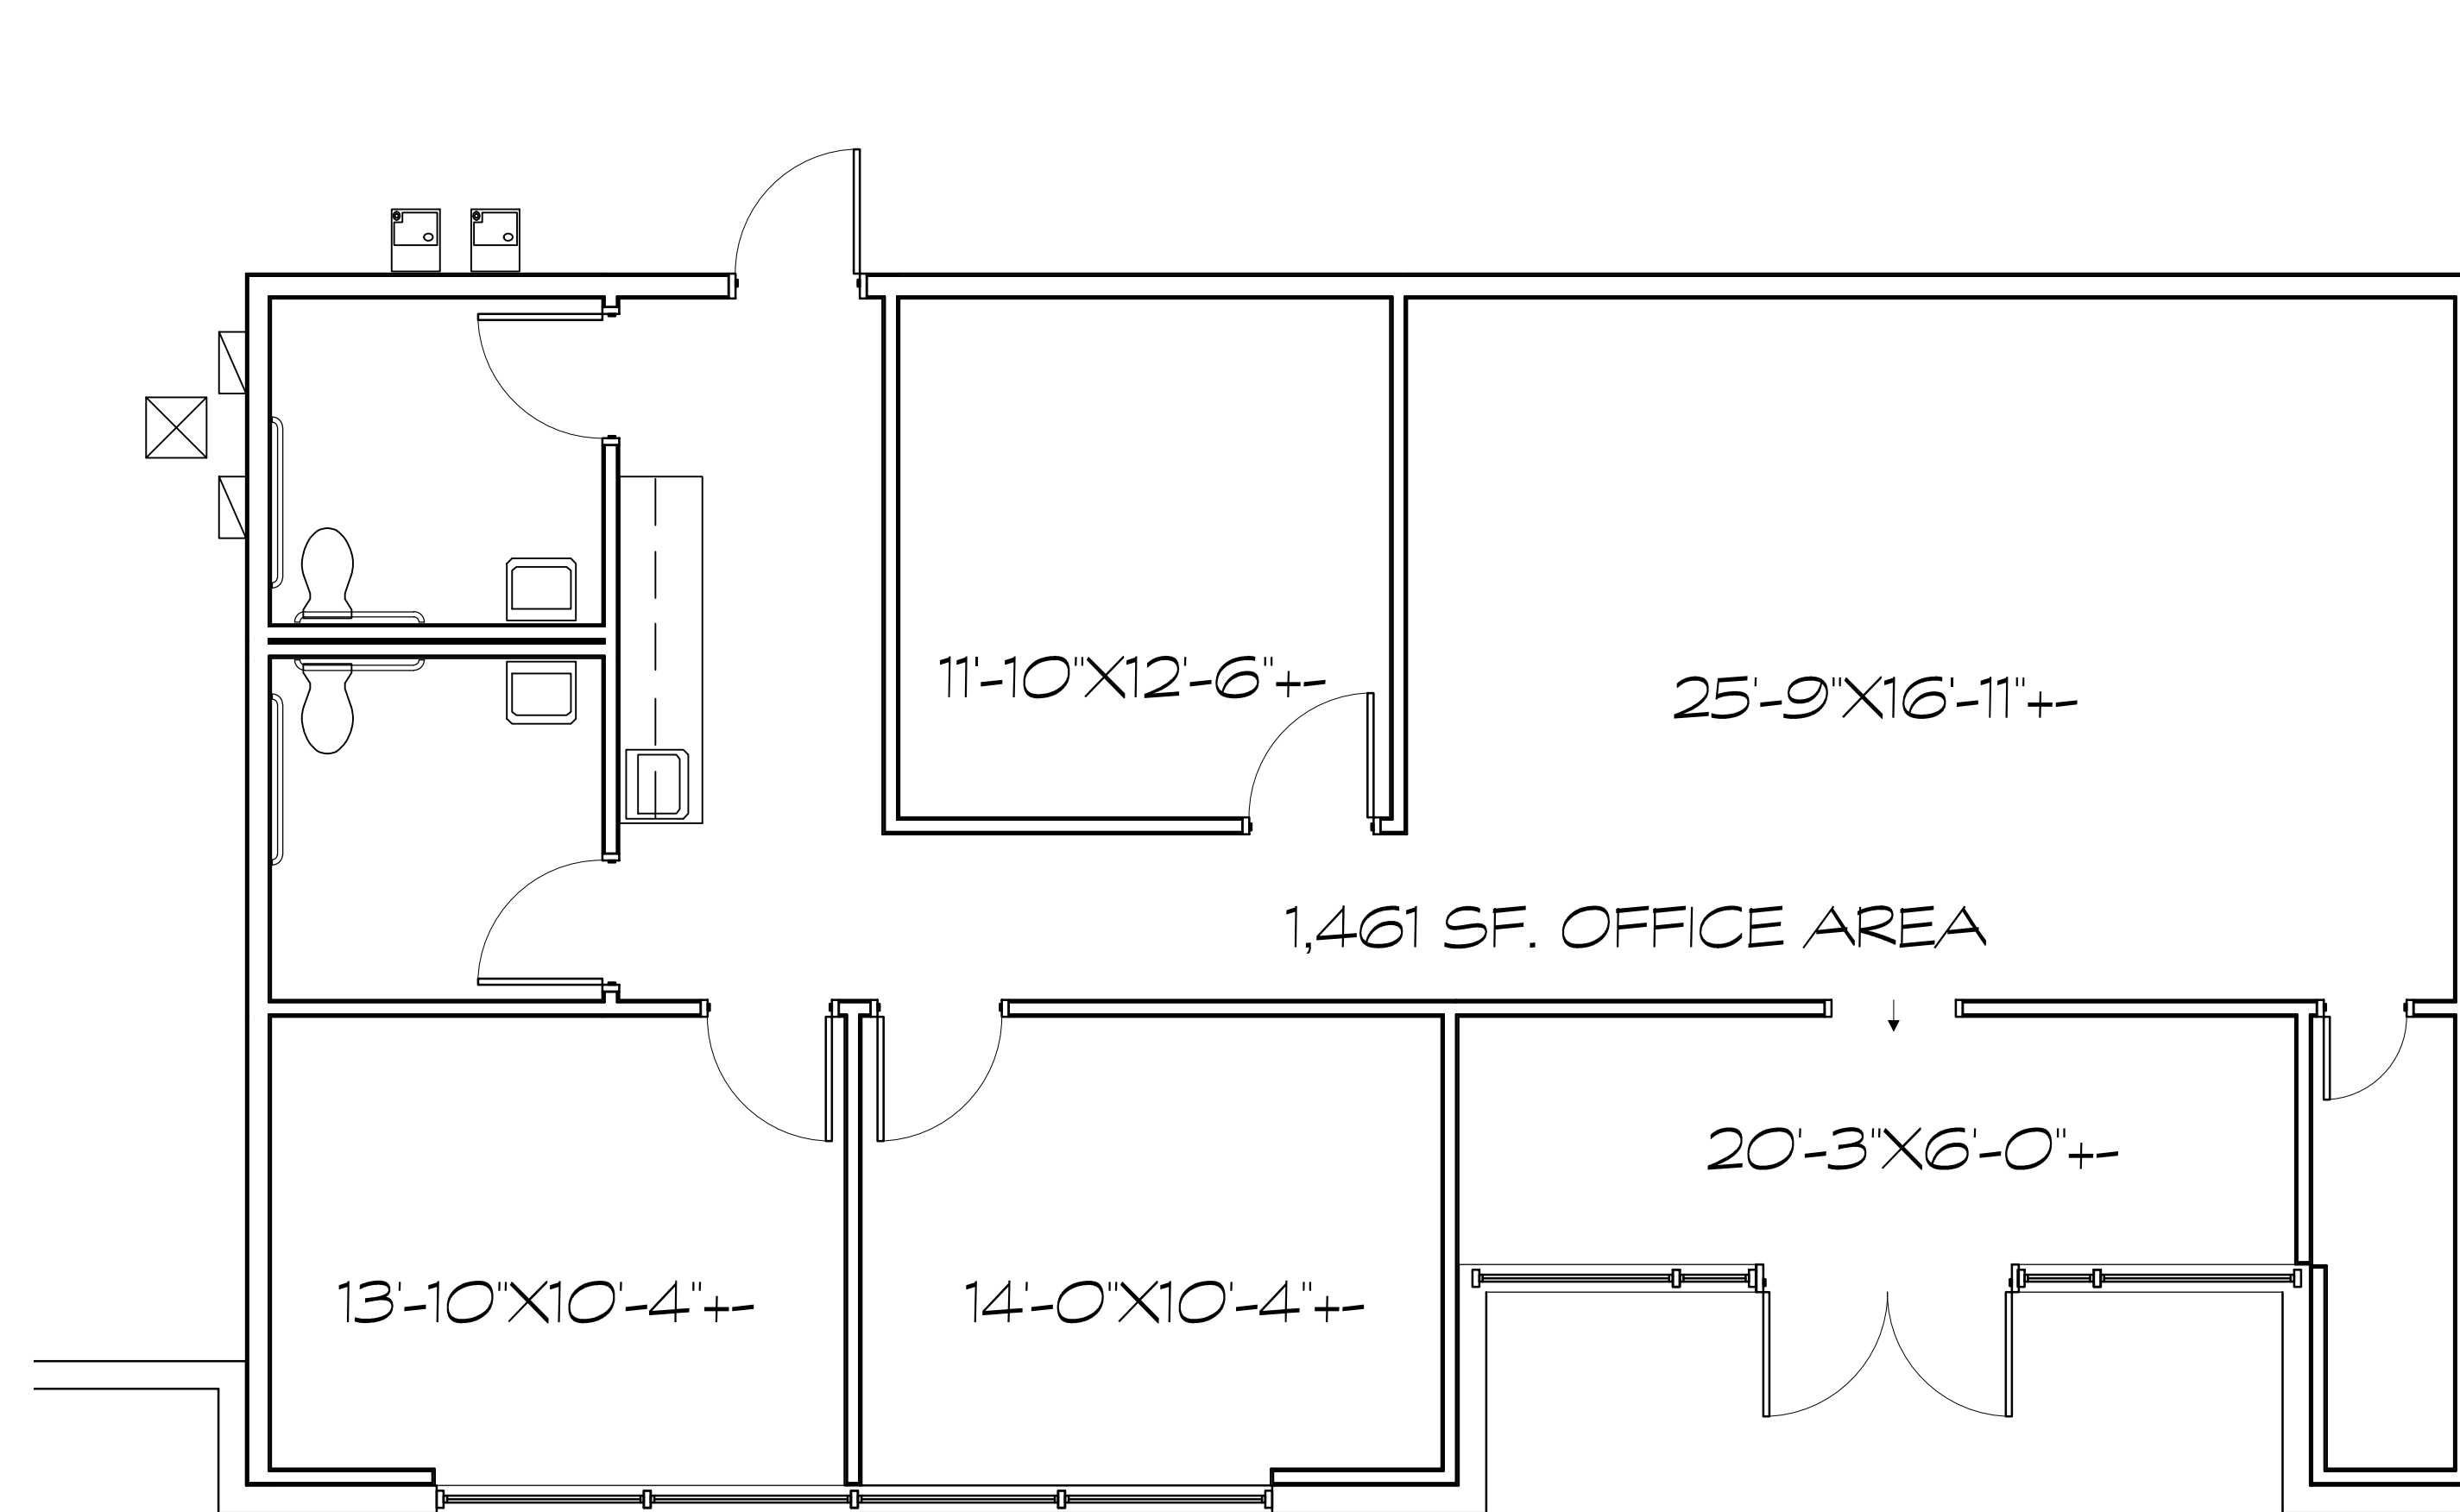

OFFICE FLOOR PLAN

SCALE: 1/4" = 1'-0"

A 15,000 SF. AREA
FOR LEASE
NORTHPOINT TRADE CENTER BLD. III
701 EIGHT TWENTY BLVD. SU. 101
FORT WORTH, TEXAS 76106

Copyright © 2019
Space Planning Specialists
These drawings, or parts
thereof, may not be
reproduced in any form, by
any method, for any
purpose, without prior
written consent from
Space Planning Specialists

SPACE PLANNING Telephone: 972/414-9391
SPECIALISTS Fax: 972/414-0997
COMMERCIAL SPACE
PLANNING & INTERIOR DESIGN

36X24 PLOT SIZE
JOB: NORTHPOINT FW
ISSUE DATES:
3/35/2019
FOR MARKETING
SHEET
A1
OF 1 SHEETS

NOT FOR CONSTRUCTION
FOR MARKETING

