



SUITE 2165  
AS-BUILT - 1 OF 1  
121 W TRADE  
1,988 RSF  
SCALE: 1/8" = 1'-0"  
DATE: JANUARY 7, 2022

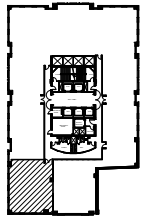

KEY PLAN

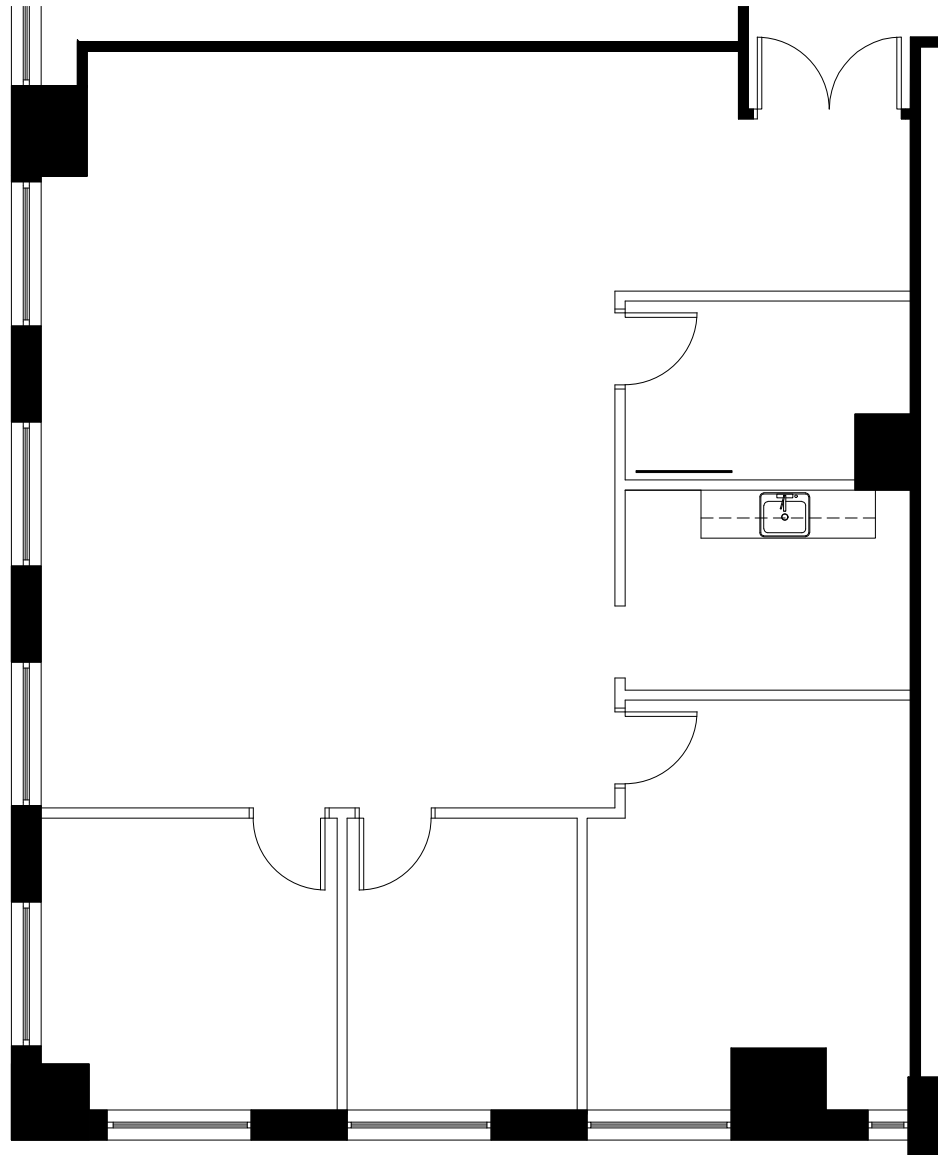

**CBRE**



**SMITH  
HARRIS**  
**DESIGN**  
associates