


SPACE AVAILABLE

# SUITE 309: 930 RSF

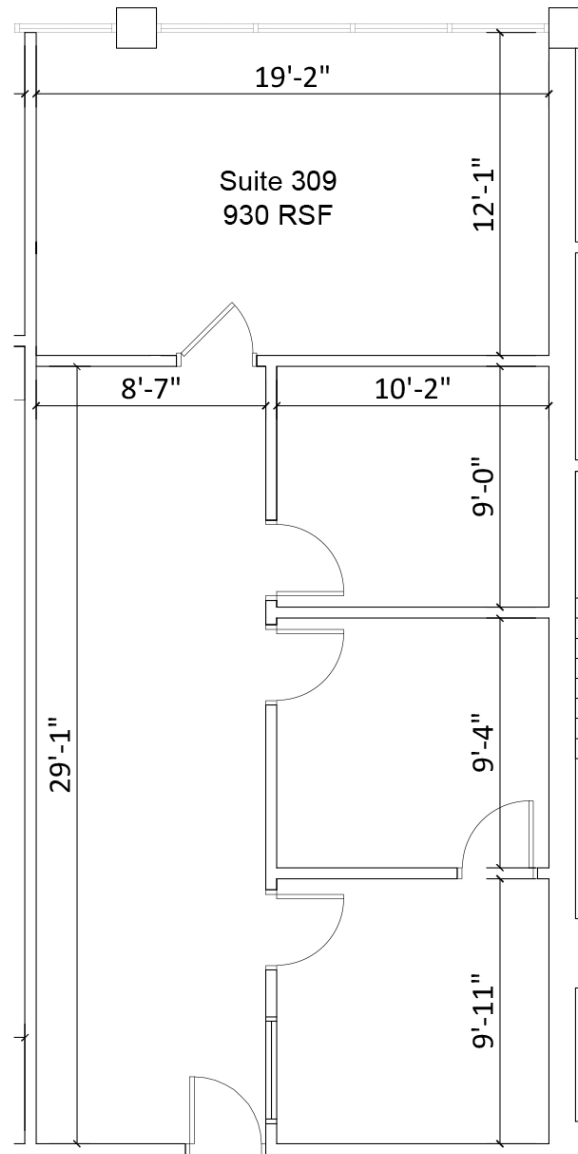

**WESTSHORE CITY CENTER**  
1211 N. Westshore Blvd  
Tampa, FL 33607

No warranty or representation, expressed or implied, is made to the accuracy of information contained herein, and same is submitted subject to errors, change of price, rental or other conditions, withdrawal without notice, and to any special listing conditions imposed by our principals. PLANS NOT TO SCALE

**MATT ALEXANDER**  
813.559.2006  
Matthew.Alexander@FranklinSt.com

**LORENZO GONZALEZ**  
813.793.8461  
Lorenzo.Gonzalez@FranklinSt.com

 **FranklinStreet**  
Licensed Real Estate Broker | FranklinSt.com