

KEYNOTES

No.	DESCRIPTION
1	TUBE STEEL CANOPY
2	FIRE RISER
3	TRUCK RAMP and GUARD WALL
4	RAMP SUMP/DRAIN - SEE MECHANICAL/PLUMBING PLANS
5	ROOF ACCESS LADDER
6	MEZZANINE GUARDWALL
7	ELECTRIC SWITCHGEAR
8	4" PIPE BOLLARD SET IN CONCRETE PER NV ENERGY STD.
9	COLUMN - SEE STRUCTURAL

WALL TYPES


	TYPICAL EXTERIOR WALL - 2 HOUR RATED - CMU (GROUT/REINFORCE PER STRUCTURAL) - w/ SKIN COAT STUCCO WHERE SHOWN ON PLAN - SEE PLAN FOR DESCRIPTION/TYPE/SIZE OF EXPOSED BLOCK. NON-GROUTED CELLS SHALL BE INSULATED. NOTE - SEE STRUCTURAL DRAWINGS FOR CMU FILLESTER LOCATIONS
	TYPICAL PROPERTY LINE WALL - 4 HOUR RATED SOLID GROUTED CMU - REINFORCE PER STRUCTURAL. NOTE - SEE STRUCTURAL DRAWINGS FOR CMU FILLESTER LOCATIONS
	TYPICAL INTERIOR WALL - 5/8" GYPED, BOTH SIDES 2x4 STUDS @ 16" OC (2x6 STUDS AT PLUMBING WALLS, WALLS DEFINING CONDITIONED SPACE, AND WHERE NOTED ON PLAN). WALLS DEFINING CONDITIONED SPACE SHALL BE FILLED w/ R-21 BATT INSULATION
	TYPICAL ELECTRIC RISER WALL - 1 HOUR FIRE RATED - 5/8" TYPE X GYPED, BOTH SIDES 2x4 STUDS @ 16" OC w/ R-13 BATTS - INSTALL PER ASSEMBLY ON SHEET X

EXITING LEGEND


	No. OF OCCUPANTS EXITING A ROOM
	No. OF OCCUPANTS EXITING AN AREA
	No. OF OCCUPANTS EXITING BUILDING

OCCUPANT LOAD FACTORS

OFFICE/BUSINESS AREAS	1/50
WAREHOUSE	1/500

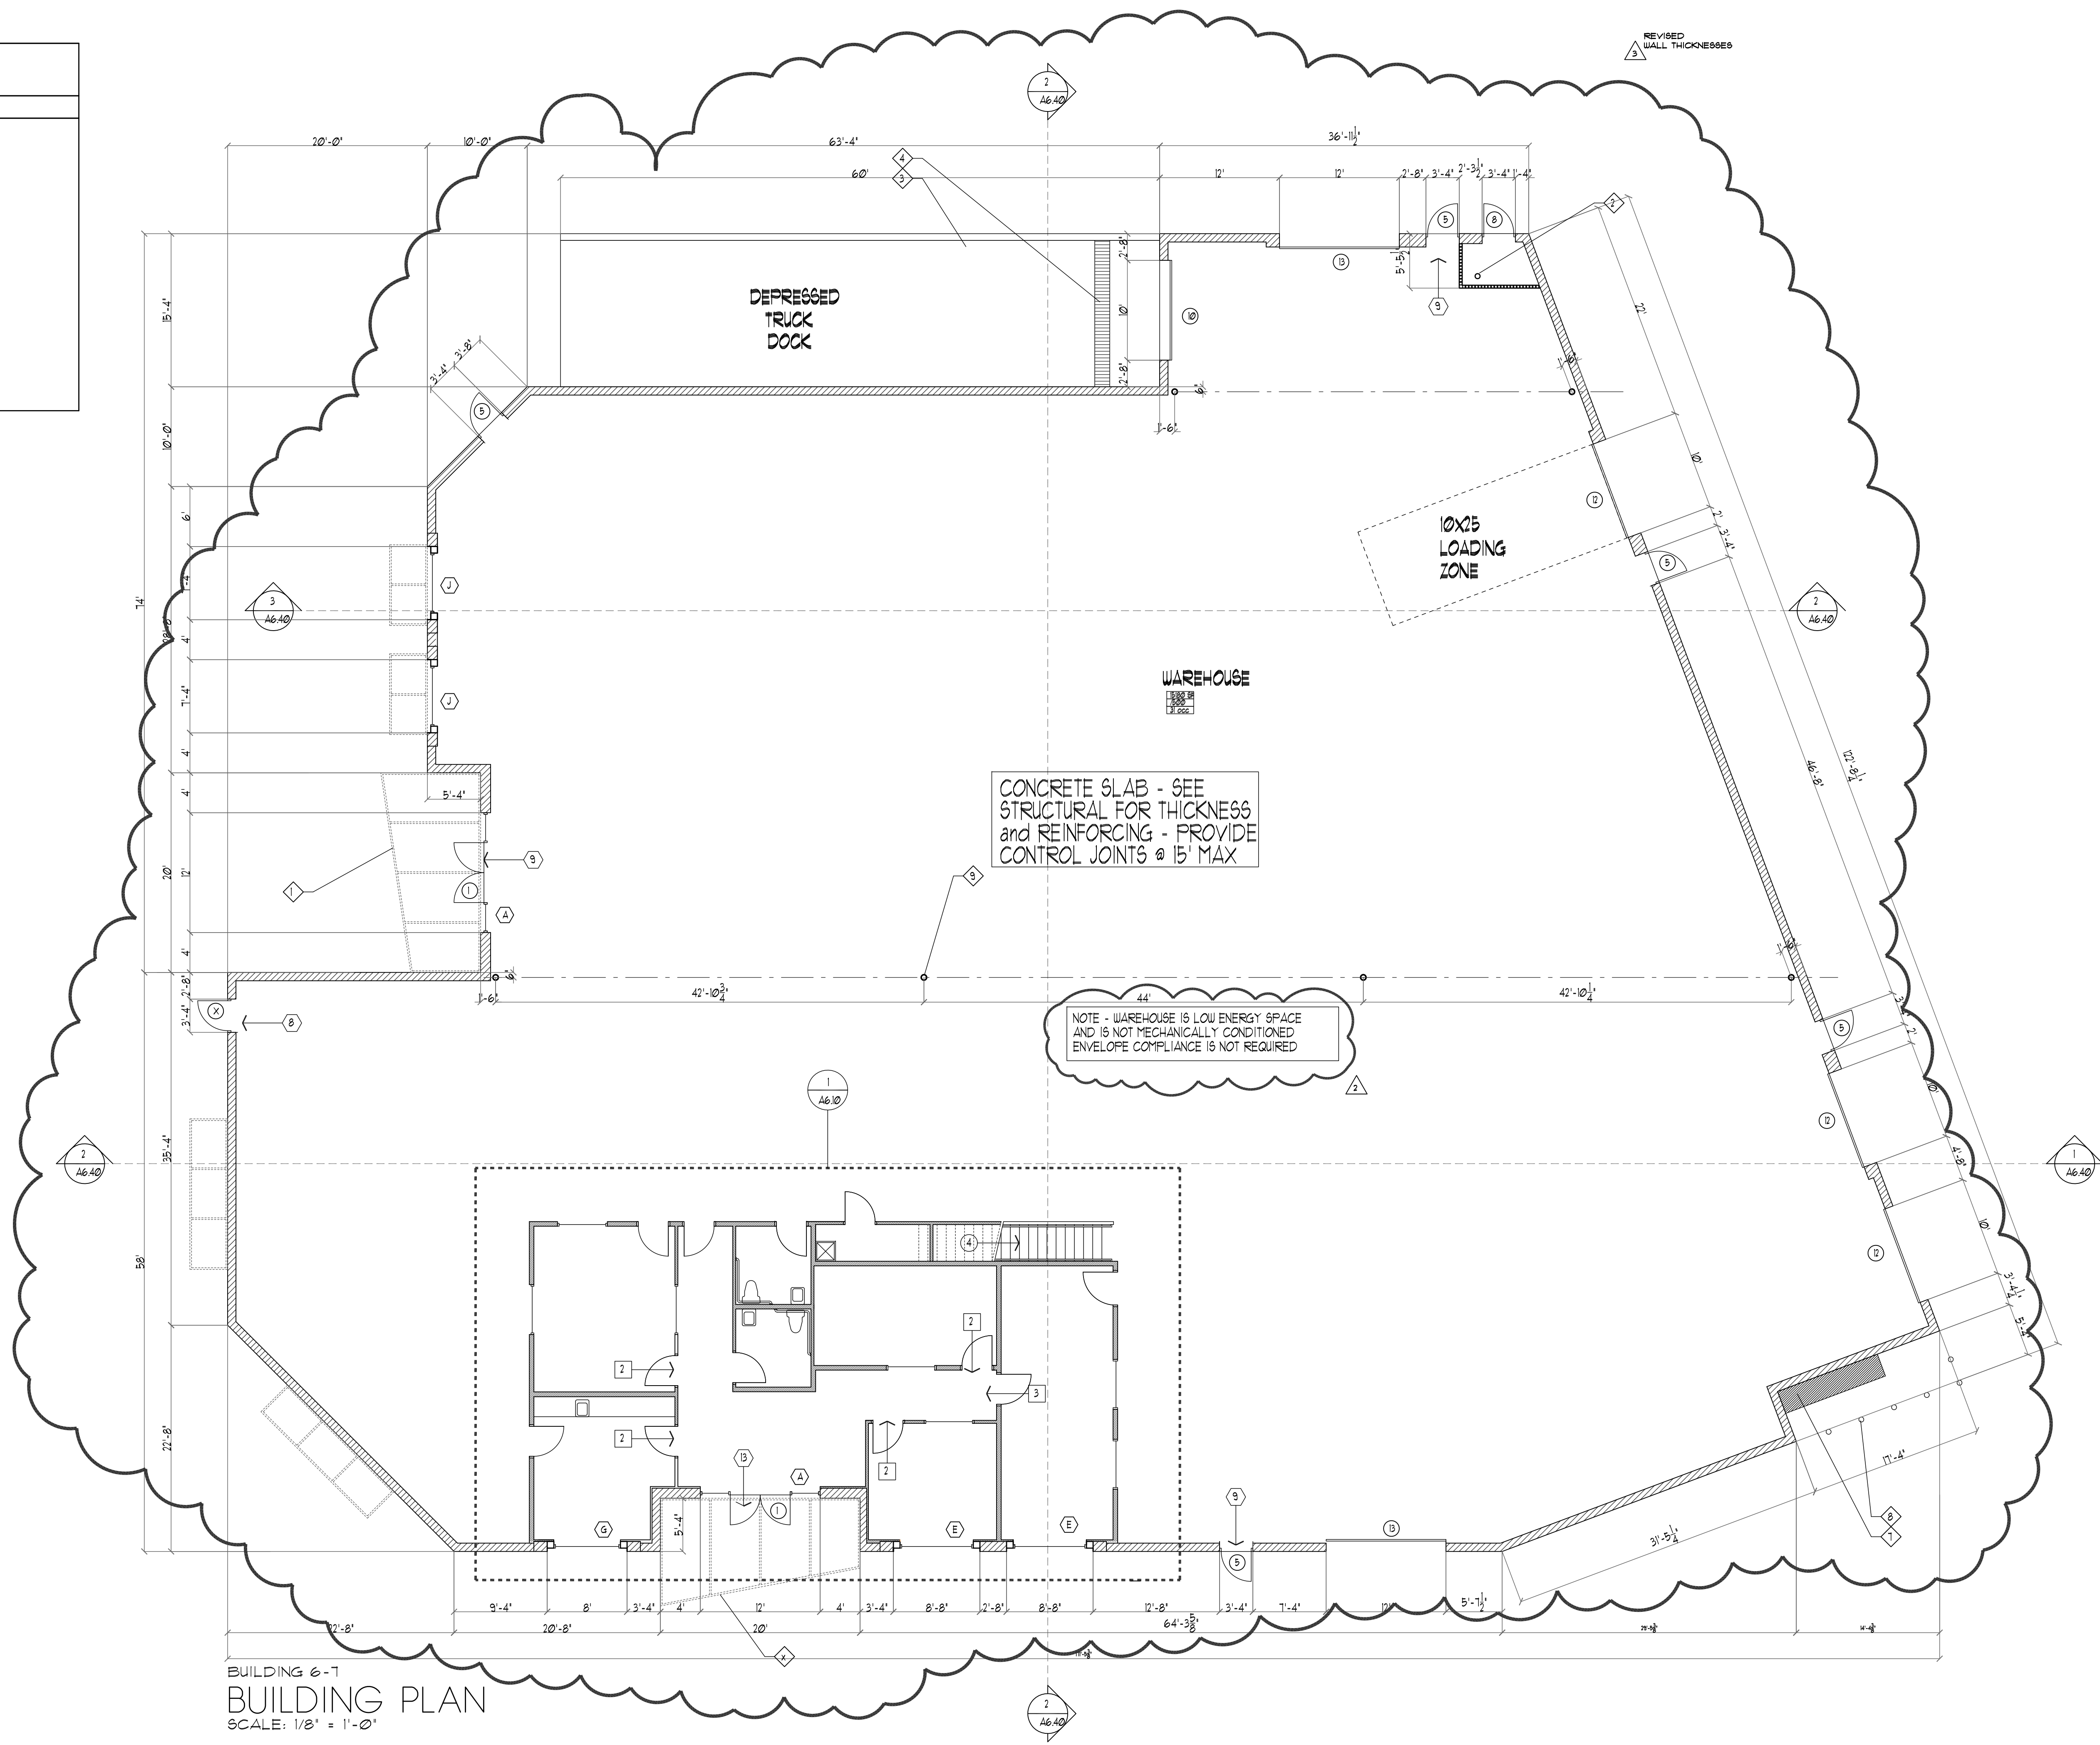

BUILDING 6-1
BUILDING PLAN
SCALE: 1/8" = 1'-0"

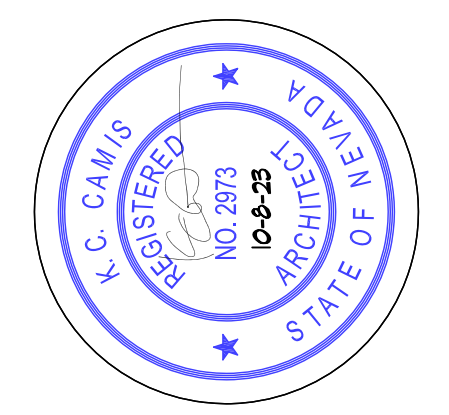

DRAWINGS & SPECIFICATIONS OF THIS ARCHITECT SHALL BE HIS PROPERTY. THEY ARE TO BE USED ONLY FOR THE PROJECT FOR WHICH THEY WERE PRODUCED. UNLESS SPECIFICALLY NOTED, THEY ARE NOT FINAL OR VALID. ANY USE OR REPRODUCTION OF THESE DOCUMENTS WITHOUT THE WRITTEN CONSENT OF THE ARCHITECT IS PROHIBITED.

662 MIDDLEGATE
HENDERSON, NEVADA 89011

662 MIDDLEGATE
HENDERSON, NEVADA 89011

KC CAMIS ARCHITECT
BECAUSE ARCHITECTURE SHOULD BE TORTURE

REVISIONS

NO.	DATE	DESCRIPTION
1		FOR PERMITS
2		FOR PERMITS
3		FOR PERMITS
JOB: CN10820
DATE: ...

1-20 @ RAINBOW
INDUSTRIAL PARK
for: **CALIBER CONSTRUCTION**
CLARK COUNTY NEVADA

NOTE: THESE PLANS ARE SUBJECT TO INTERNAL & CITY/COUNTY PLAN CHECK CORRECTIONS AND OTHER REQUESTED CHANGES. GENERAL CONTRACTOR & SUBCONTRACTORS SHALL VERIFY WITH THE OWNER & ARCHITECT THAT THEY ARE IN POSSESSION OF THE MOST RECENT SET PRIOR TO FINALIZING CONTRACT, PURCHASE, FABRICATION AND INSTALLATION OF ALL BUILDING COMPONENTS & SYSTEMS.

A6.00


KEYNOTES	
No.	DESCRIPTION
1	3/4" PLASTIC LAMINATE COUNTER w/BASE CABINETS BELOW - COORDINATE SELECTION w/OWNER
2	WALL CABINETS ABOVE - COORDINATE SELECTION w/OWNER
3	UTILITY SINK - ACCESSIBLE DEPTH (PROVIDE ACCESSIBLE FAUCET/CONTROLS)
4	POP/UTILITY SINK
5	STAIR w/HANDRAIL
6	LINE OF TUBE STEEL CANOPY ABOVE
7	1/2" FURRING and RIGID INSULATION
8	ACCESSIBLE WATER CLOSET
9	ACCESSIBLE GRAB-BARS
10	ACCESSIBLE LAV
11	SUSPENDED LAY-IN TILE CEILING (2X4 GRID w/OPT. 2ND LOOK TILE)
12	FURRED OR SUSPENDED GYPBD. CEILING
13	WALL MOUNT BABY CHANGING STATION - KOALA CARE OR EQUAL

WALL TYPES	
	TYPICAL EXTERIOR WALL - 2 HOUR RATED - CMU (GROUT/REINFORCE PER STRUCTURAL) - w/SKIMCOAT STUCCO WHERE SHOWN ON PLAN - SEE PLAN FOR DESCRIPTION/TYPE/SIZE OF EXPOSED BLOCK. NON-GROUTED CELLS SHALL BE INSULATED.
	TYPICAL PROPERTY LINE WALL - 4 HOUR RATED SOLID GROUTED CMU - REINFORCE PER STRUCTURAL.
	TYPICAL INTERIOR WALL - 5/8" GYPBD. BOTH SIDES 2X4 STUDS @ 16" oc (2X6 STUDS AT PLUMBING WALLS. WALLS DEFINING CONDITIONED SPACE, AND WHERE NOTED ON PLAN) - WALLS DEFINING CONDITIONED SPACE SHALL BE FILLED w/R-11 BATT INSULATION.
	TYPICAL ELEC/FIRE RISER WALL - 1 HOUR FIRE RATED - 5/8" TYPE X GYPBD. BOTH SIDES 2X4 STUDS @ 16" oc. w/R-13 BATTS - INSTALL PER ASSEMBLY ON SHEET X.


EXITING LEGEND

- No. OF OCCUPANTS EXITING A ROOM
 - No. OF OCCUPANTS EXITING AN AREA
 - No. OF OCCUPANTS EXITING BUILDING
- OCCUPANT LOAD FACTORS


OFFICE/BUSINESS AREAS 1/50
WAREHOUSE 1/500

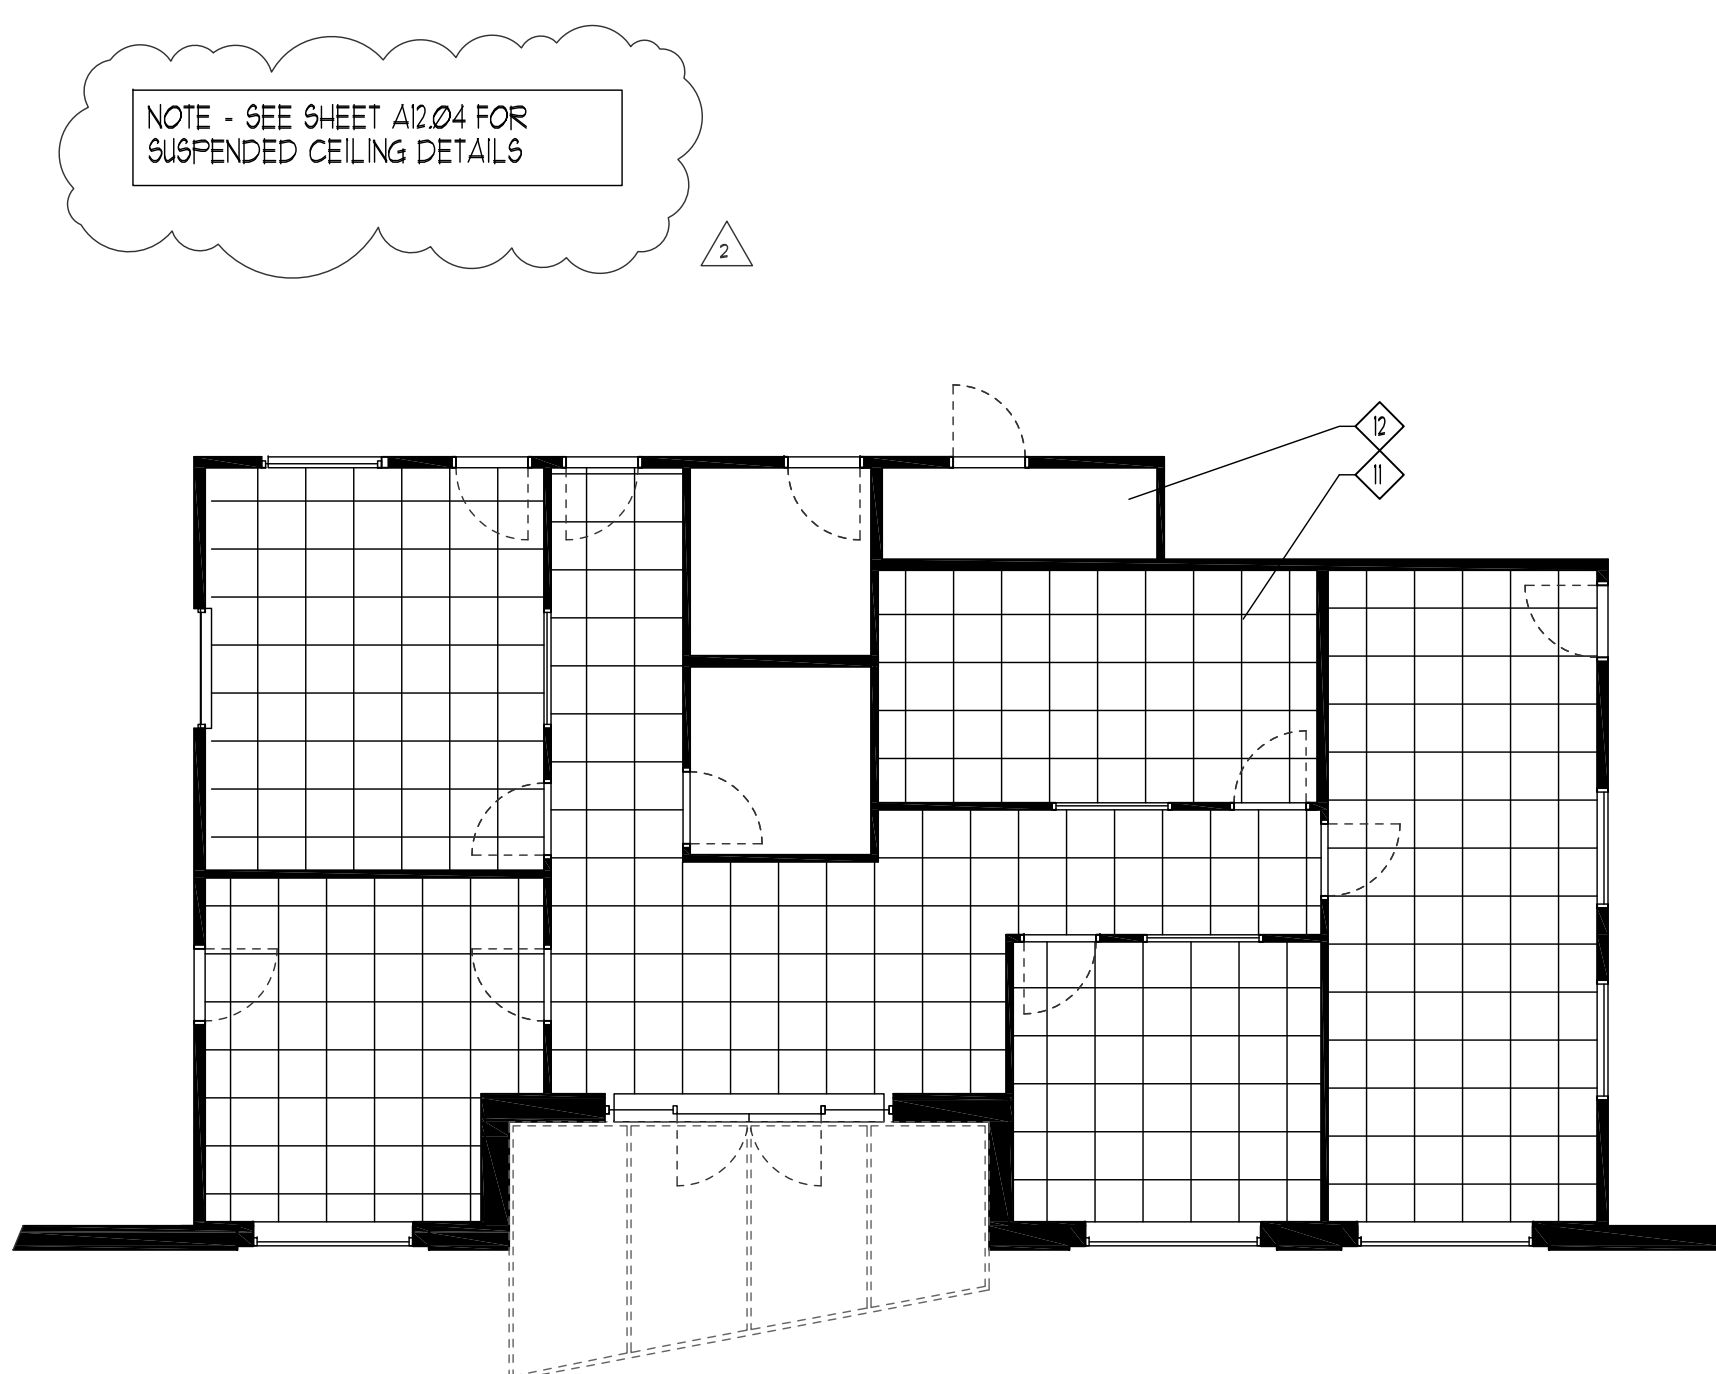

OFFICE CEILING PLAN
SCALE: 1/8" = 1'-0"

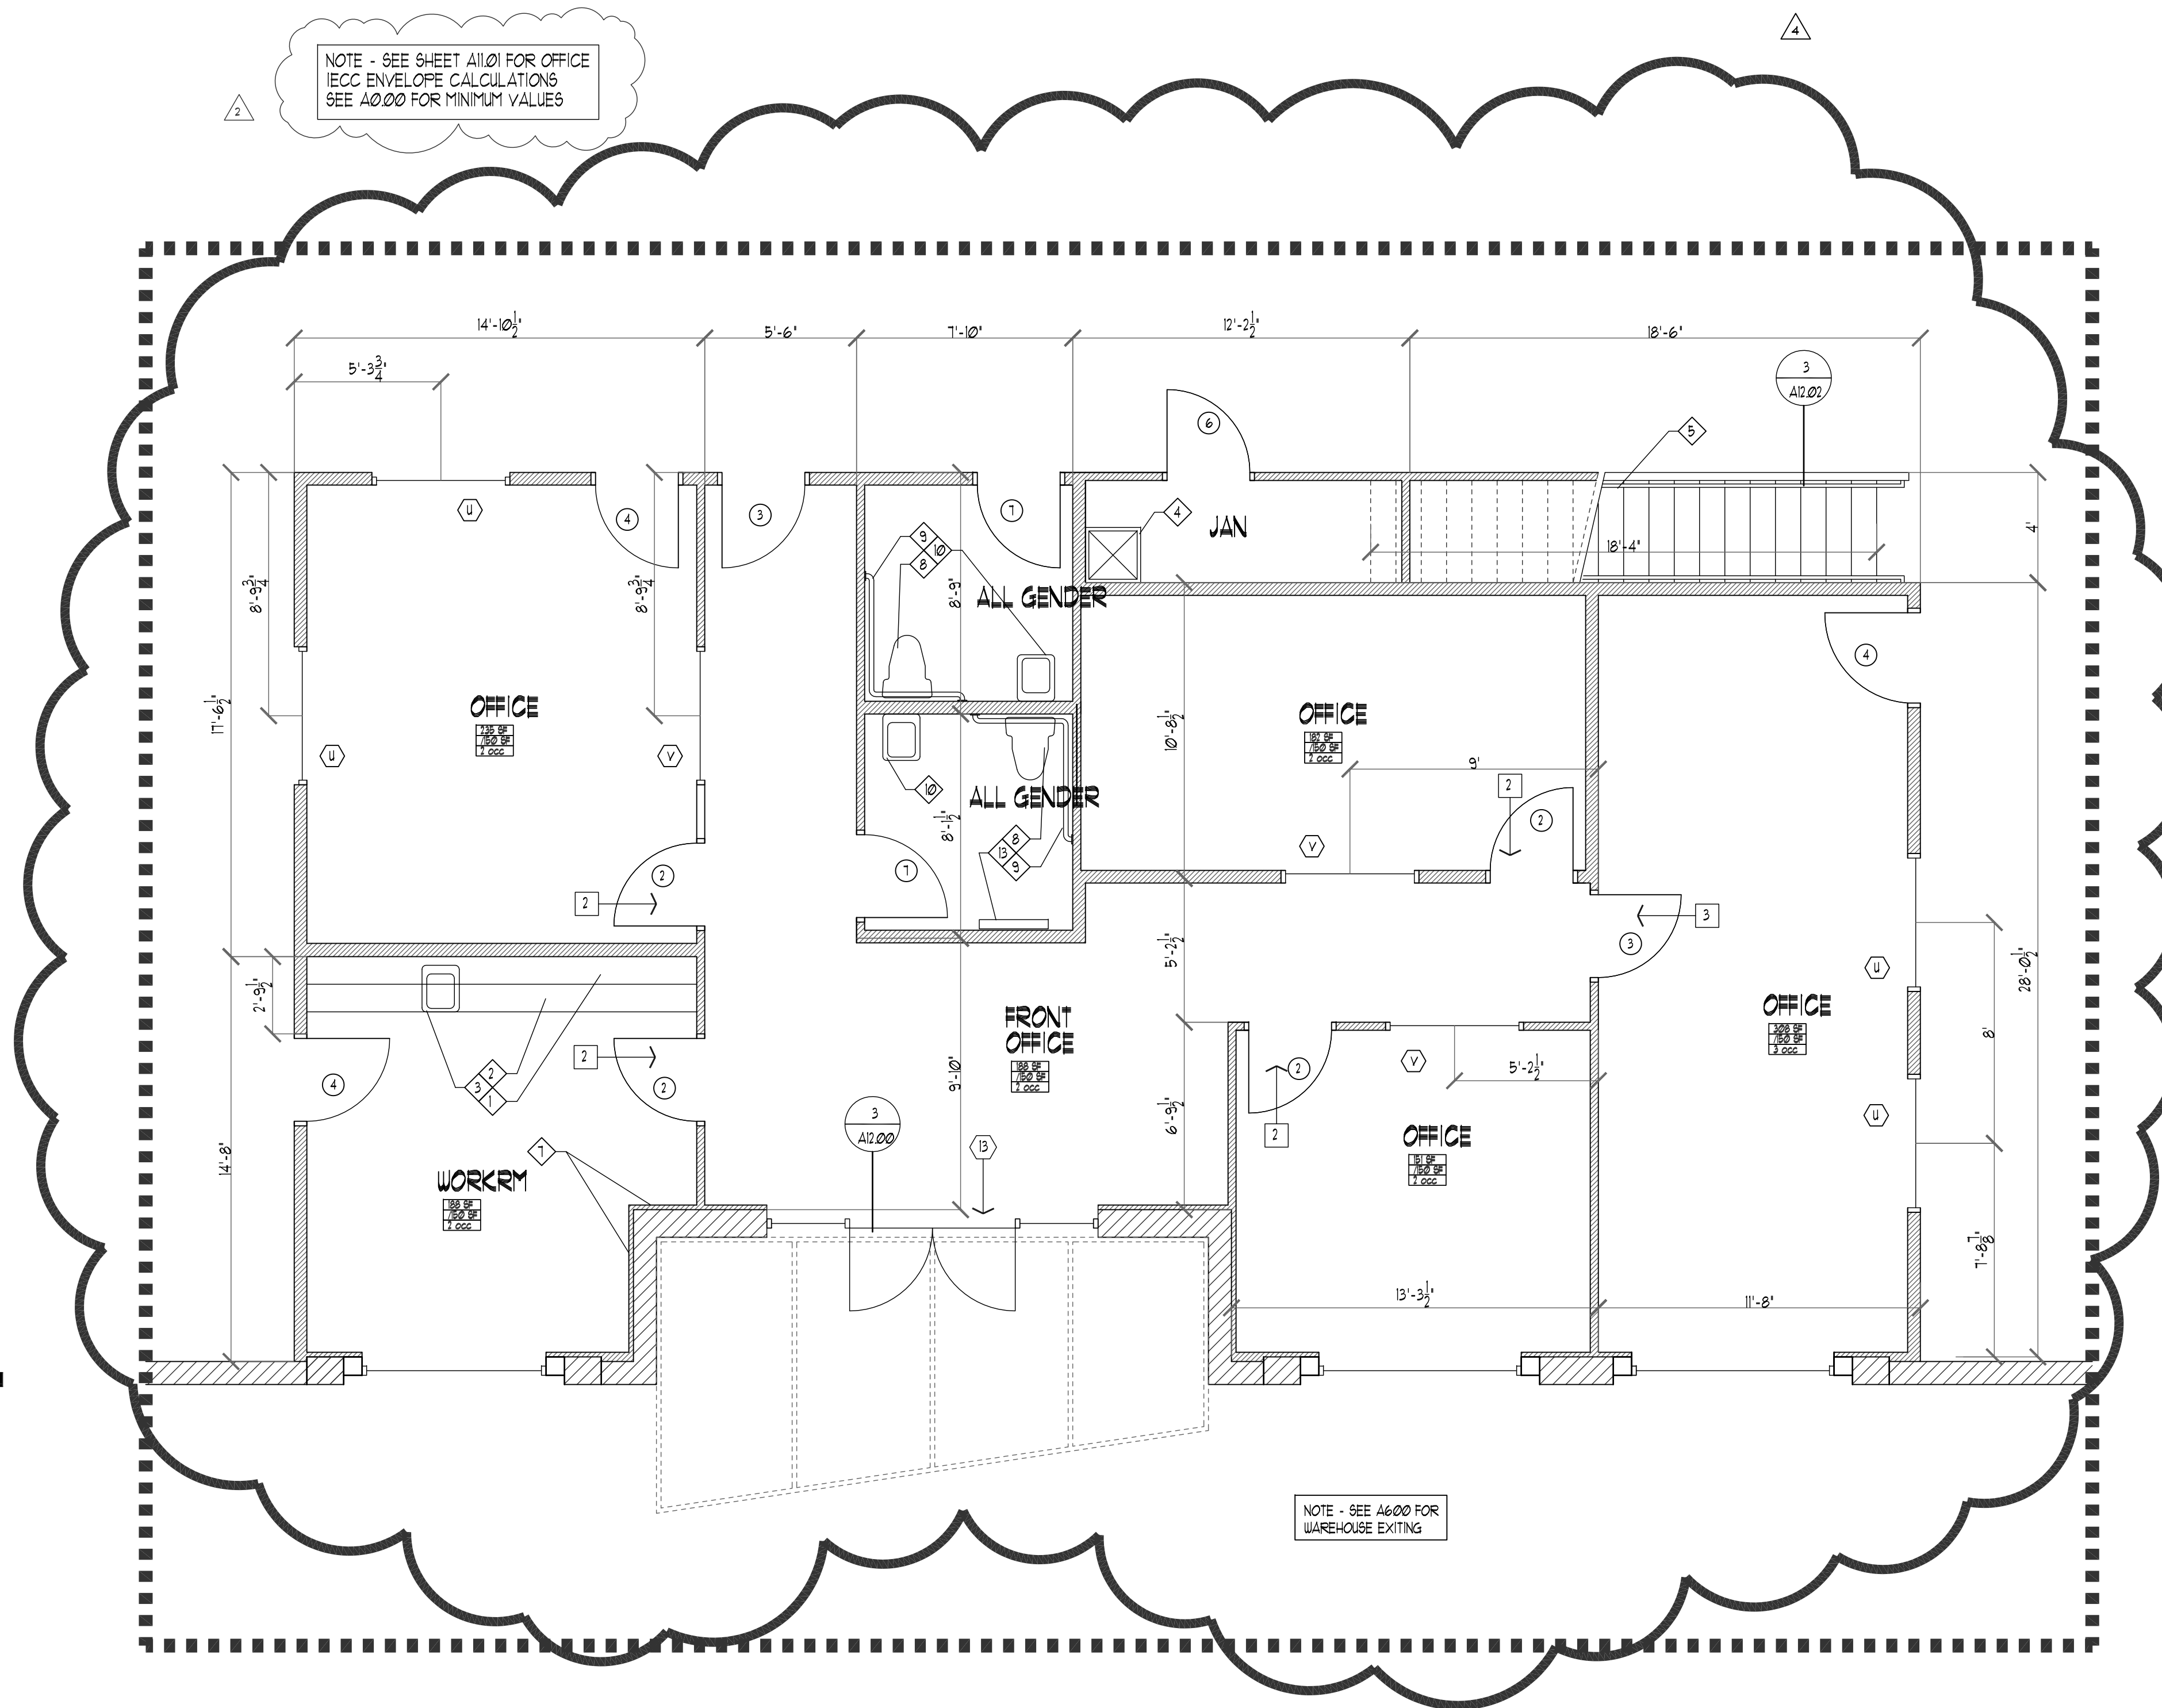


ENLARGED FLOOR PLAN
SCALE: 1/4" = 1'-0"

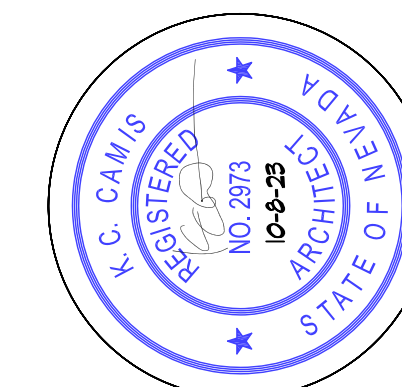

DRAWINGS & SPECIFICATIONS OF THIS ARCHITECT SHALL BE THE PROPERTY OF THE ARCHITECT. THEY ARE TO BE USED ONLY FOR THE PROJECT FOR WHICH THEY WERE PRODUCED. UNLESS SPECIFICALLY NOTED OTHERWISE, THEY ARE NOT FINAL OR VALID. ANY USE OR REPRODUCTION OF THESE DOCUMENTS WITHOUT THE WRITTEN CONSENT OF THE ARCHITECT IS PROHIBITED.

COPYRIGHT © 2021
K.C. CAMIS, ARCHITECT

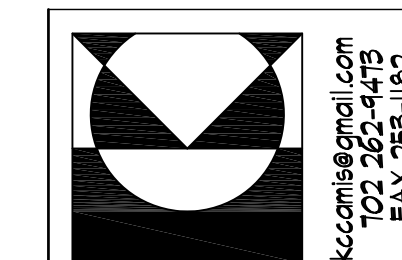

KC CAMIS ARCHITECT
BECAUSE ARCHITECTURE SHOULD BE TORTURE
FO BOX 4151 HENDERSON NV 89004
kccamis@gmail.com
702.262.4475
FAX 702.262.1152

NO.	DATE	DESCRIPTION

NO.	DATE	DESCRIPTION

JOB: CN10820
DATE: ...








1-20 @ RAINBOW
INDUSTRIAL PARK
for: CALIBER CONSTRUCTION
CLARK COUNTY NEVADA

NOTE: THESE PLANS ARE SUBJECT TO INTERNAL & CITY/COUNTY PLAN CHECK CORRECTIONS AND OWNER REQUESTED CHANGES. GENERAL CONTRACTOR & SUBCONTRACTORS SHALL VERIFY WITH THE OWNER & ARCHITECT THAT THEY ARE IN POSSESSION OF THE MOST RECENT SET PRIOR TO FINALIZING CONTRACT, PURCHASE, FABRICATION AND INSTALLATION OF ALL BUILDING COMPONENTS & SYSTEMS.

NO.	DATE	DESCRIPTION

A6.10

COLOR SCHEME

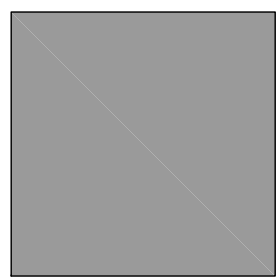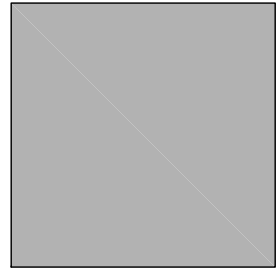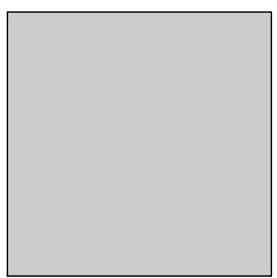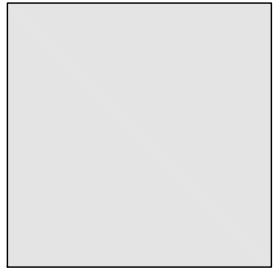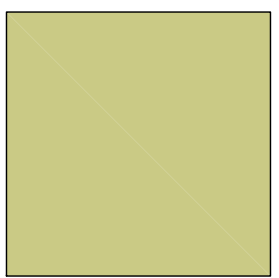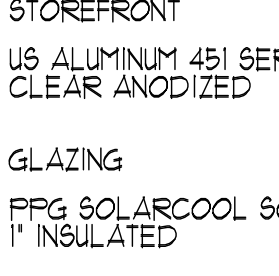- (A)  SPLITFACE CMU
DARK GREY
- (B)  HONED CMU
GREY
- (C)  HONED CMU
LIGHT GREY
- (D)  CANOPY/DOORS
FRAZEE CL2821W
MINISCULE
- (E)  STUCCO FIELD
FRAZEE CL2926M
MANITOU
- (F)  STOREFRONT
US ALUMINUM 451 SERIES
CLEAR ANODIZED
- (G)  GLAZING
PPG SOLARCOOL SOLEXIA
1" INSULATED


KEYNOTES

No.	DESCRIPTION
1	STUCCO @ 6" CMU (PARAPET)
2	STUCCO @ 8" CMU (PARAPET)
3	NOT USED
4	8" HONED CMU
5	10" SPLIT FACE CMU (TO 10')
6	12" HONED CMU (TO 30')
7	8" HONED CMU REVEAL AT WINDOWS - SEE PLAN FOR PILASTER
8	TUBE STEEL CANOPY
9	ALUMINUM STOREFRONT
10	OVERHEAD COLLING DOOR
11	LINE OF ROOF and EQUIPMENT BEHIND PARAPET
12	STEM WALL AT RAMP
13	



DRAWINGS & SPECIFICATIONS OF THIS ARCHITECT
 REMAIN SOLELY HIS PROPERTY. THEY ARE TO BE
 USED ONLY FOR THE PROJECT FOR WHICH THEY
 WERE PRODUCED. UNTIL SEALED, SIGNED, & DATED,
 THEY ARE NOT FINAL OR VALID. ANY USE OR
 REPRODUCTION OF THESE DOCUMENTS WITHOUT
 THE WRITTEN CONSENT OF THE ARCHITECT IS
 PROHIBITED.

COPYRIGHT © 2021
 K.C. CAMIS, ARCHITECT

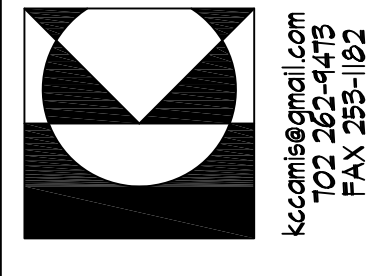

**KC CAMIS
 ARCHITECT**
 BECAUSE ARCHITECTURE
 SHOULD BE TORTURE

662 MIDDLEGATE HENDERSON, NEVADA 89011
 702.262.4475
 FAX 702.265.1162


JOB: CN10820
 DATE: ...

1-20 @ RAINBOW
 INDUSTRIAL PARK
 for: CALIBER CONSTRUCTION
 CLARK COUNTY NEVADA


NOTE: THESE PLANS ARE SUBJECT TO INTERNAL & CITY/JOINT PLAN. CHECK CORRECTIONS AND OWNER REQUESTED CHANGES. GENERAL CONTRACTOR & SUBCONTRACTORS SHALL VERIFY WITH THE OWNER & ARCHITECT THAT THEY ARE IN POSSESSION OF THE MOST RECENT SET PRIOR TO FINALIZING CONTRACT, PURCHASE, FABRICATION AND INSTALLATION OF ALL BUILDING COMPONENTS & SYSTEMS.

BUILDINGS 6 - 7

A6.21

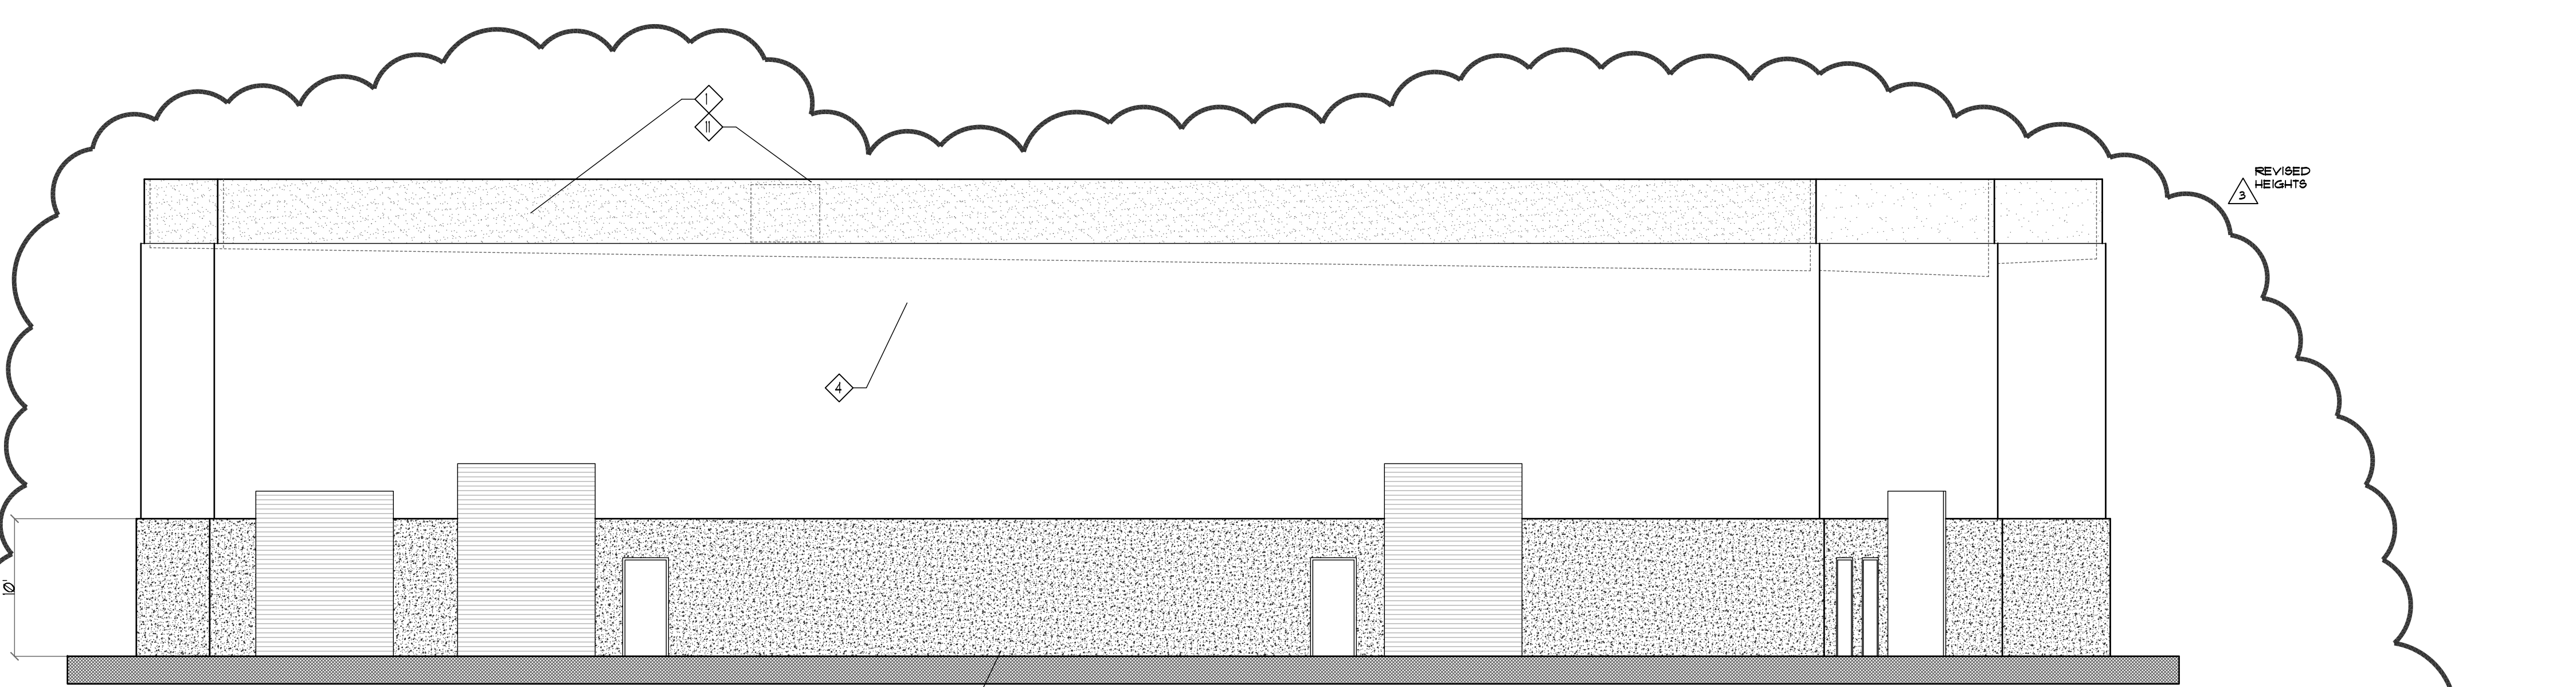

2 EAST ELEVATION
 SCALE: 1/8" = 1'-0"

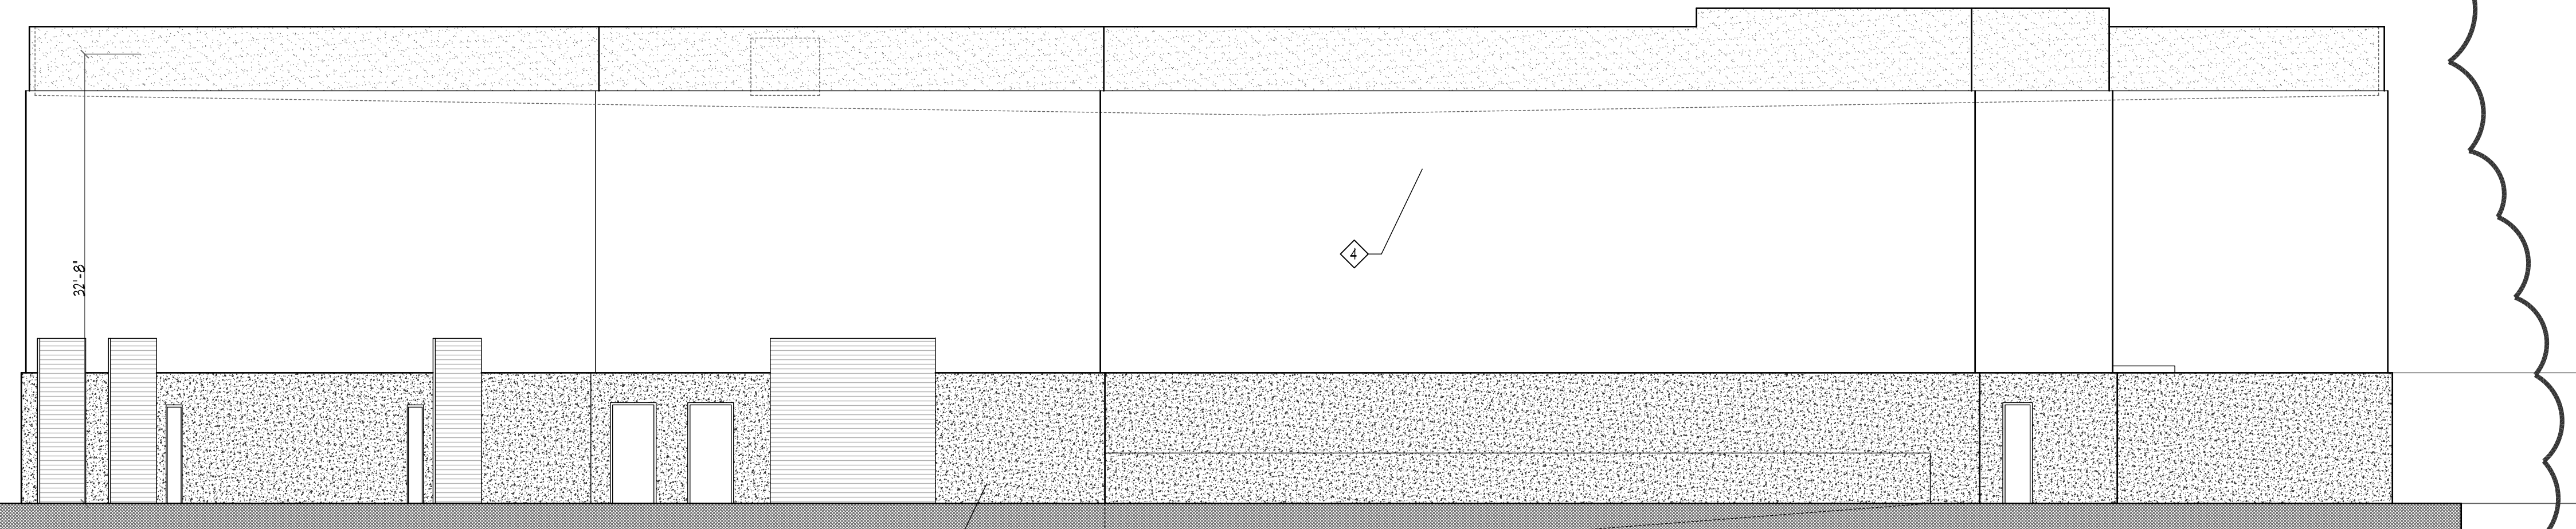

1 NORTH ELEVATION
 SCALE: 1/8" = 1'-0"