

- ### GENERAL NOTES
- ALL DIMENSIONS TAKEN FROM FACE OF FOUNDATION (EXT. WALLS) & FROM FACE OF WALLS (INT. WALLS). GRID LINES = FACE OF FOUNDATION OR CENTER OF COLUMN. - SEE SECTIONS.
 - VERIFY ALL DIMENSIONS, LOCATION OF DOORS, STOREFRONT, ETC. WITH TENANT'S REP. & LATEST EDITION OF THE TENANT EQUIPMENT PLAN PRIOR TO PROCEEDING WITH AFFECTED WORK.
 - SEE 2/T1.1 FOR DOOR DISABLED ACCESS REQUIREMENTS.
 - VERIFY THE LOCATION OF FIRE EXTINGUISHERS AND MAX. OCCUPANCY SIGNS WITH THE BUILDING OFFICIAL PRIOR TO INSTALLATION.
 - SLOPE ALL FLOORS W/ DRAIN 2% MAX. TO DRAIN.
 - CLEAN EFFLORESCENCE FROM INSIDE OF ALL EXTERIOR MASONRY WALLS. PREPARE SURFACE PER MFR. INSTRUCTIONS & PAINT FROM FLOOR TO STRUCTURE w/ BLOCK FILLER & SEALER.
- ### PLAN NOTES
- EXPOSED (E) COLUMN TO BE PAINTED
 - DOOR SIGN: ELECTRICAL EQUIPMENT
 - DOOR SIGN: FIRE RISER
 - LINE OF FLOORING TRANSITION - SEE SHEET A4.1
 - SLOPE MAX. 2% TO DRAINS. DRAIN GRATE SLOTS/ OPENINGS SHALL BE MAX. 1/2" WIDE. FOR POOL DECK DRAIN SPECIFICATIONS SEE POOL PLANS SHEET SP101.
 - PROVIDE SIGN: "NO SMOKING WITHIN 25 FEET OF THE ENTRANCE DOORS"
 - SPA EMERGENCY SHUT OFF.
 - (E) ONE HOUR RATED DEMISING WALL UNDER SHELL PERMIT (TYP)
 - (E) ONE HOUR RATED WALL SECTION UNDER SHELL PERMIT. FINISH - NEW CURRING-FLUSH INFILL (E) OPENING. SEE S2.1
- NOTE: FOR WALL TYPE SCHEDULE SEE SHEET A2.1 & A2.2. FOR MATERIALS SEE SHEETS T3.1 & T3.2. FOR FINISHES SEE SHEETS A4.1, A5.1, & A8.1-A8.8.


WALL LEGEND

	EXTEND STUDS TO ROOF DECK. EXTEND CHG. BD. TO ROOF SICK AT LEAST ONE SIDE - SEE WALL TYPE SCHEDULE.
	EXTEND STUDS TO 6" ABOVE LAY-IN CEILING, U.N.O. (SEE 16/A9.1 FOR BRACING)
	1-HOUR RATED FIRE BARRIER.
	9" HIGH CONCRETE CURB IN WALLS. SEE DETAIL 01/A9.1
	EXISTING WALL

NOTE: FOR ADDITIONAL EQUIPMENT INFORMATION SEE ENLARGED PLANS

NOTE: SEE SHEET T1.1 & T1.1.1 FOR ACCESSIBILITY. SEE T2.1 FOR CODE COMPLIANCE & EXISTING

A FLOOR PLAN
40,551 GROSS S.F.
3/32" = 1'-0"
PLAN NORTH


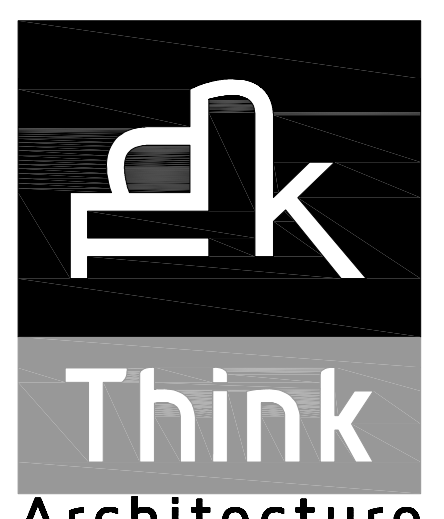


Architecture
Interior Design
Landscape Architecture
Land Planning
Construction Management

5151 South 900 East, Suite 200
Salt Lake City, UT 84117
Ph: 801.269.0655
Fax: 801.269.1425
www.thinkaoc.com

The design shown and described herein including all technical drawings, graphic representation & models thereof are proprietary & can not be copied, duplicated or commercially exploited in whole or in part without the use and express written permission from Think Architecture, Inc.

These drawings are available for limited review and evaluation only for the project listed below by clients, consultants, contractors, government agencies, vendors, and other personnel only in accordance with this notice.

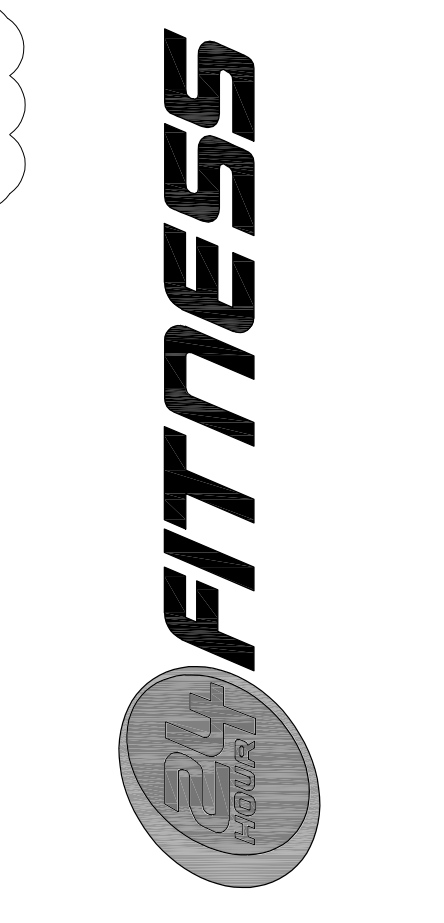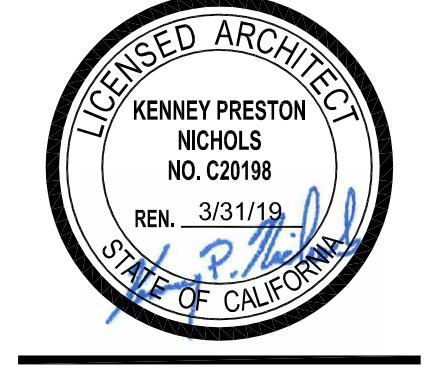

24 HOUR FITNESS
SAN JOSE EAST SIDE
2323 MCKEE ROAD
SAN JOSE, CA

PROJECT NO. 16-092
DATE: SEPTEMBER 28, 2017

- ### REVISIONS:
- DECEMBER 4, 2017 - POOL PLAN CHECK RESPONSE #1
 - DECEMBER 28, 2017 - BID ISSUE
 - JANUARY 16, 2018 ADDENDUM #1
 - AUGUST 24, 2018 PLAN CHECK RESPONSE #1 & OWNER CHANGES
 - SEPTEMBER 14, 2018 ELECTRICAL P. C. RESPONSE #2
 - FEBRUARY 28, 2019 CONSTRUCTION ISSUE & OWNER CHANGES
 - APRIL 10, 2019 FRONT DESK CHANGES

SHEET TITLE:
FLOOR PLAN

SHEET NUMBER:
A1.1