

Project No. 26027

REVISION	EXISTING BUILDING AS-BUILT-REVIEW SET
3/30/26	

**NOT FOR REGULATORY
APPROVAL, PERMITTING, OR
CONSTRUCTION**

These designs are the sole property of Crescent Design Group LLC and may not be used or reproduced in any form, by any method, for any purpose without written permission.

Crescent Design Group LLC
ARCHITECT
2 W Trace Creek
The Woodlands Tx 77381
Tel 281.387.7486
TX Lic 172588

SUITE 500


9980 W SAM HOUSTON PKWY S,
SUITE 500 HOUSTON, TX 77099

DRAWN BY S.J.G./D.J.C.
DATE 3/30/26

MARKETING PLAN

SCALE: AS NOTED

PAGE
AB1.10

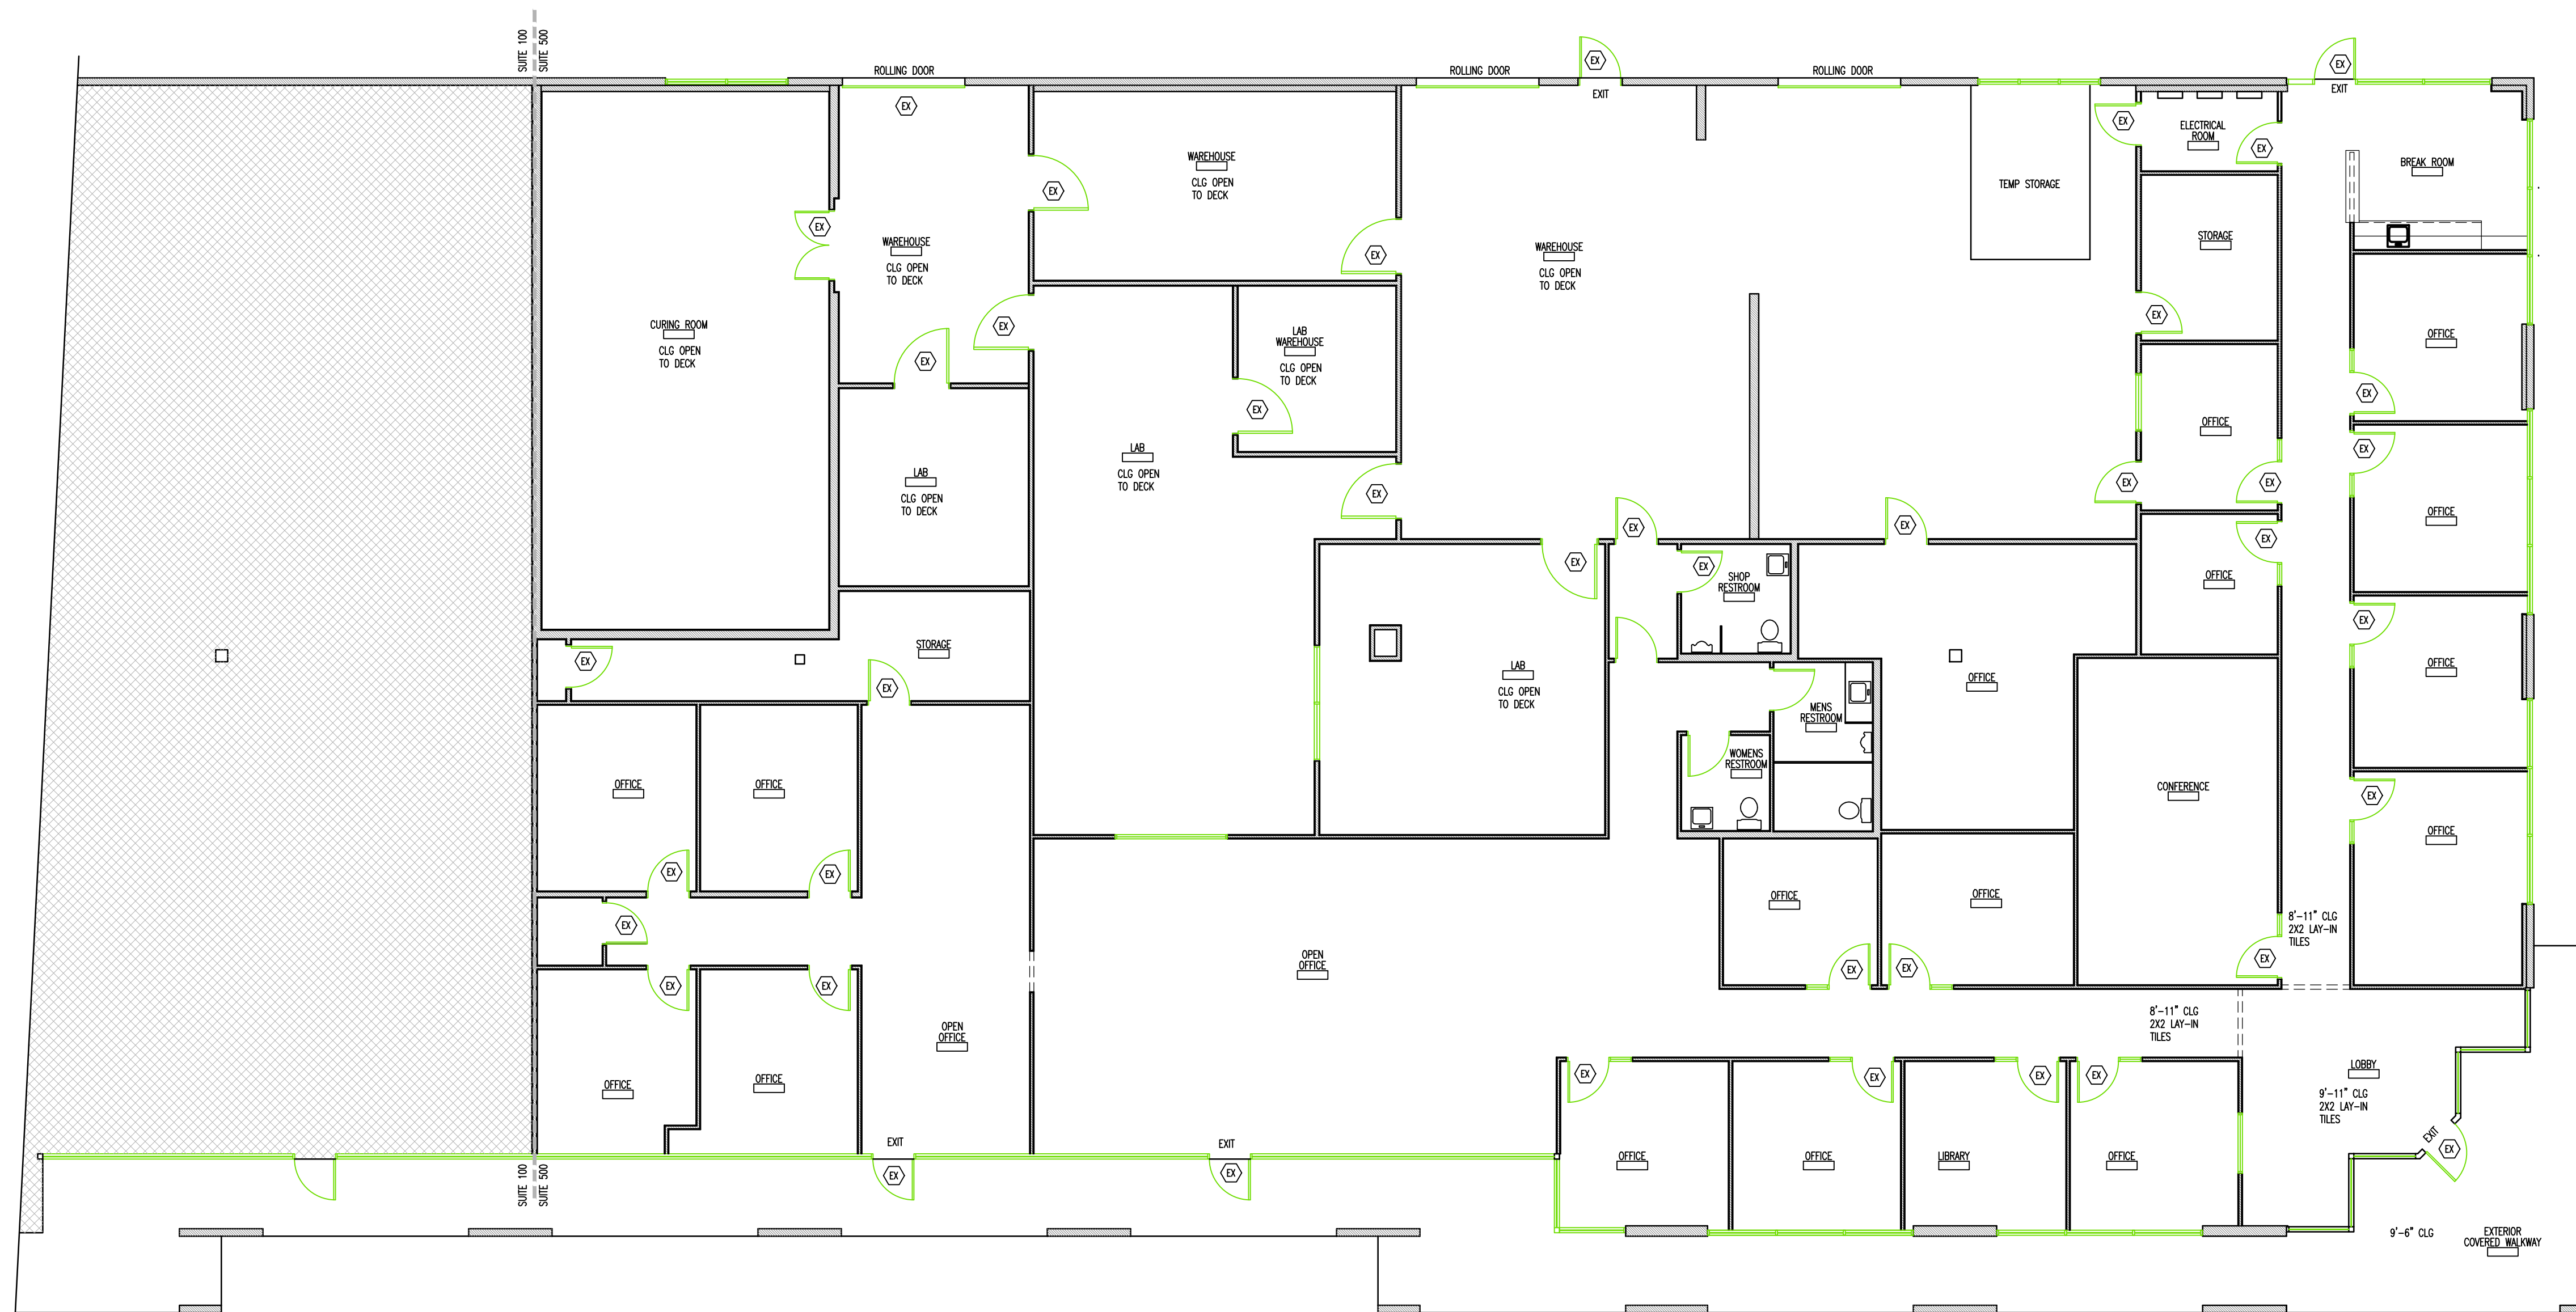

GENERAL NOTE:
THIS DRAWING IS TO BE USED FOR AREA
CALCULATION PURPOSES ONLY AND CANNOT BE USED
AS A FINAL DESIGN OR FOR PRICING, REGULATORY
APPROVAL, PERMITTING OR CONSTRUCTION.
ADDITIONAL EXITS, WALLS, DOORS OR OTHER DESIGN
FEATURES MAY BE REQUIRED TO COMPLY WITH FIRE
AND BUILDING CODES. FOR ANY WORK TO BE DONE AT
THIS LOCATION THE DESIGNER AND CONTRACTOR MUST
INVESTIGATE EXISTING CONDITIONS TO VERIFY BEFORE ANY
WORK IS STARTED.

