


Property Key

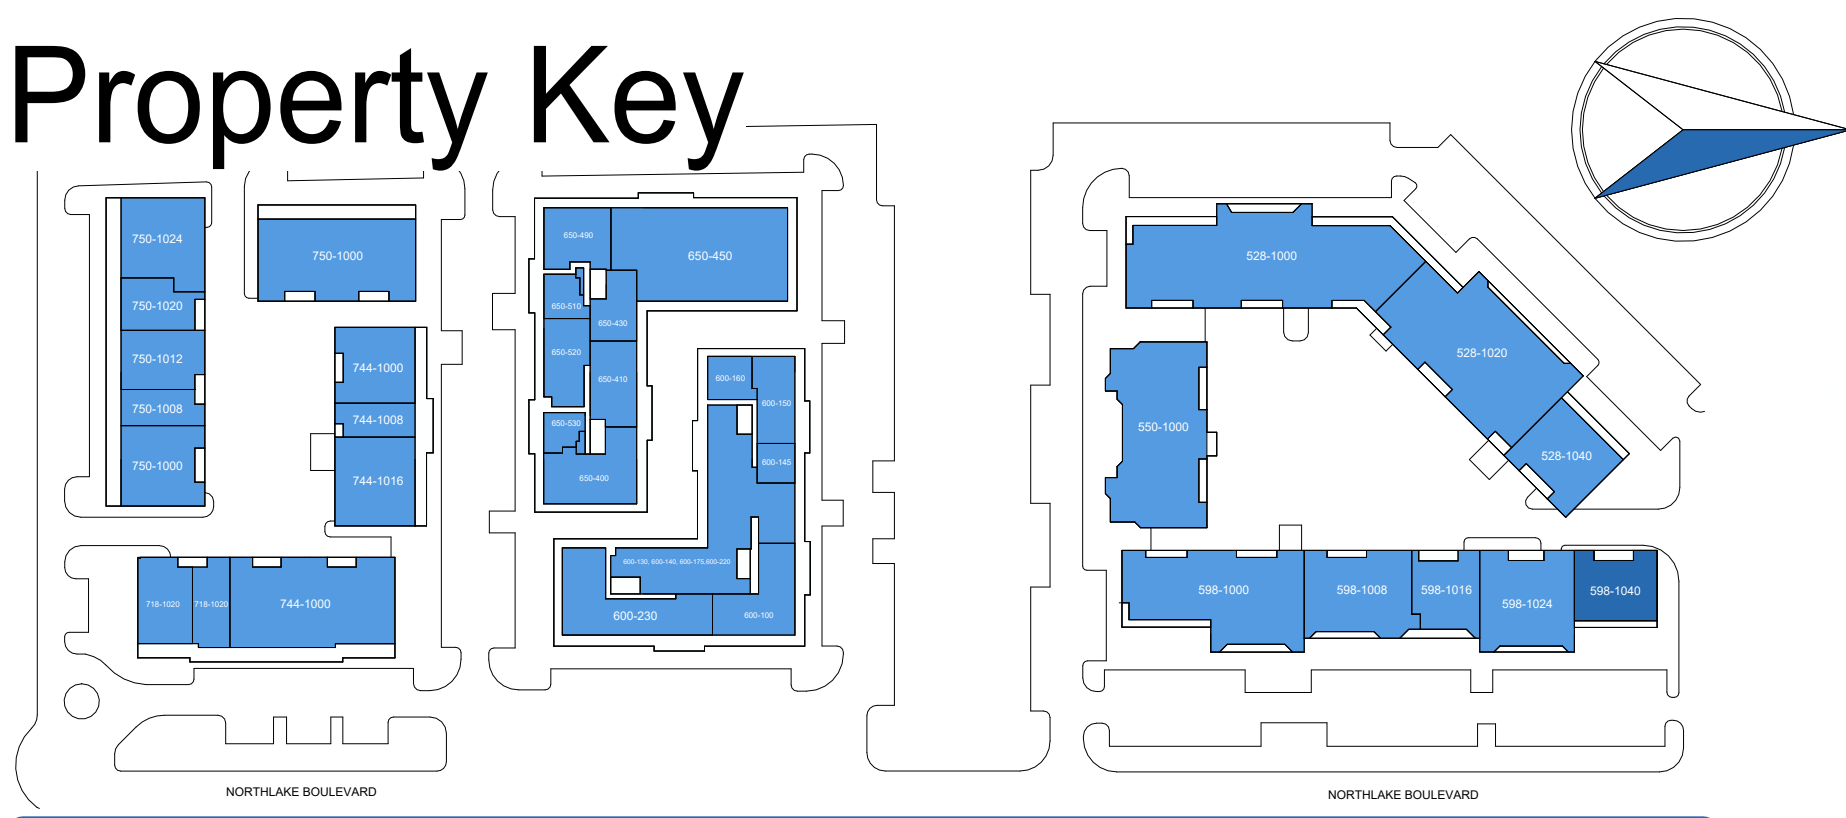

Alt Springs As Built Marketing Package

598 Northlake Blvd, Alt Springs, FL 32701, US

Building: 598

Suite: 1040

Sheet **E1**

Scale: Not to Scale
Sheet Size: 42" x 30"
Not For Construction



BAY SPACE

Usable Square Foot Analysis

Office Area	3,899	100 %
Warehouse Area	0	0%
Total Area	3,899	

Building Information

Deck Height:	13' - 3"
Clear Height:	8' - 9 1/2"
Ceiling Height:	7' - 5 1/2"
Sprinklered:	<input checked="" type="checkbox"/> Yes <input type="checkbox"/> No
Mechanical Area:	0 SQFT

