


7/15/2025 3:54:53 PM  
 C:\Global Mapper Maps\ECAP\Quinn Building LLC (Wallis Walls, WA)\47 E Main St\As-Built\47 E Main

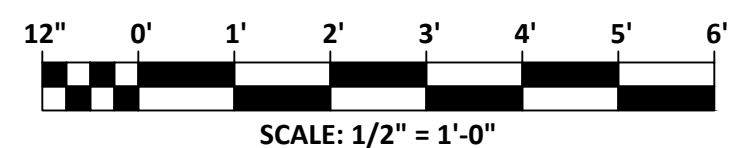



# 47 E MAIN STREET MAIN FLOOR

7/15/2025

		<h2>A1</h2>
Project	47 E Main St	
Date	7/15/2025	
Scale	1/2" = 1'-0" @ Ansi D	

D:\Global Mapper Maps\EGP\Quinn Building LLC (Wallis Wallis, WA)\47 E Main St As-Built\47 E Main

7/15/2025 3:54:53 PM

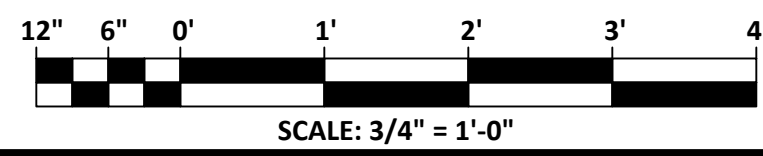
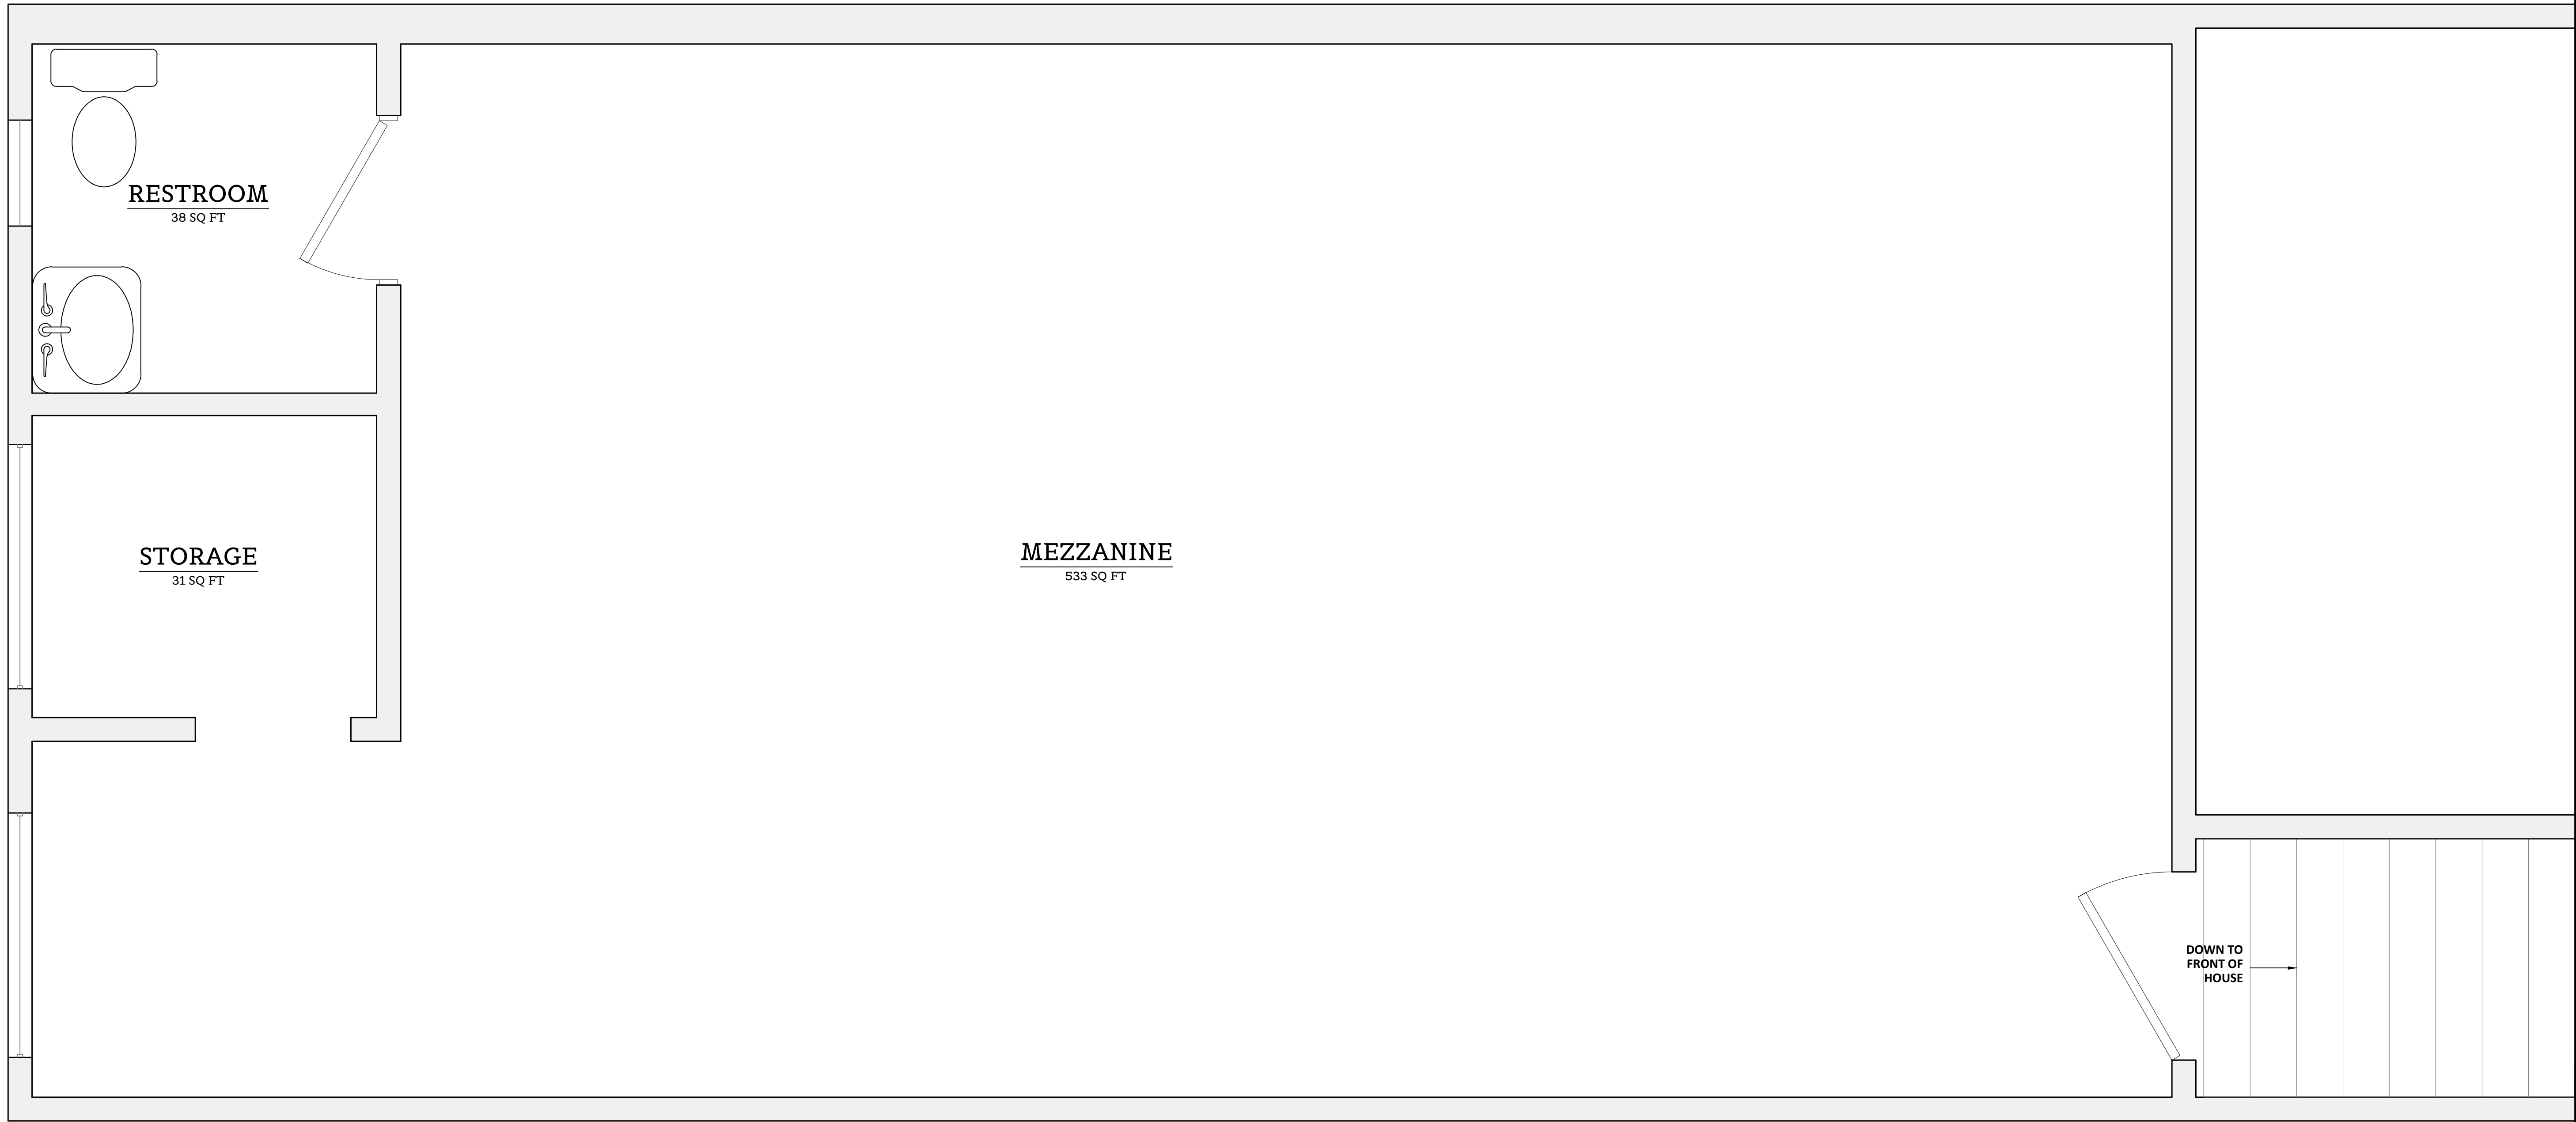


# 47 E MAIN STREET MEZZANINE


7/15/2025



Project	47 E Main St	Sheet <b>A2</b>
Date	7/15/2025	
Scale	1:16 @ Ansi D	

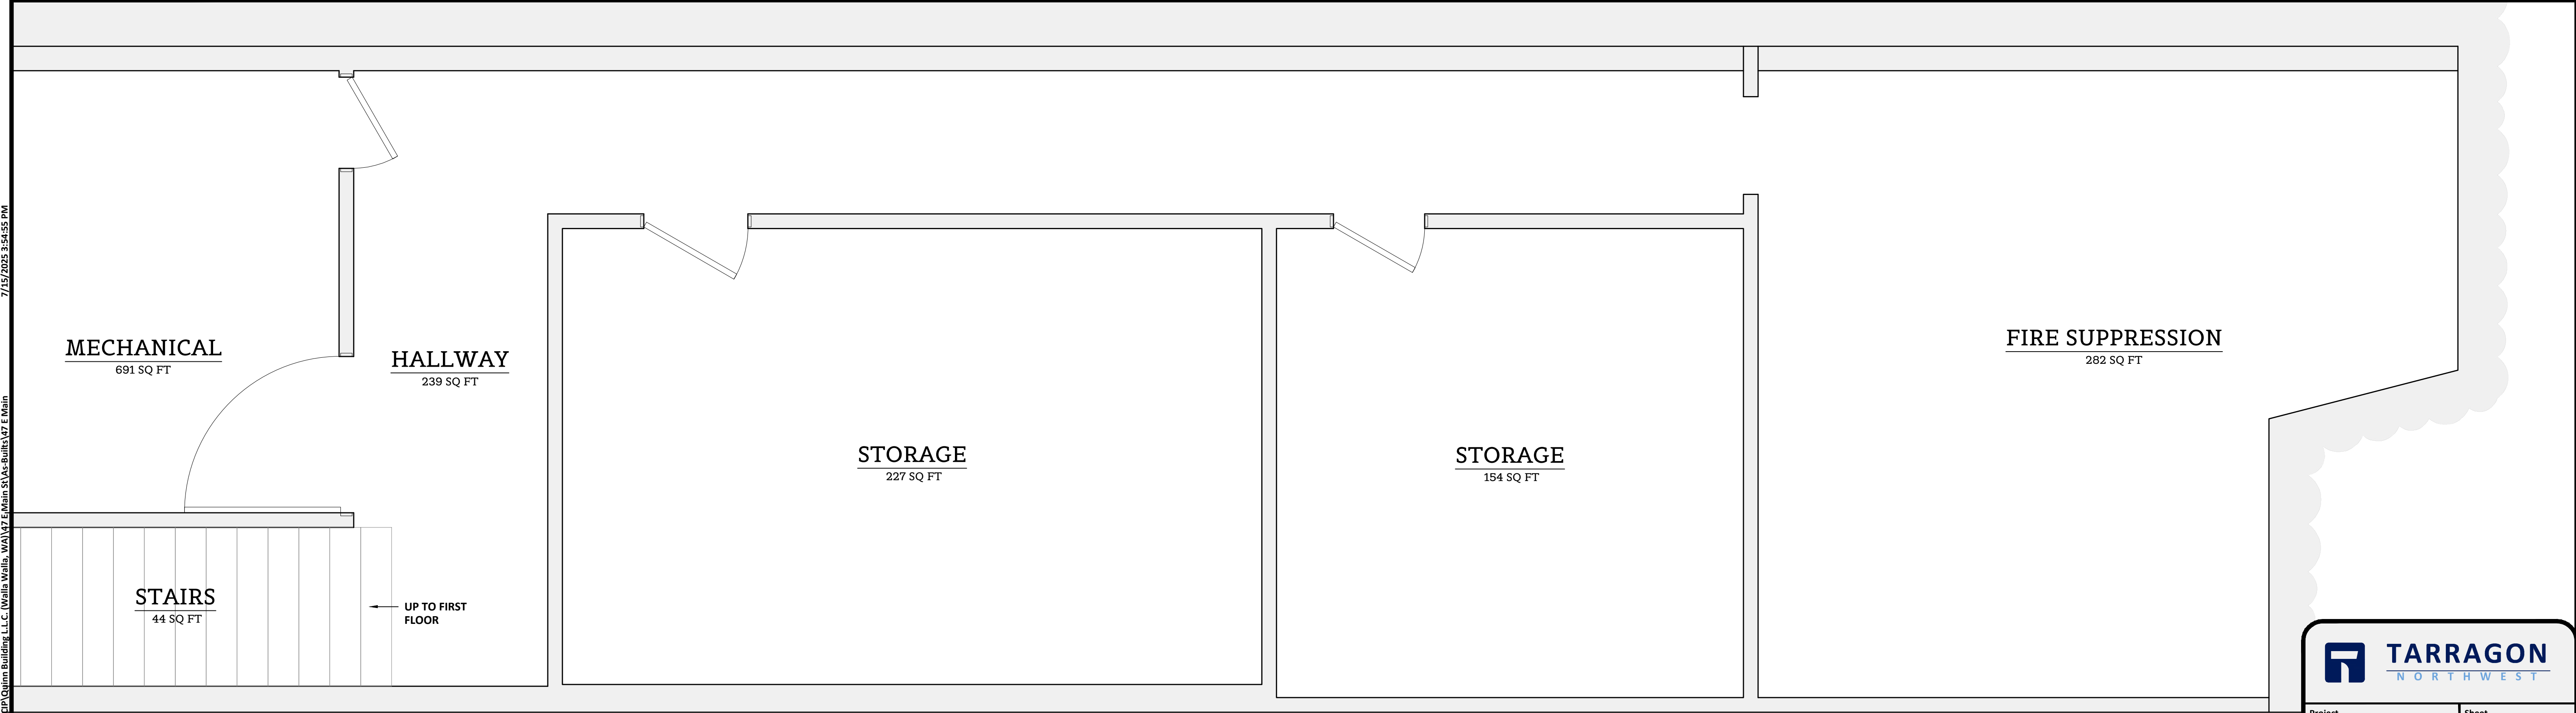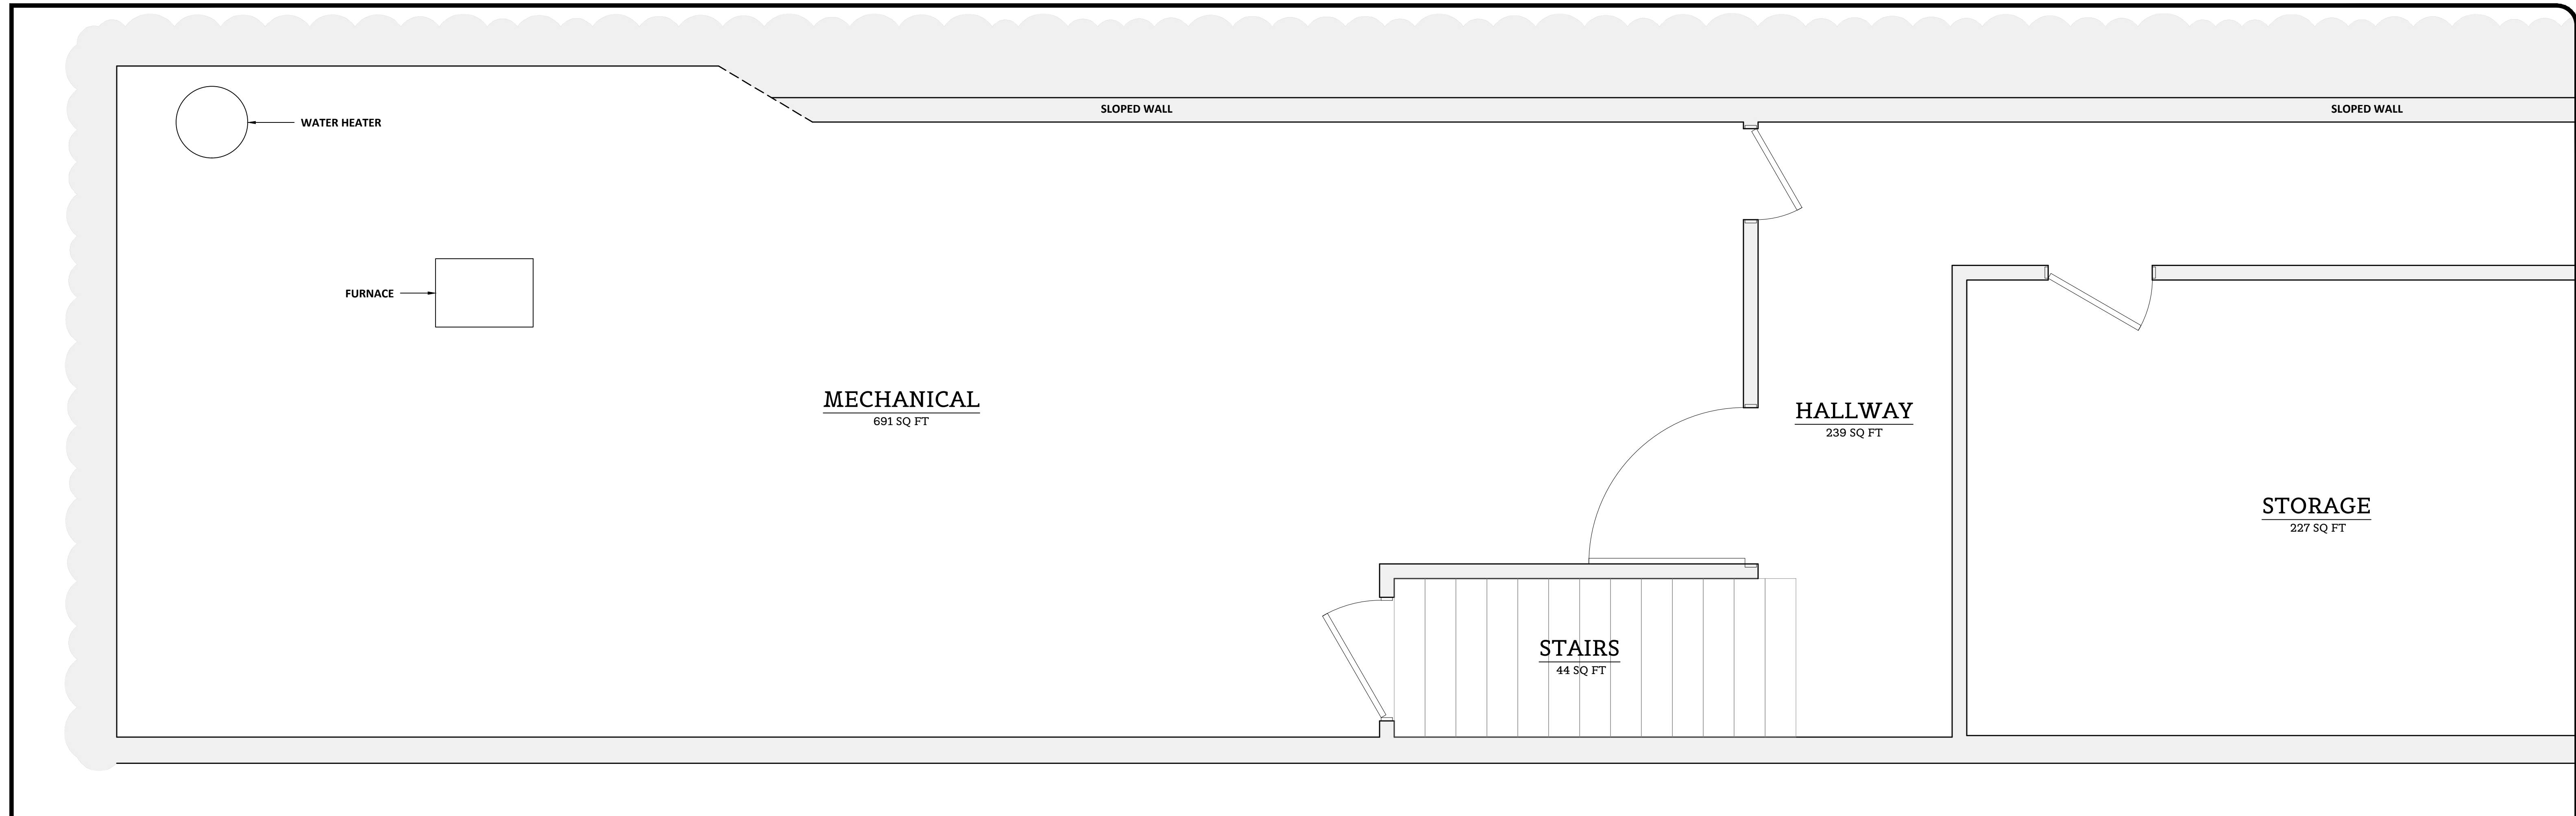

7/15/2025 3:54:55 PM  
D:\Global Mapper Maps\EGP\Qghm Building L.L.C. (Wallis Walls, WA)\47 E Main St\As-Built\47 E Main

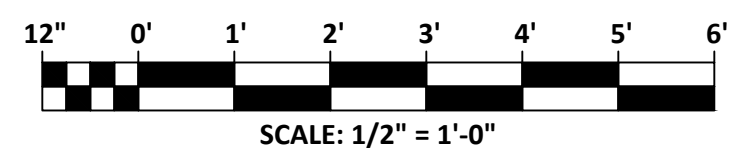

SCALE: 1/2" = 1'-0"

**47 E MAIN STREET BASEMENT**

7/15/2025

		<b>A3</b>
Project	47 E Main St	
Date	7/15/2025	
Scale	1/2" = 1'-0" @ Ansi D	