




Bik 11
PINE TRAILS, SECTION 1
Vol. 232, Pg. 1

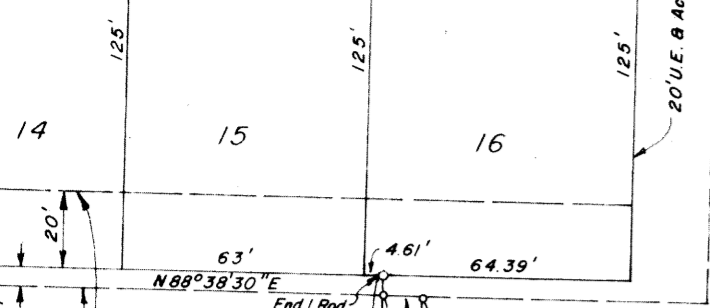

25' U.E. B Access Esmt. Dedicated By Plat Of Pine Trails, Section 1 Vol. 232, Pg. 1

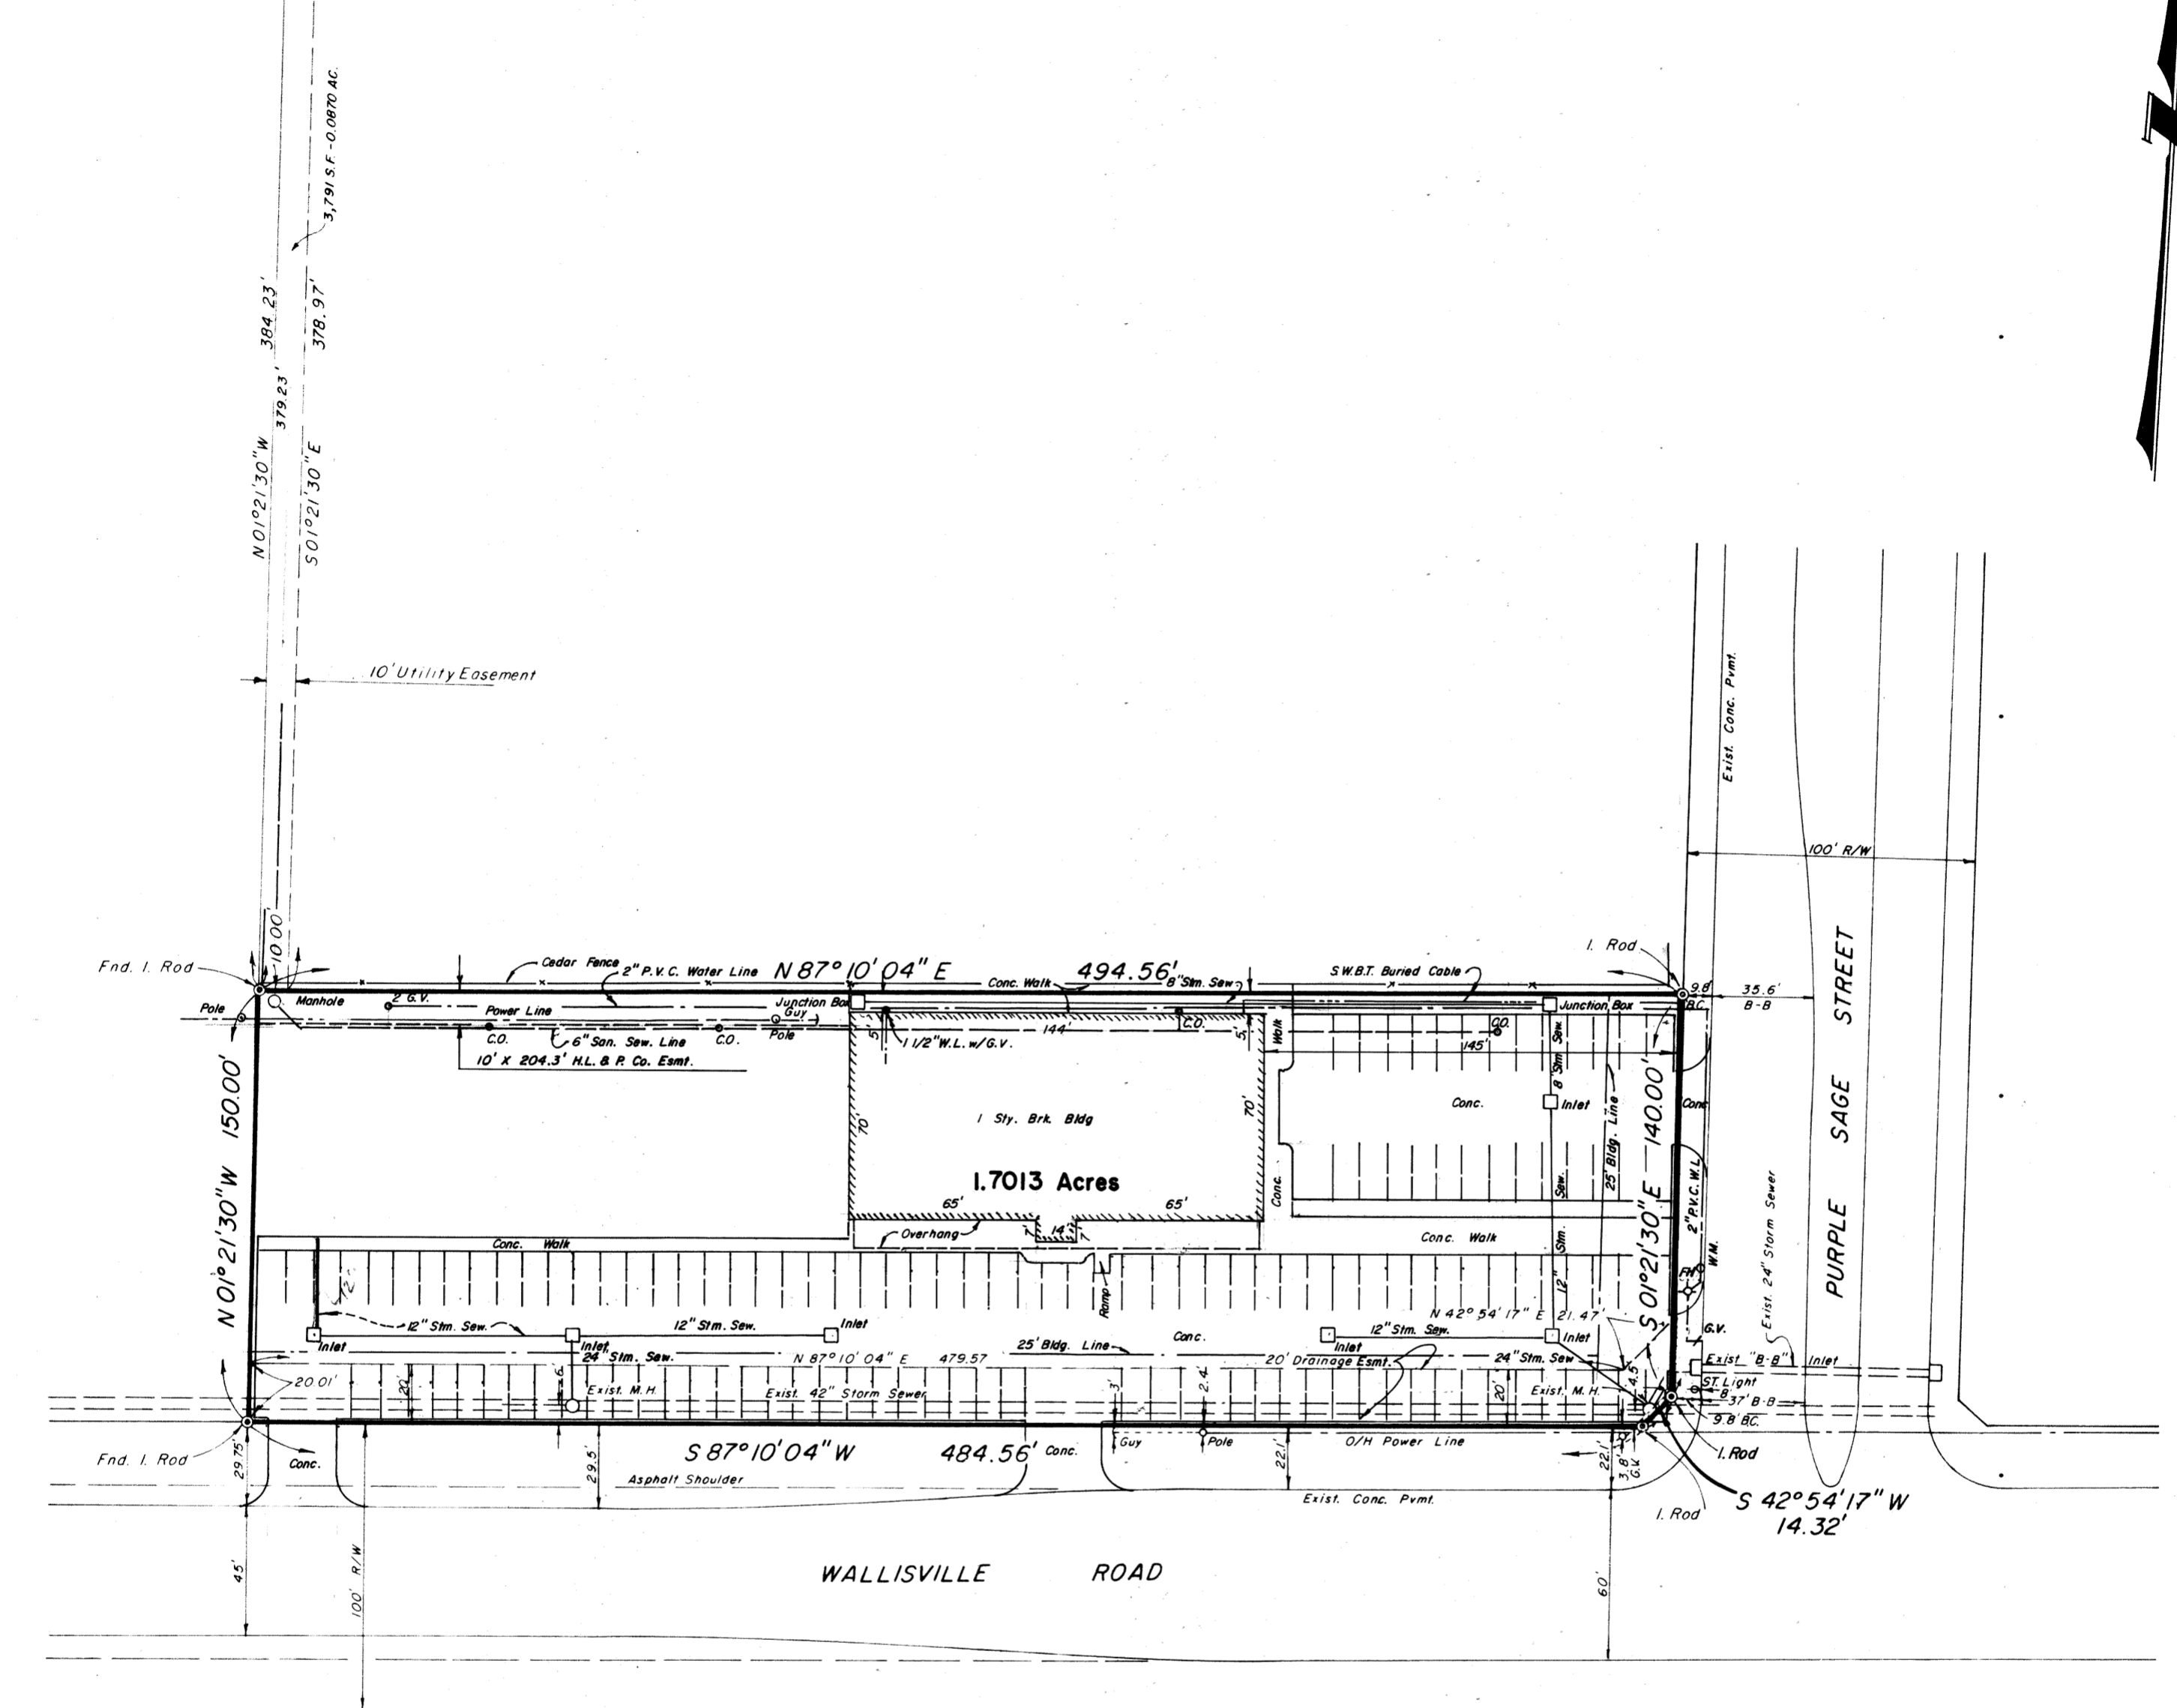

AS BUILT SURVEY OF 1.7013 ACRES
OF LAND IN THE J. ERWIN SURVEY
ABSTRACT NUMBER 257, HARRIS COUNTY, TEXAS.

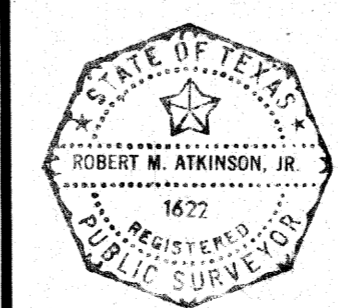

R.M. ATKINSON, JR., ENGINEERS, INC.
Consulting Engineers — Land Surveyors
15425 N. Freeway, Suite 140, Houston, Texas 77090
Members A.S.C.E.

BY: *Robert M. Atkinson, Jr.*
REGISTERED PUBLIC SURVEYOR

SCALE: 1" = 50' DATE: JAN. 25, 1990 DRAWN BY: R.M.A. FILE NO. 4022