

# OFFICE DEPOT - SPRINGDALE

11711 PRINCETON PIKE SUITE 971  
 SPRINGDALE, OH 45246  
 AS-BUILTS




BIM DUDE  
 AREYNOLDS@BIMDUDE.DESIGN

PROJECT:  
 SPRINGDALE OFFICE DEPOT  
 AS-BUILT

CONSULTANTS:

### ARCHITECTURAL

A0-0	COVER
A0-01	AREA PLANS
A1-01	LEVEL 1 - FLOOR PLAN
A2-01	LEVEL 1 - RCP
A3-01	ELEVATIONS

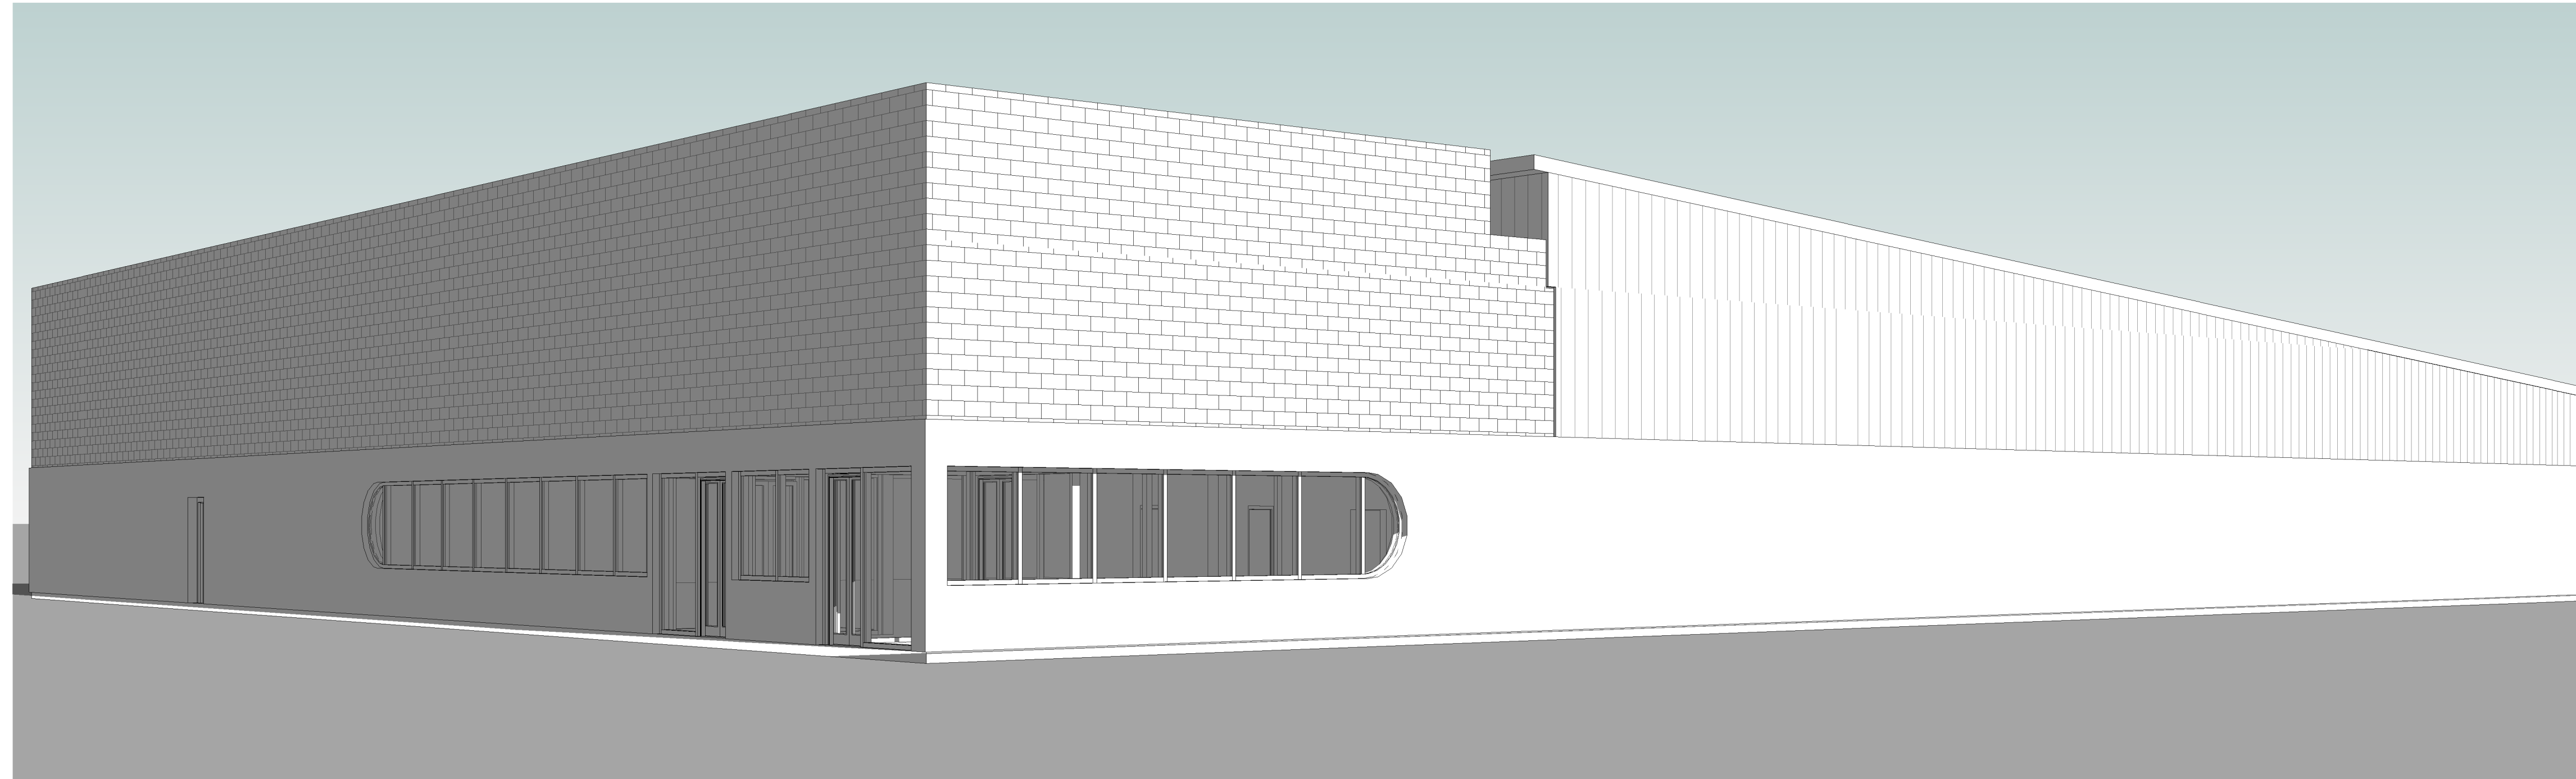

### BUILDING INFO


AS-BUILT MEASUREMENTS TOOK PLACE  
 ON 02/24/2025

ADDRESS:  
 11711 PRINCETON PIKE SUITE 971  
 SPRINGDALE, OH 45246

EXTERIOR WALLS:  
 CMU

INTERIOR WALLS:  
 METAL FRAMING

### BUILDING LOCATION

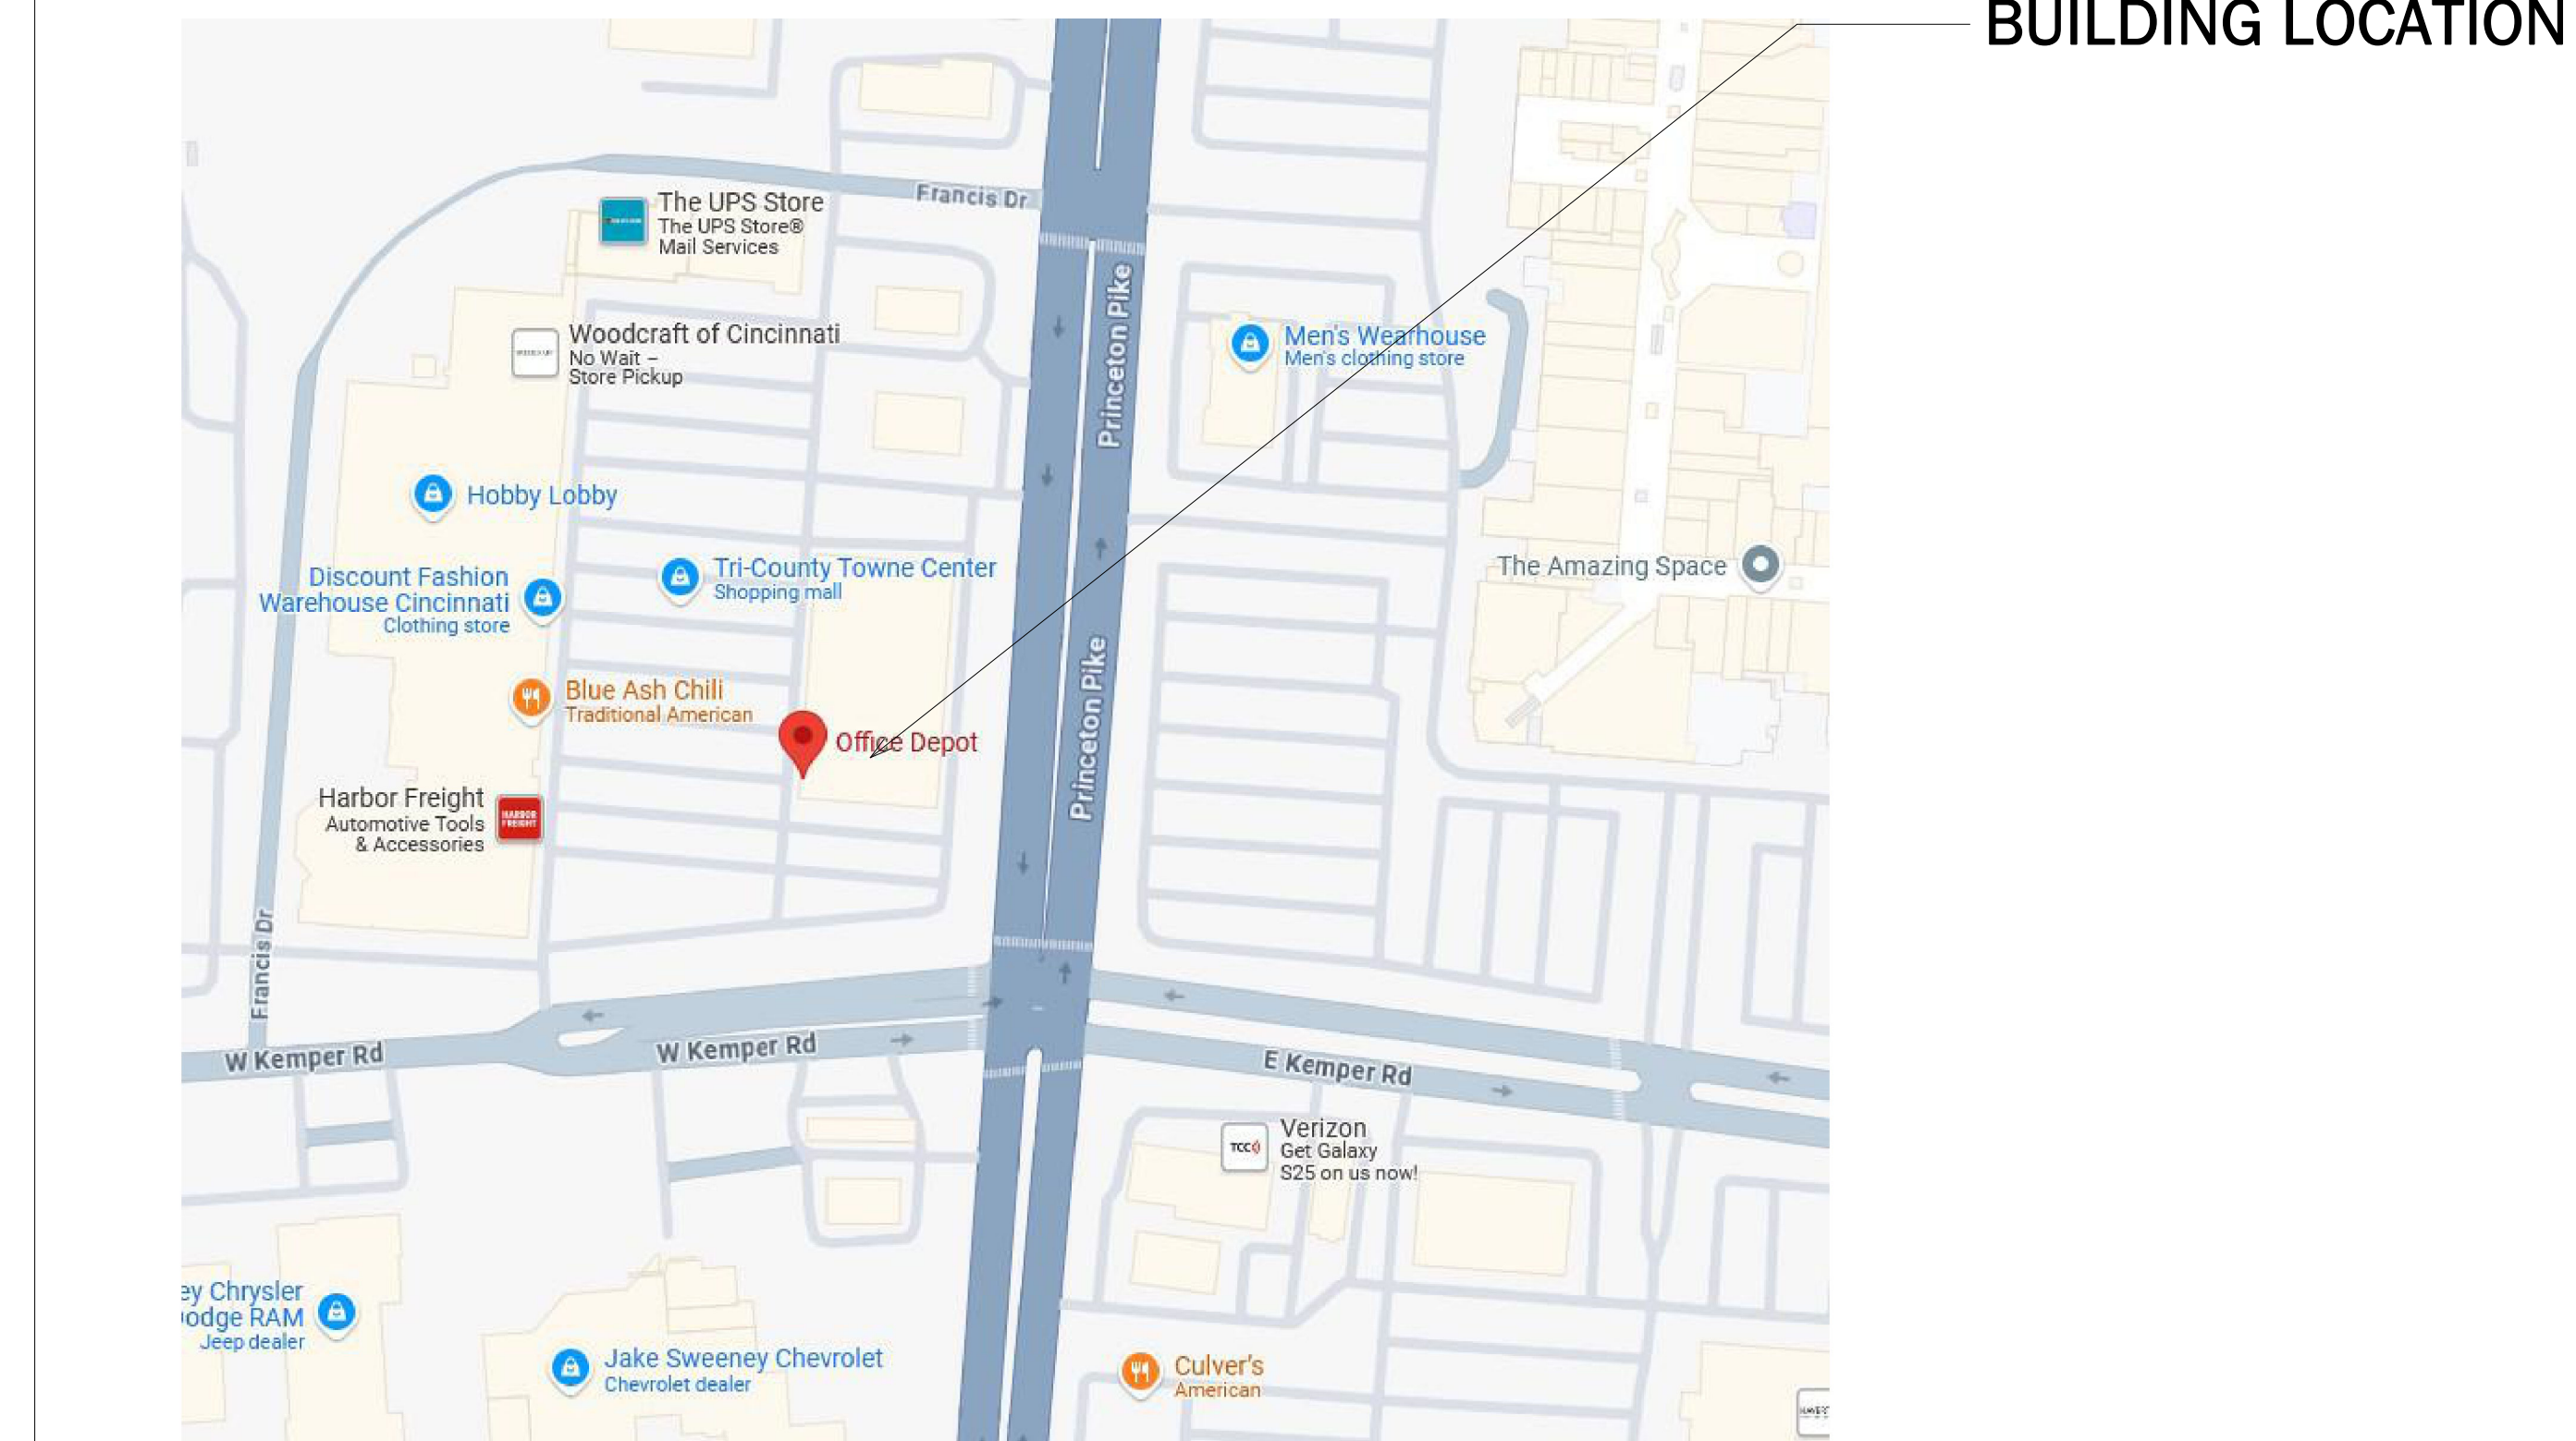

BUILDING LOCATION

### EXISTING CONDITIONS

SCALE:	DATE:	
DRAWN BY:	CHECKED BY:	
AR	AR	
NO.	REVISION:	DATE:

SHEET TITLE:  
 COVER


PROJECT NO.  
 2508-1

SHEET NO.  
 A0-0

EXISTING  
CONDITIONS

SCALE: As indicated	DATE: 3/3/25	
DRAWN BY: AR	CHECKED BY: AR	
NO.	REVISION:	DATE:

SHEET TITLE:  
AREA PLANS

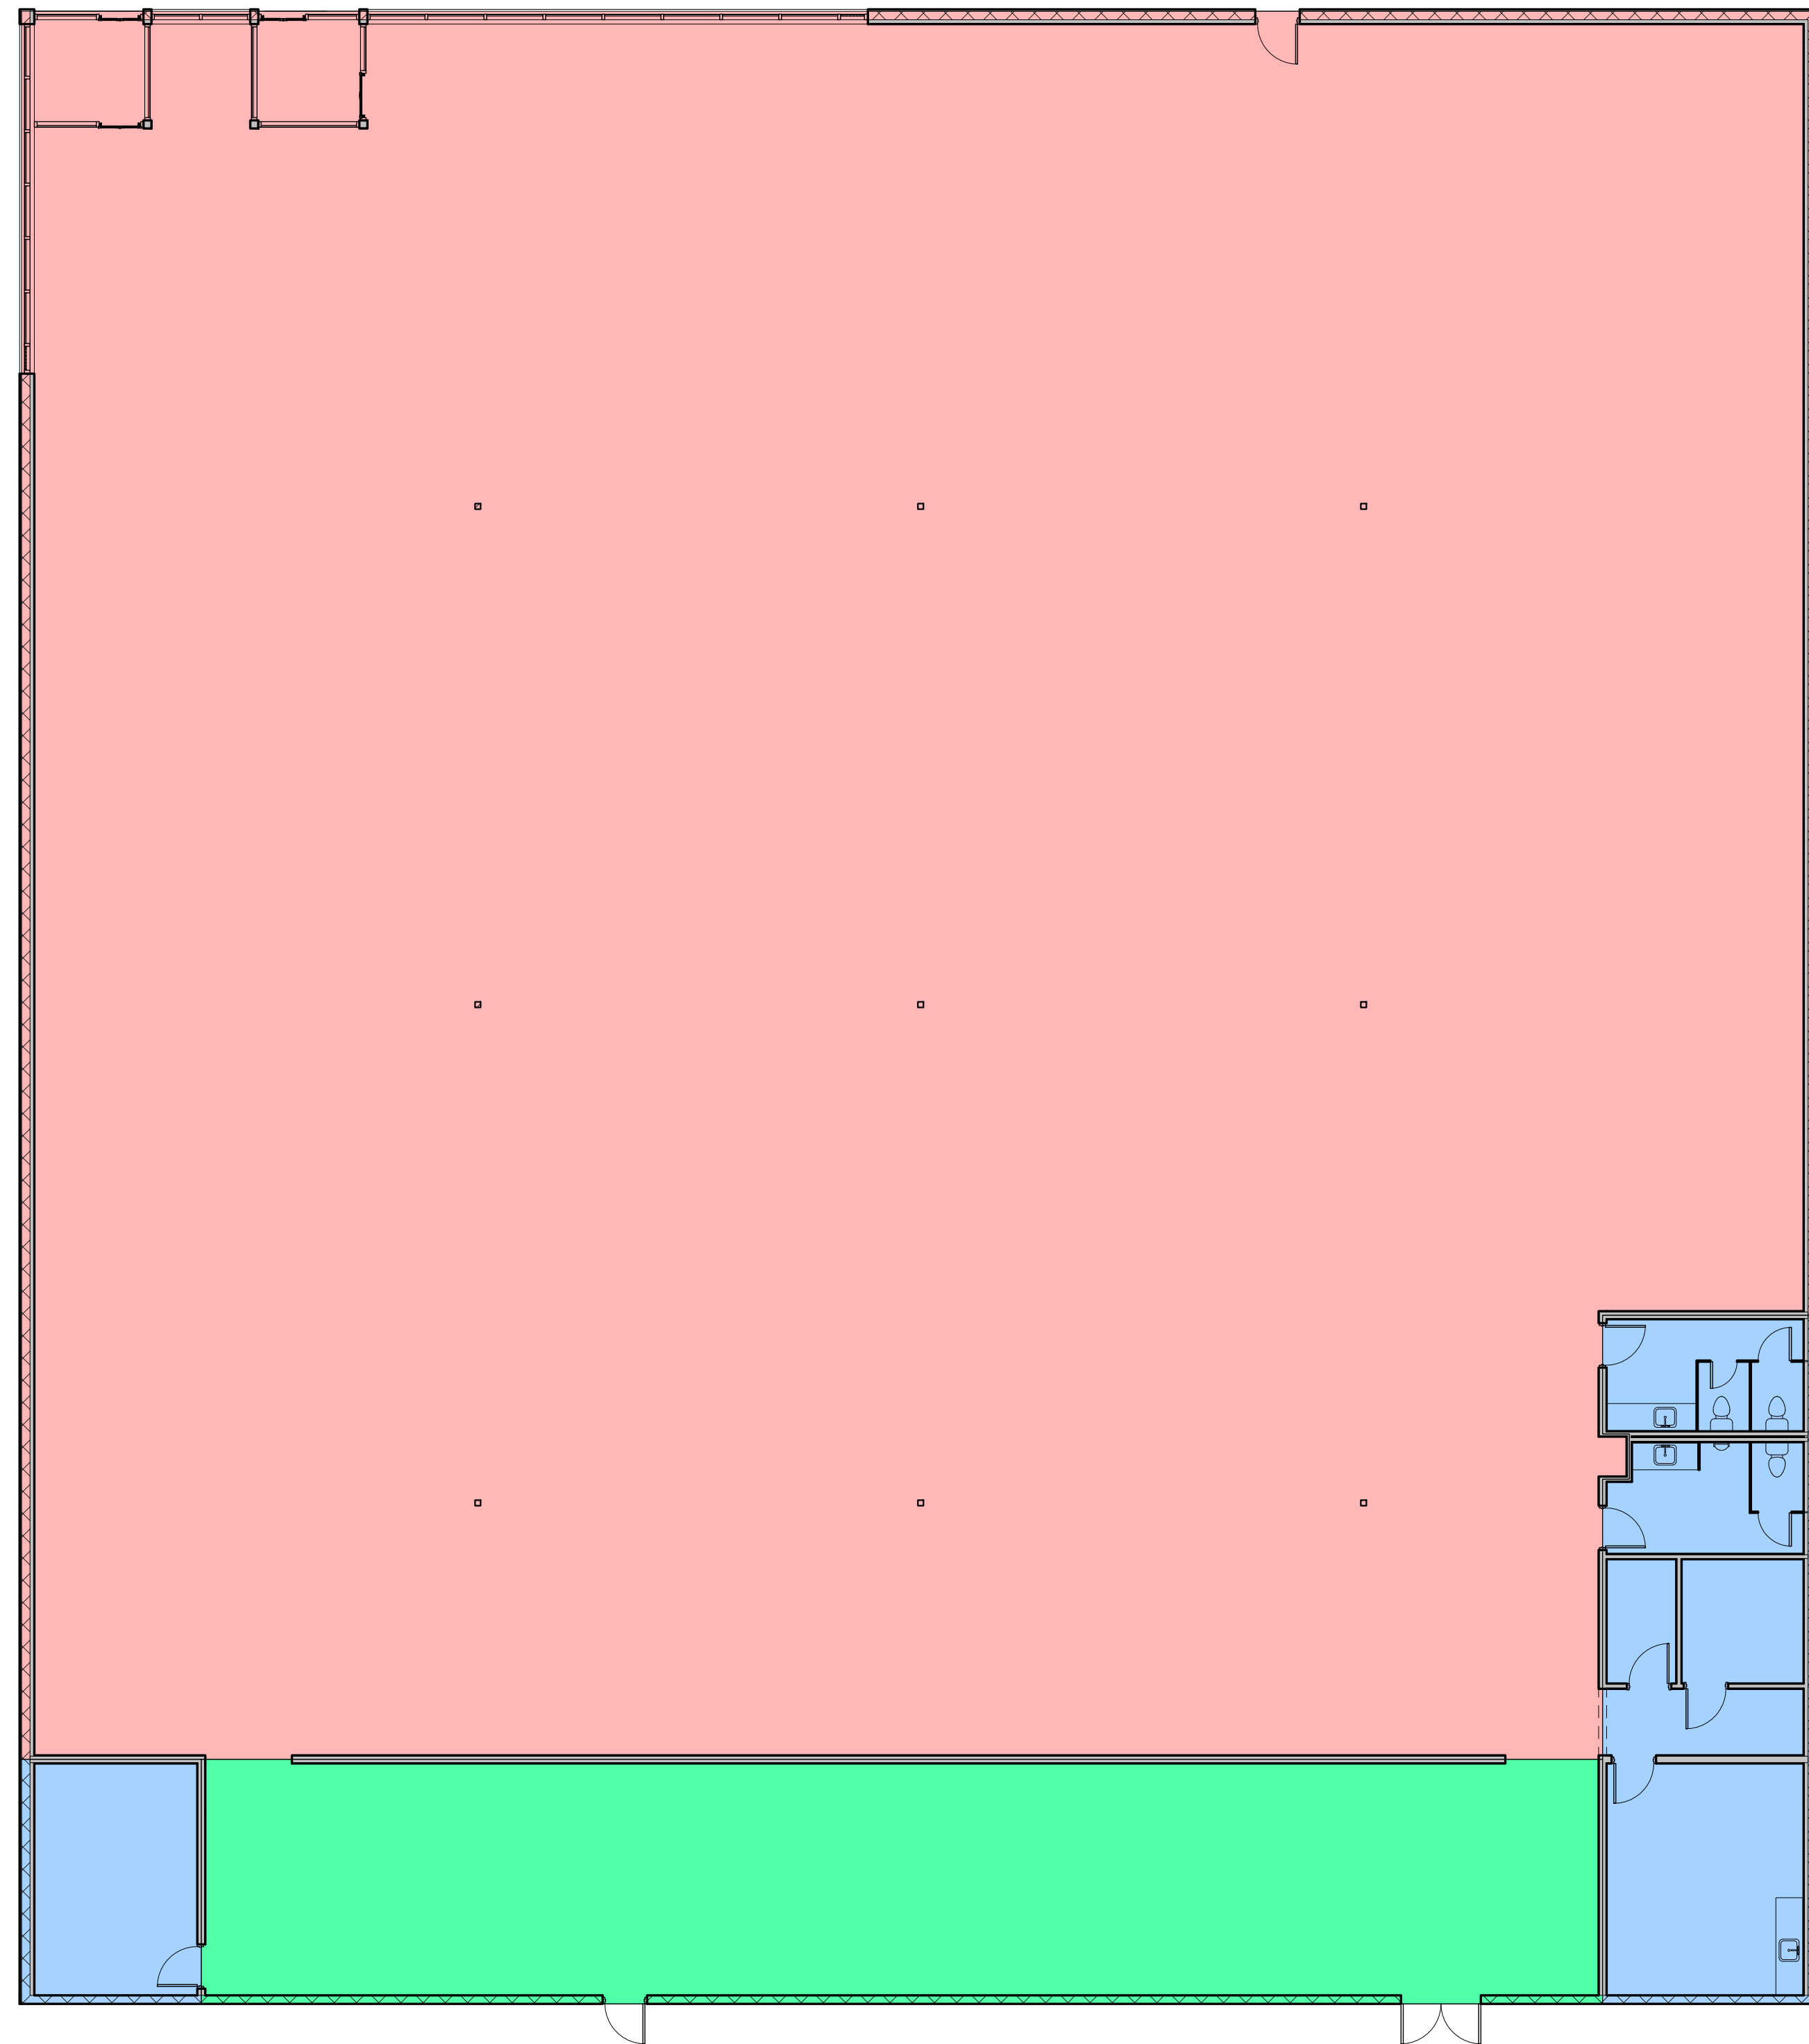

① LEVEL 1 AREA  
1" = 10'-0"

OFFICE DEPOT - SPRINGDALE		
	ROOM	SQ/FT
	RETAIL	17,163
	OFFICE	1,072
	WAREHOUSE	1,932
	TOTAL	20,167



BIM DUDE  
AREYNOLDS@BIMDUDE.DESIGN

PROJECT:  
SPRINGDALE OFFICE DEPOT  
AS-BUILT

CONSULTANTS:

SEAL:


EXISTING  
CONDITIONS

SCALE: 1/8" = 1'-0"	DATE: 3/3/25	
DRAWN BY: AR	CHECKED BY: AR	
NO.	REVISION:	DATE:

SHEET TITLE:  
LEVEL 1 - FLOOR  
PLAN

PROJECT NO.  
2508-1

SHEET NO.  
A1-01

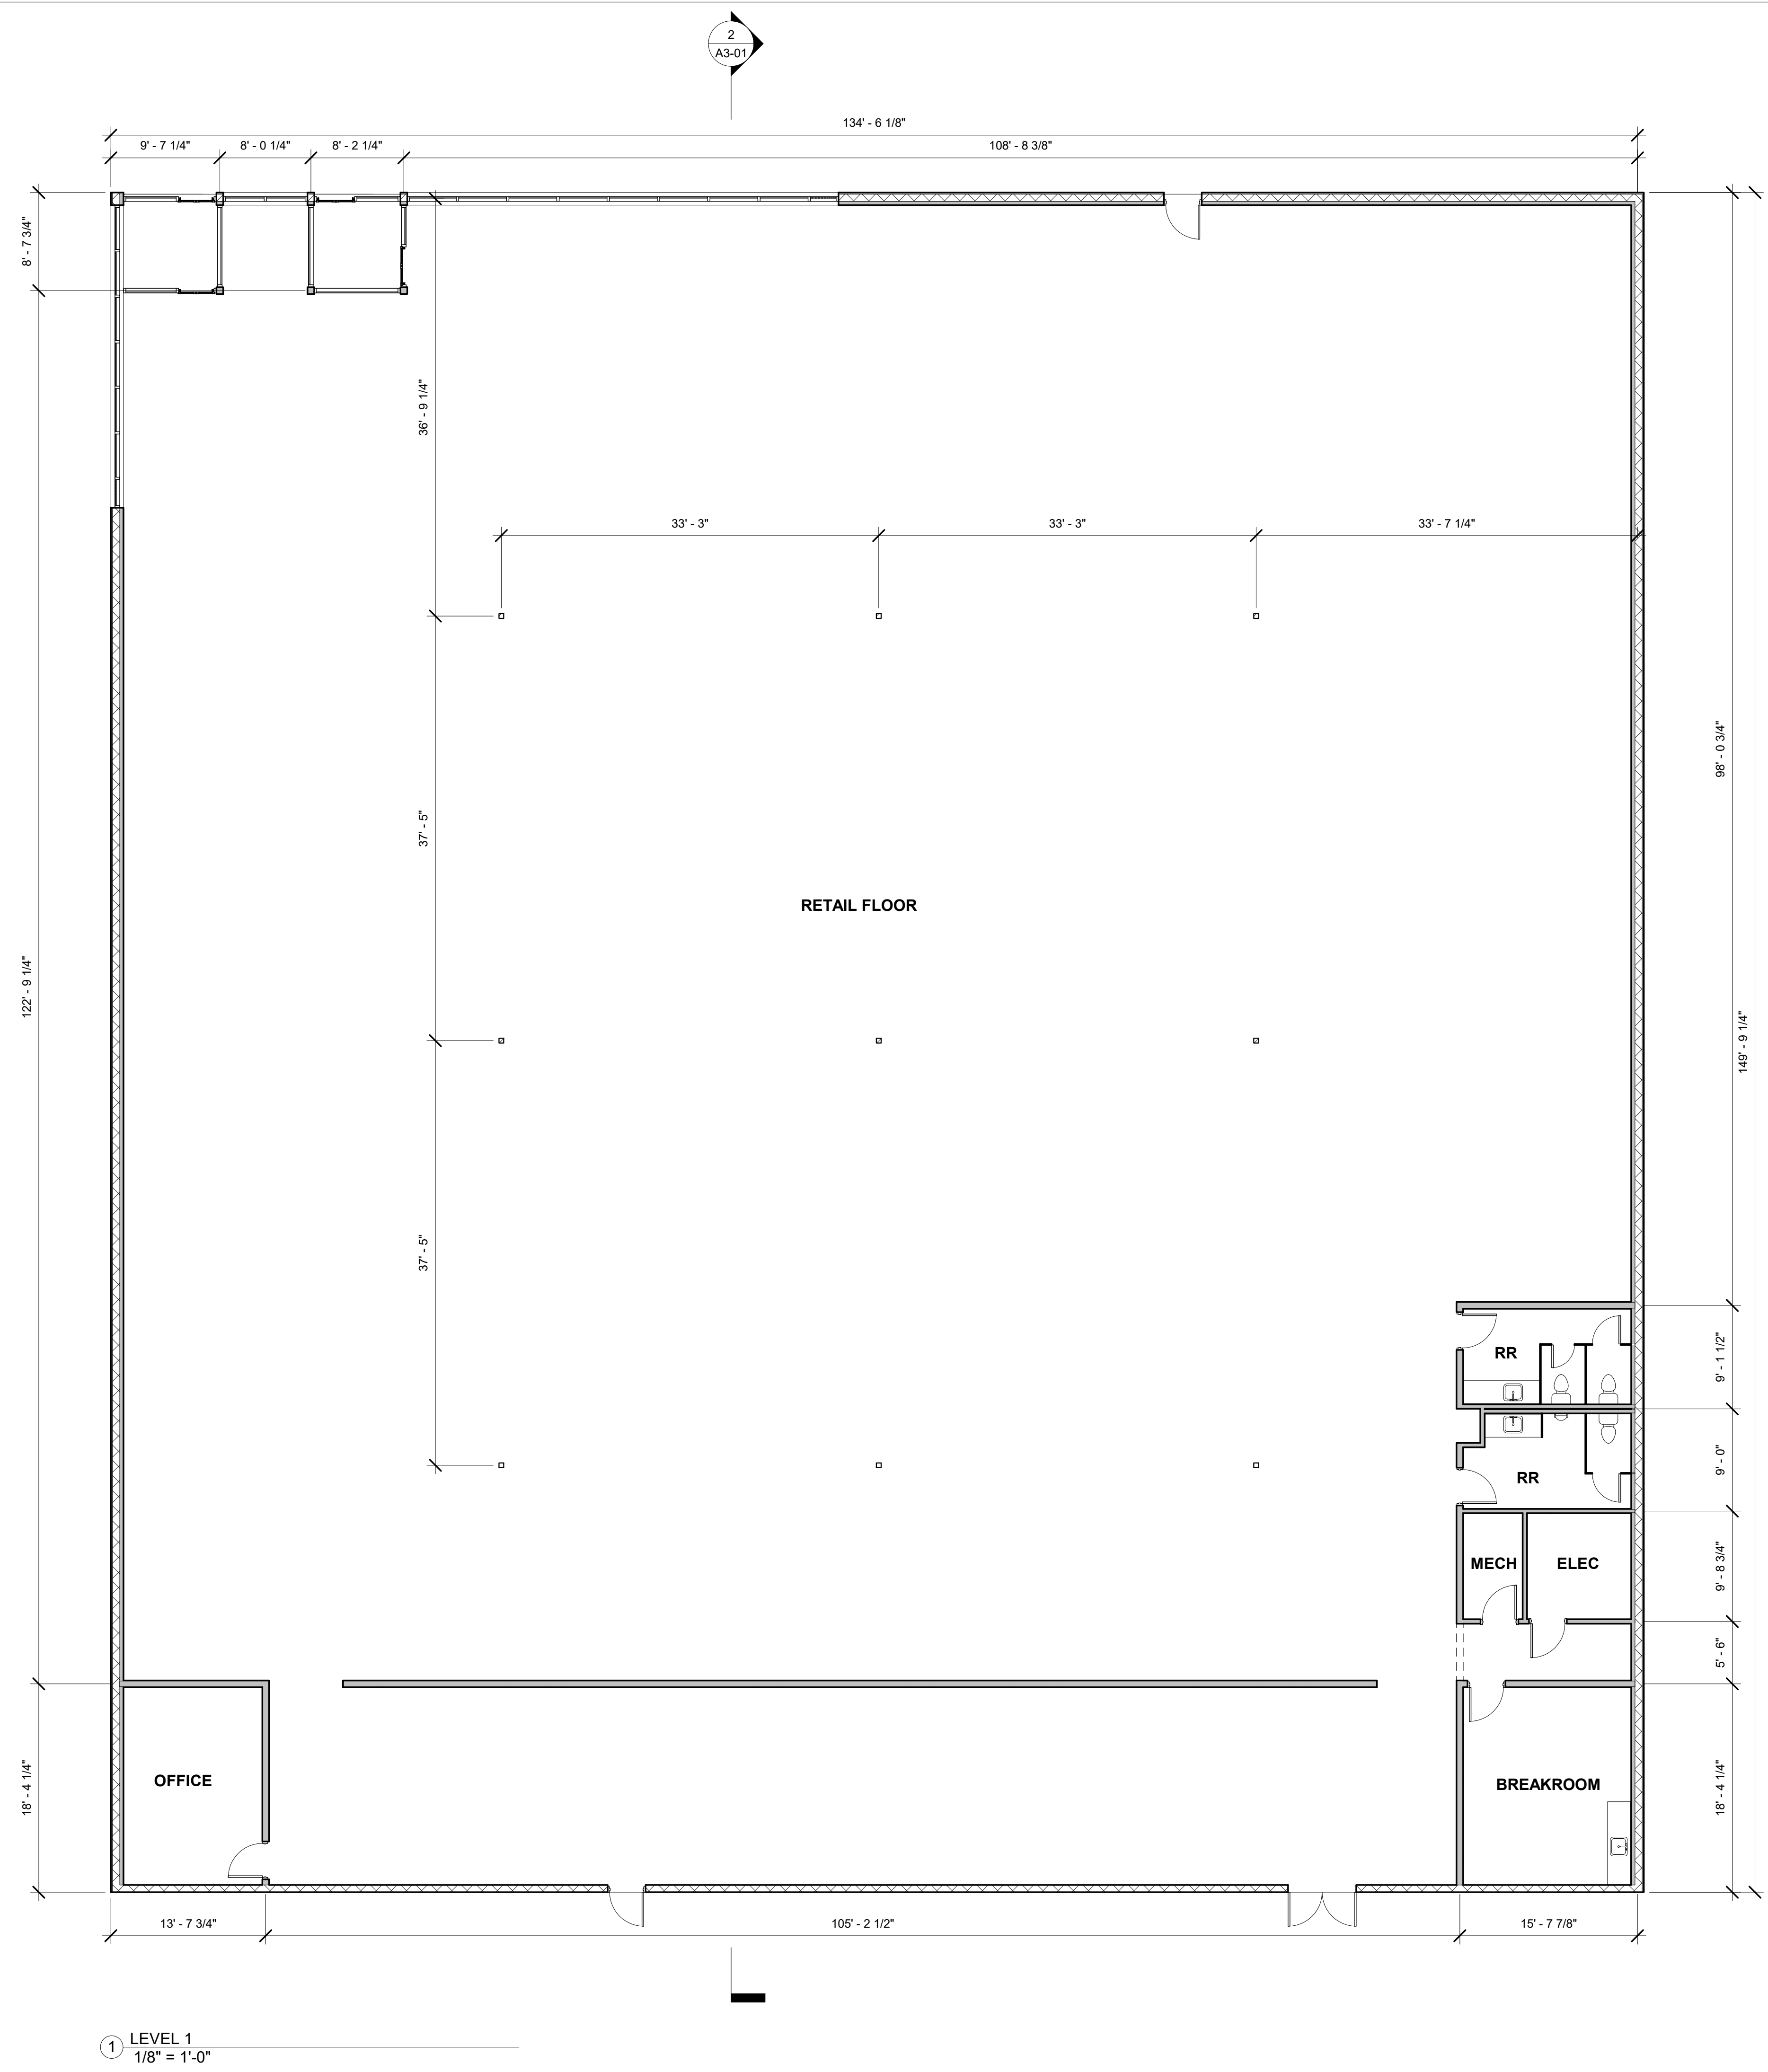

1 LEVEL 1  
1/8" = 1'-0"



BIM DUDE  
AREYNOLDS@BIMDUDE.DESIGN

PROJECT:  
SPRINGDALE OFFICE DEPOT  
AS-BUILT

CONSULTANTS:


SEAL:

### EXISTING CONDITIONS


SCALE: 1/8" = 1'-0"	DATE: 3/3/25	
DRAWN BY: AR	CHECKED BY: AR	
NO.	REVISION:	DATE:

SHEET TITLE:  
LEVEL 1 - RCP


PROJECT NO. 2508-1	SHEET NO. A2-01
-----------------------	--------------------

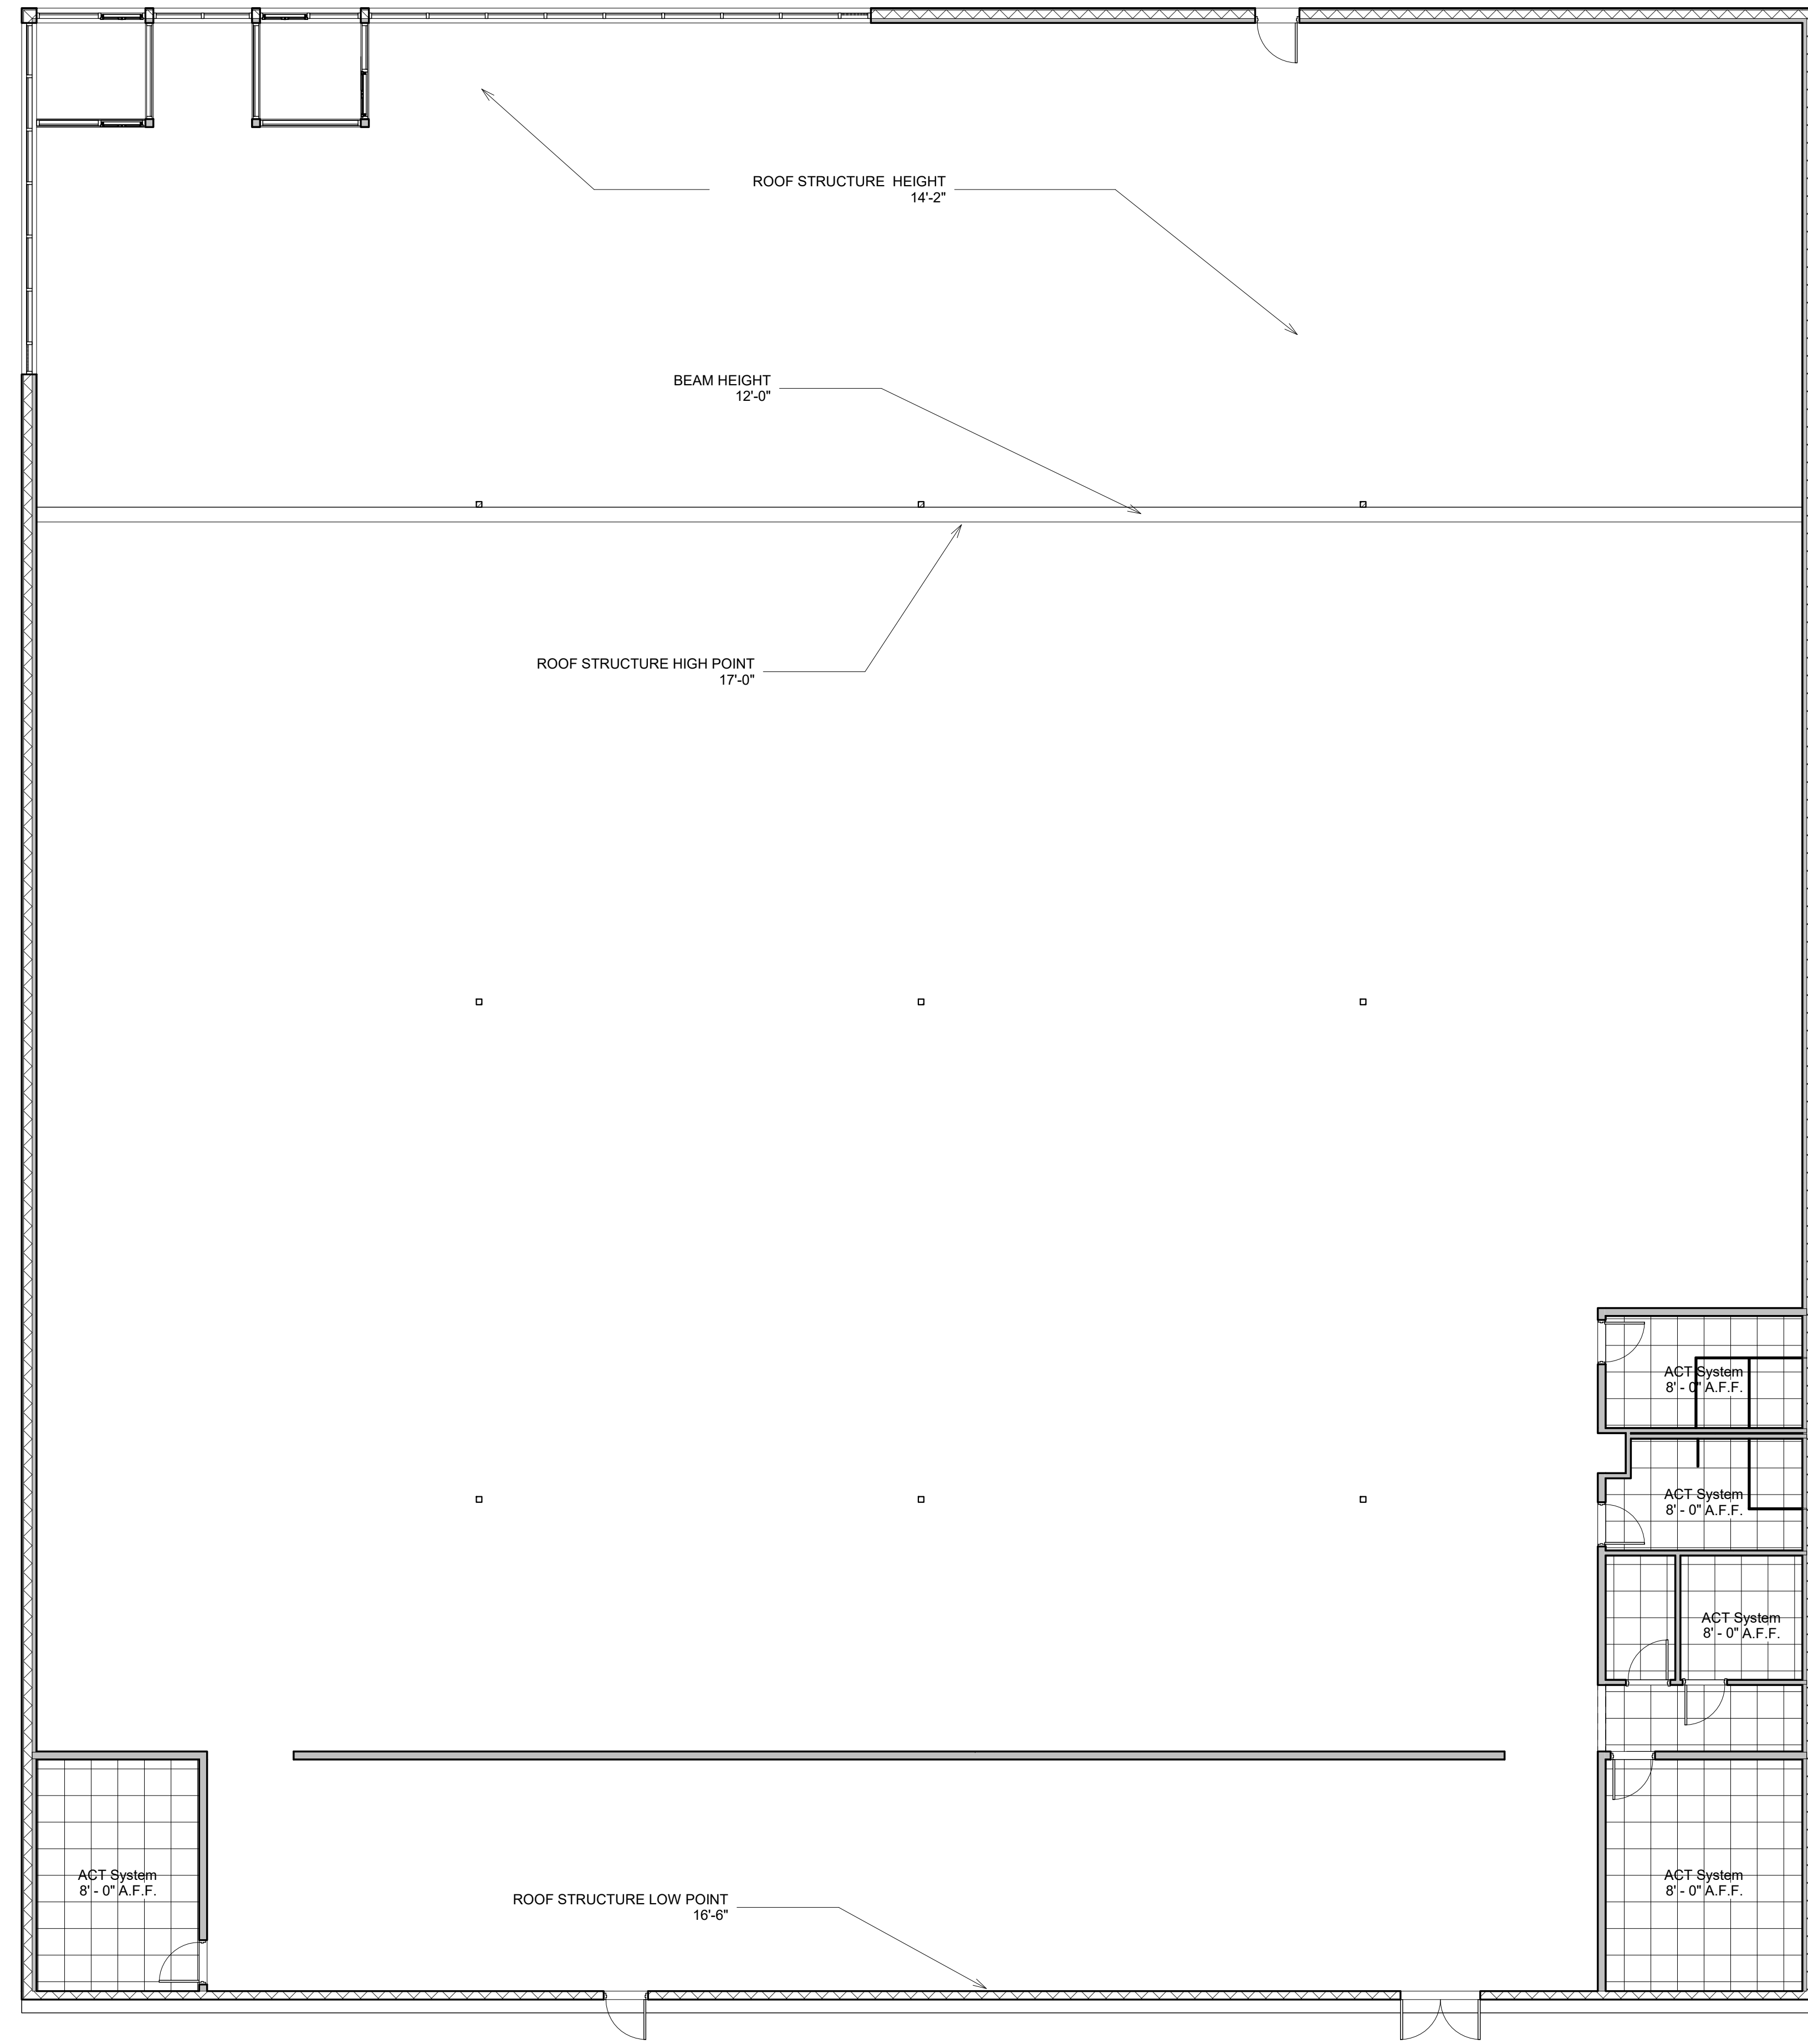


1 LEVEL 1 RCP  
1/8" = 1'-0"

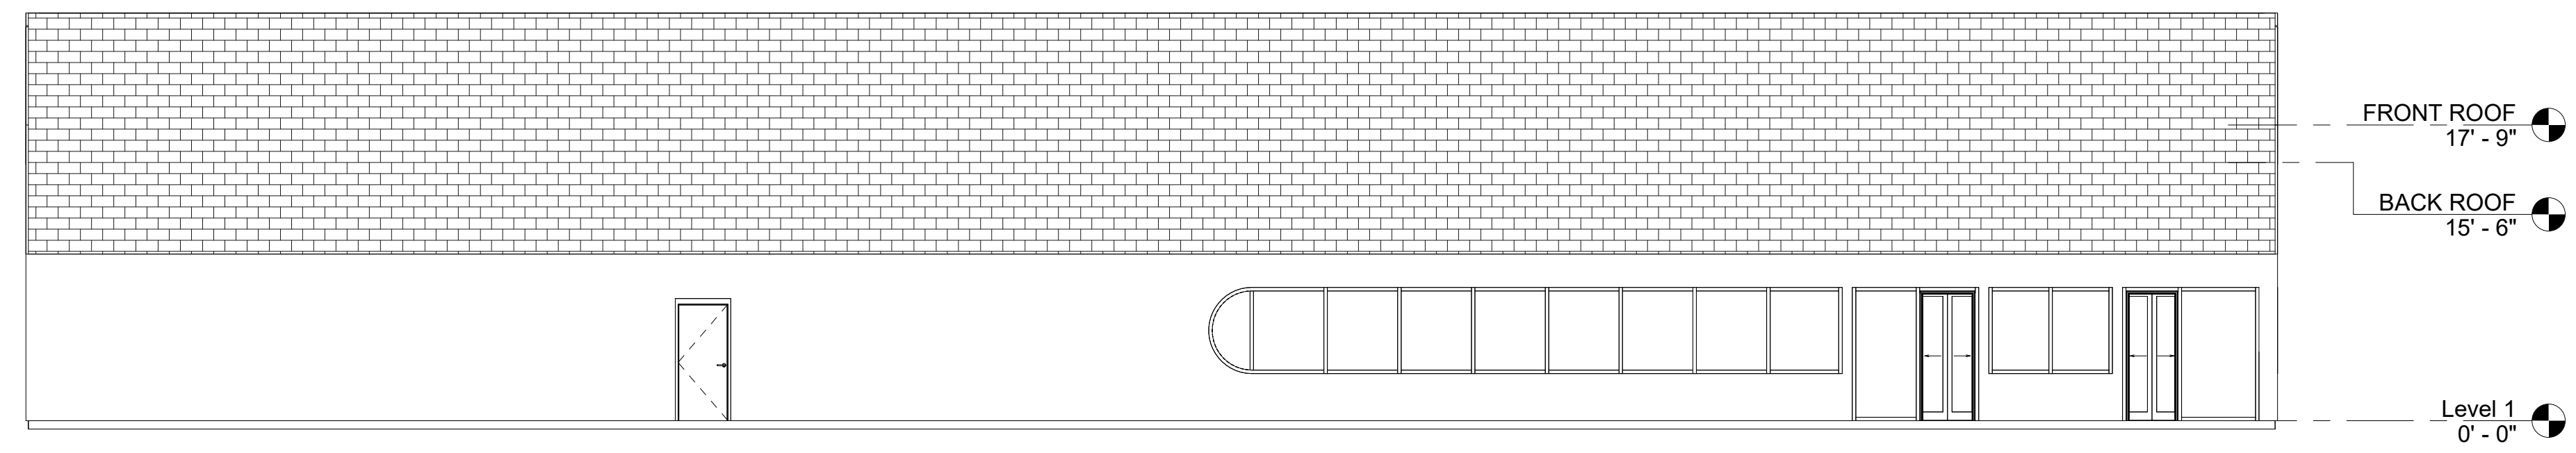

① FRONT ELEVATION  
1/8" = 1'-0"

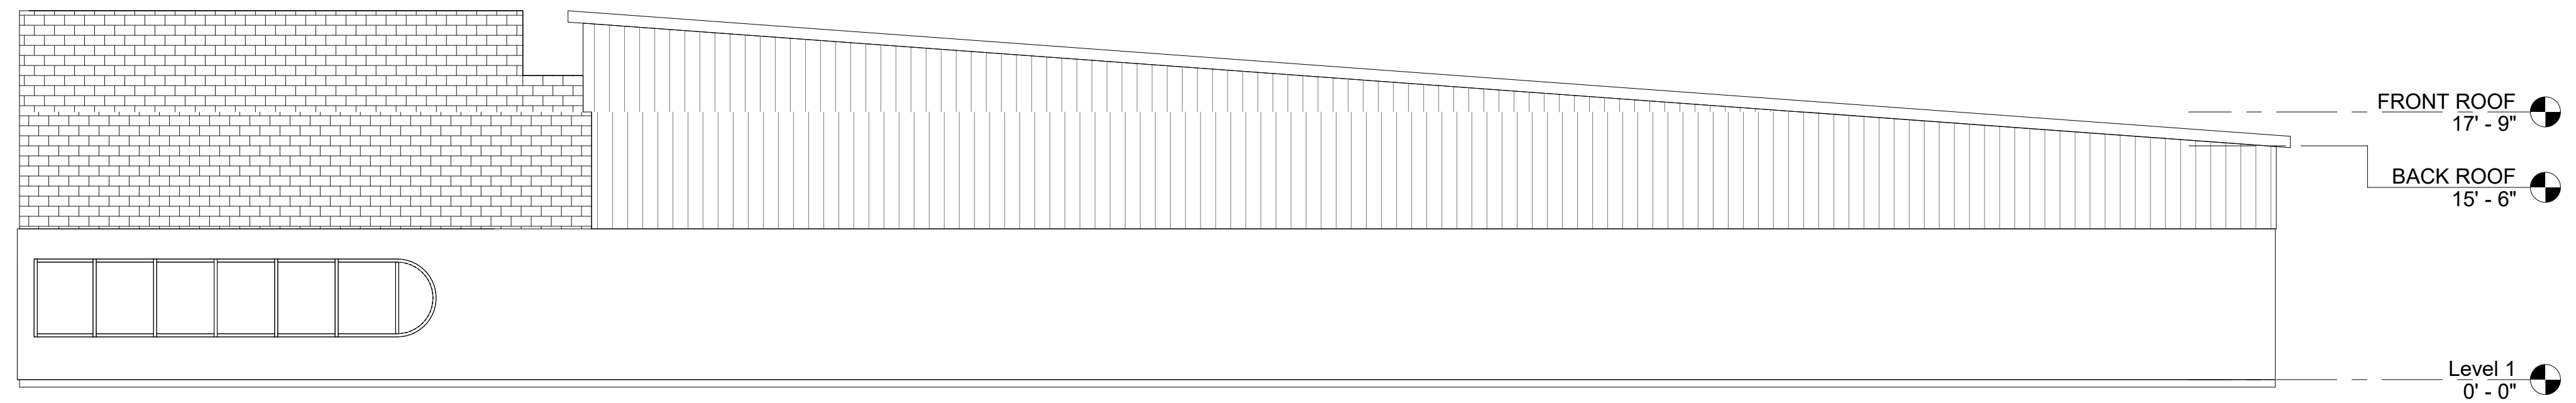

③ RIGHT SIDE ELEVATION  
1/8" = 1'-0"

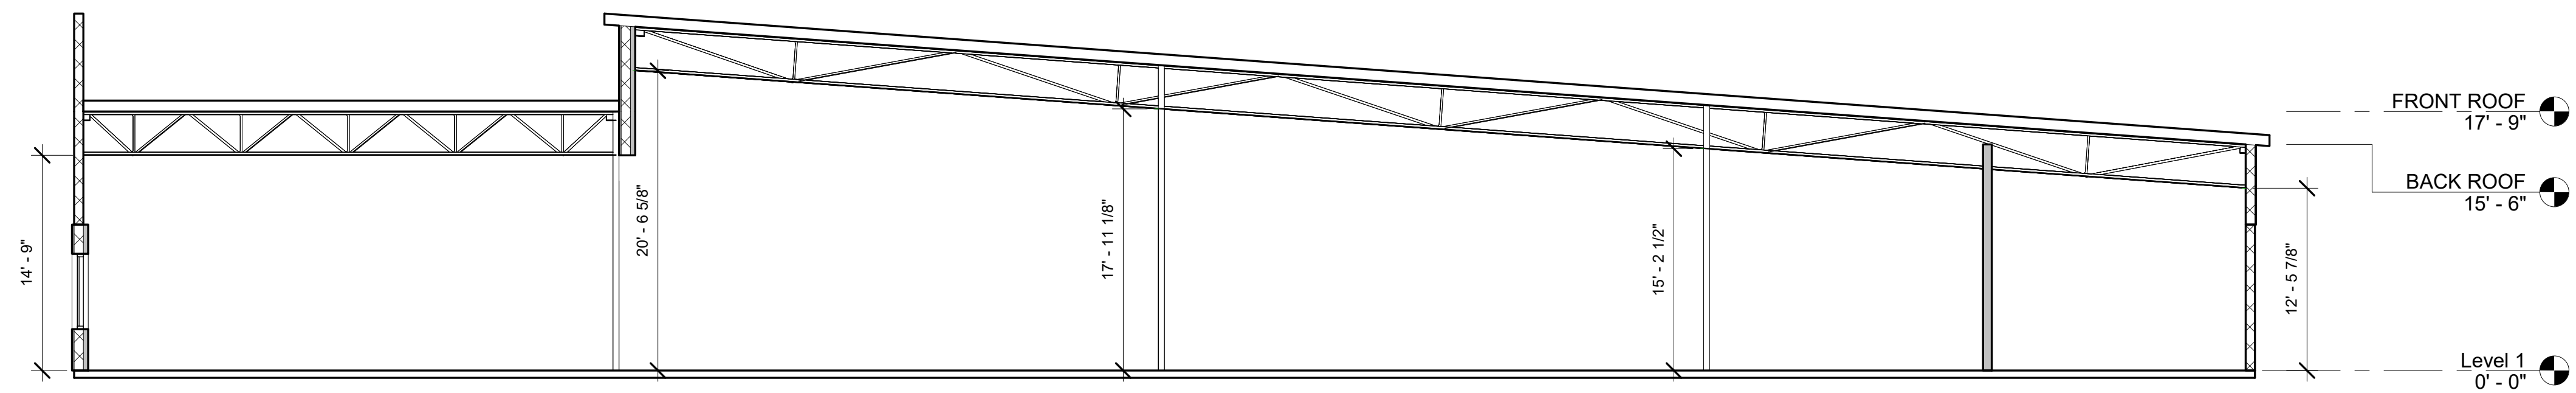

② BUILDING SECTION  
1/8" = 1'-0"