
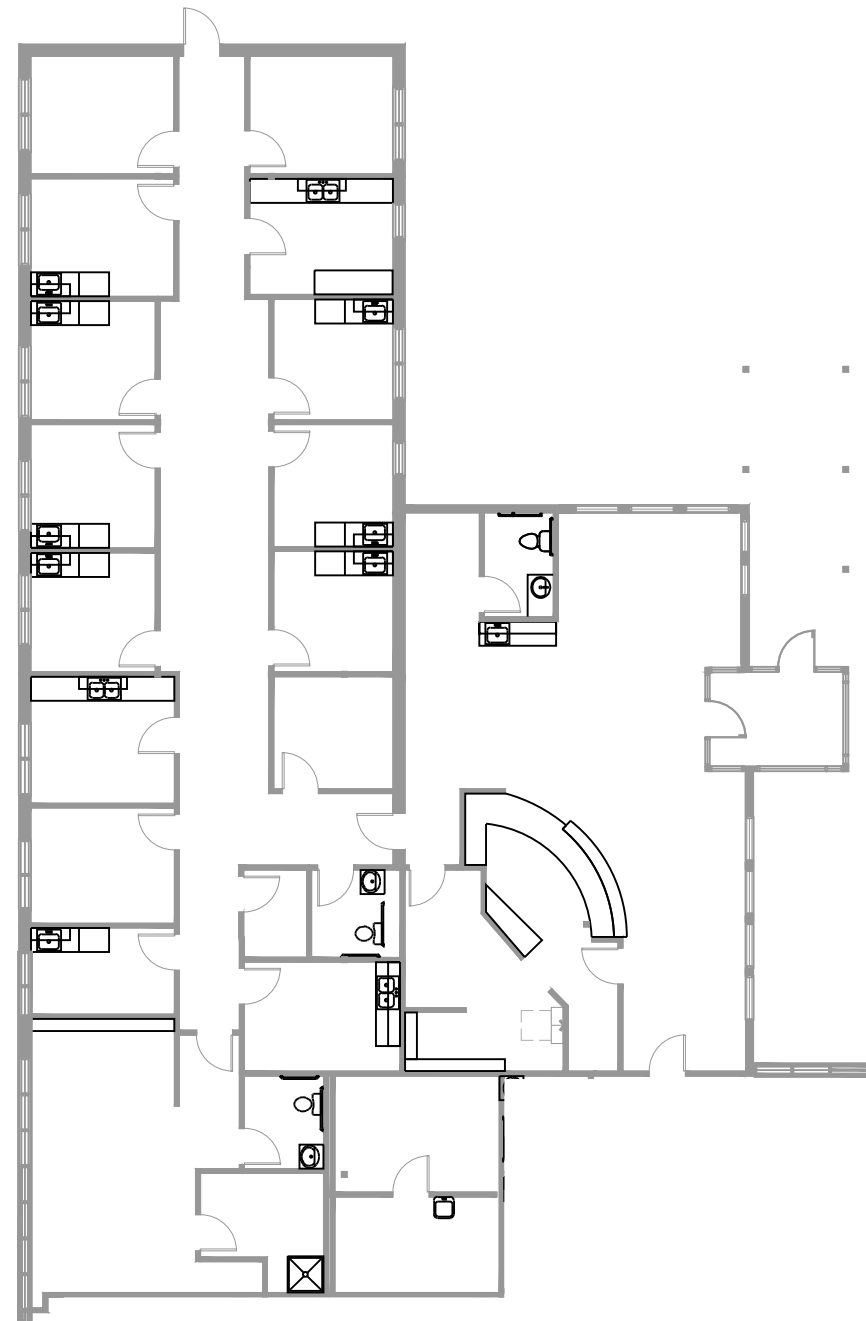


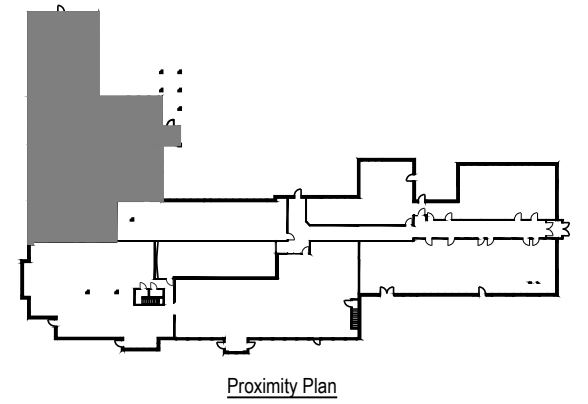

1

Reduced As-Built
 Suite 1
 5,939 RSF (Approx.)

Scale: 1/16" = 1'-0"

 North

1675 18th Ave

Concordia Building

As-Built Plan

Sheet 1 of 1

As-Built Plan
 Issued: 24July2026
 Drawn by: MCP / AT / AT
 TPS Project #:

Concordia Building
 Level One; Suite 1
 1675 18th Ave.
 Greeley, CO 80631

TPS
 1660 Lincoln St. Ste. 100
 Denver, Colorado 80264
 (303) 861-4800
 www.TPS.design