



SUITES 230 & 240

AS-BUILT - 1 OF 1  
CHARLOTTE PARK III  
8,933 TOTAL RSF  
SCALE: 1/16" = 1'-0"  
DATE: JANUARY 8, 2024

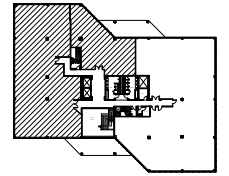

KEY PLAN

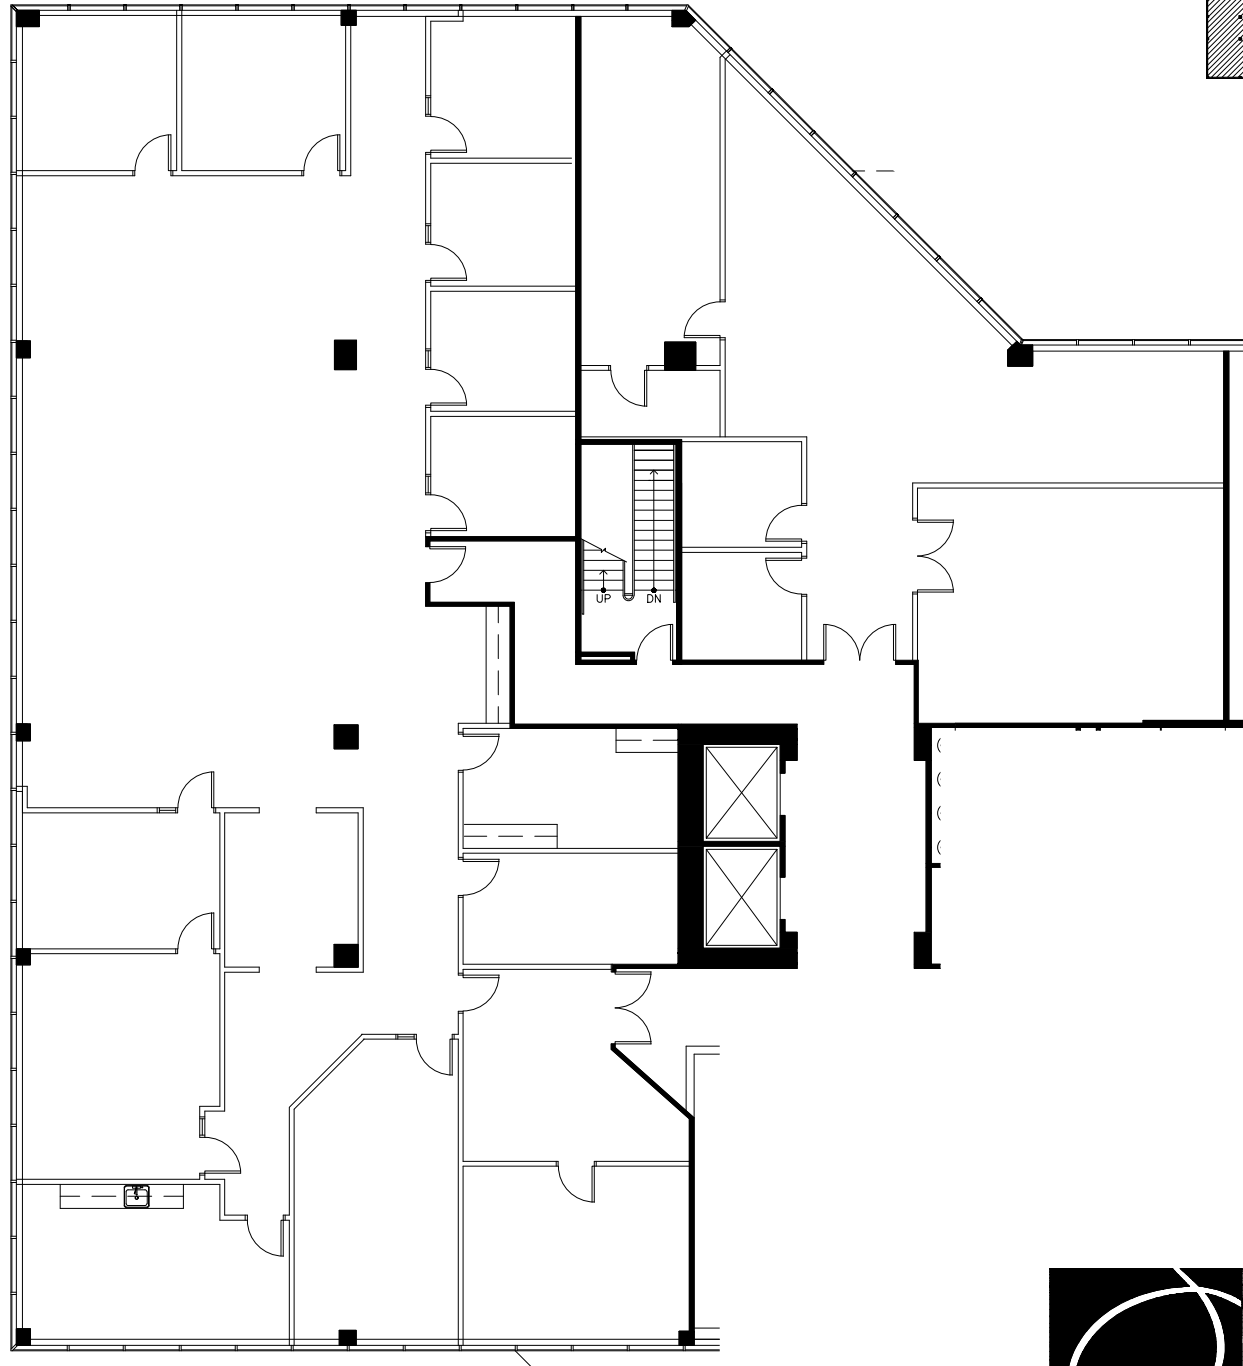

**CBRE**



**SMITH  
HARRIS  
DESIGN**  
associates