

NOTES


1. ALL CALCULATIONS INDICATE "GROSS" AREA AS PER "BOMA" STANDARDS.
2. ALL FIXTURES INDICATED ARE BUILT-IN.
3. ALL FLOORS ARE CARPET UNLESS OTHERWISE INDICATED.
4. ALL CEILING HEIGHTS ARE 8'-0" UNLESS OTHERWISE NOTED.
5. ALL DIMENSIONS TO BE FIELD VERIFIED PRIOR TO ANY CONSTRUCTION.
6. CALCULATIONS EXCLUDE ALL STAIRWELL AND VERTICAL PENETRATIONS.

AREA CALCULATIONS:

UPPER OFFICE AREA 532.61 SQ. FT.
GROUND LEVEL AREA 3533.14 SQ. FT.

GROSS BLDG. AREA 4099.61 SQ. FT.
(INCLUDING VERTICAL PENETRATIONS)

COURTYARD AREA 779.51 SQ. FT.

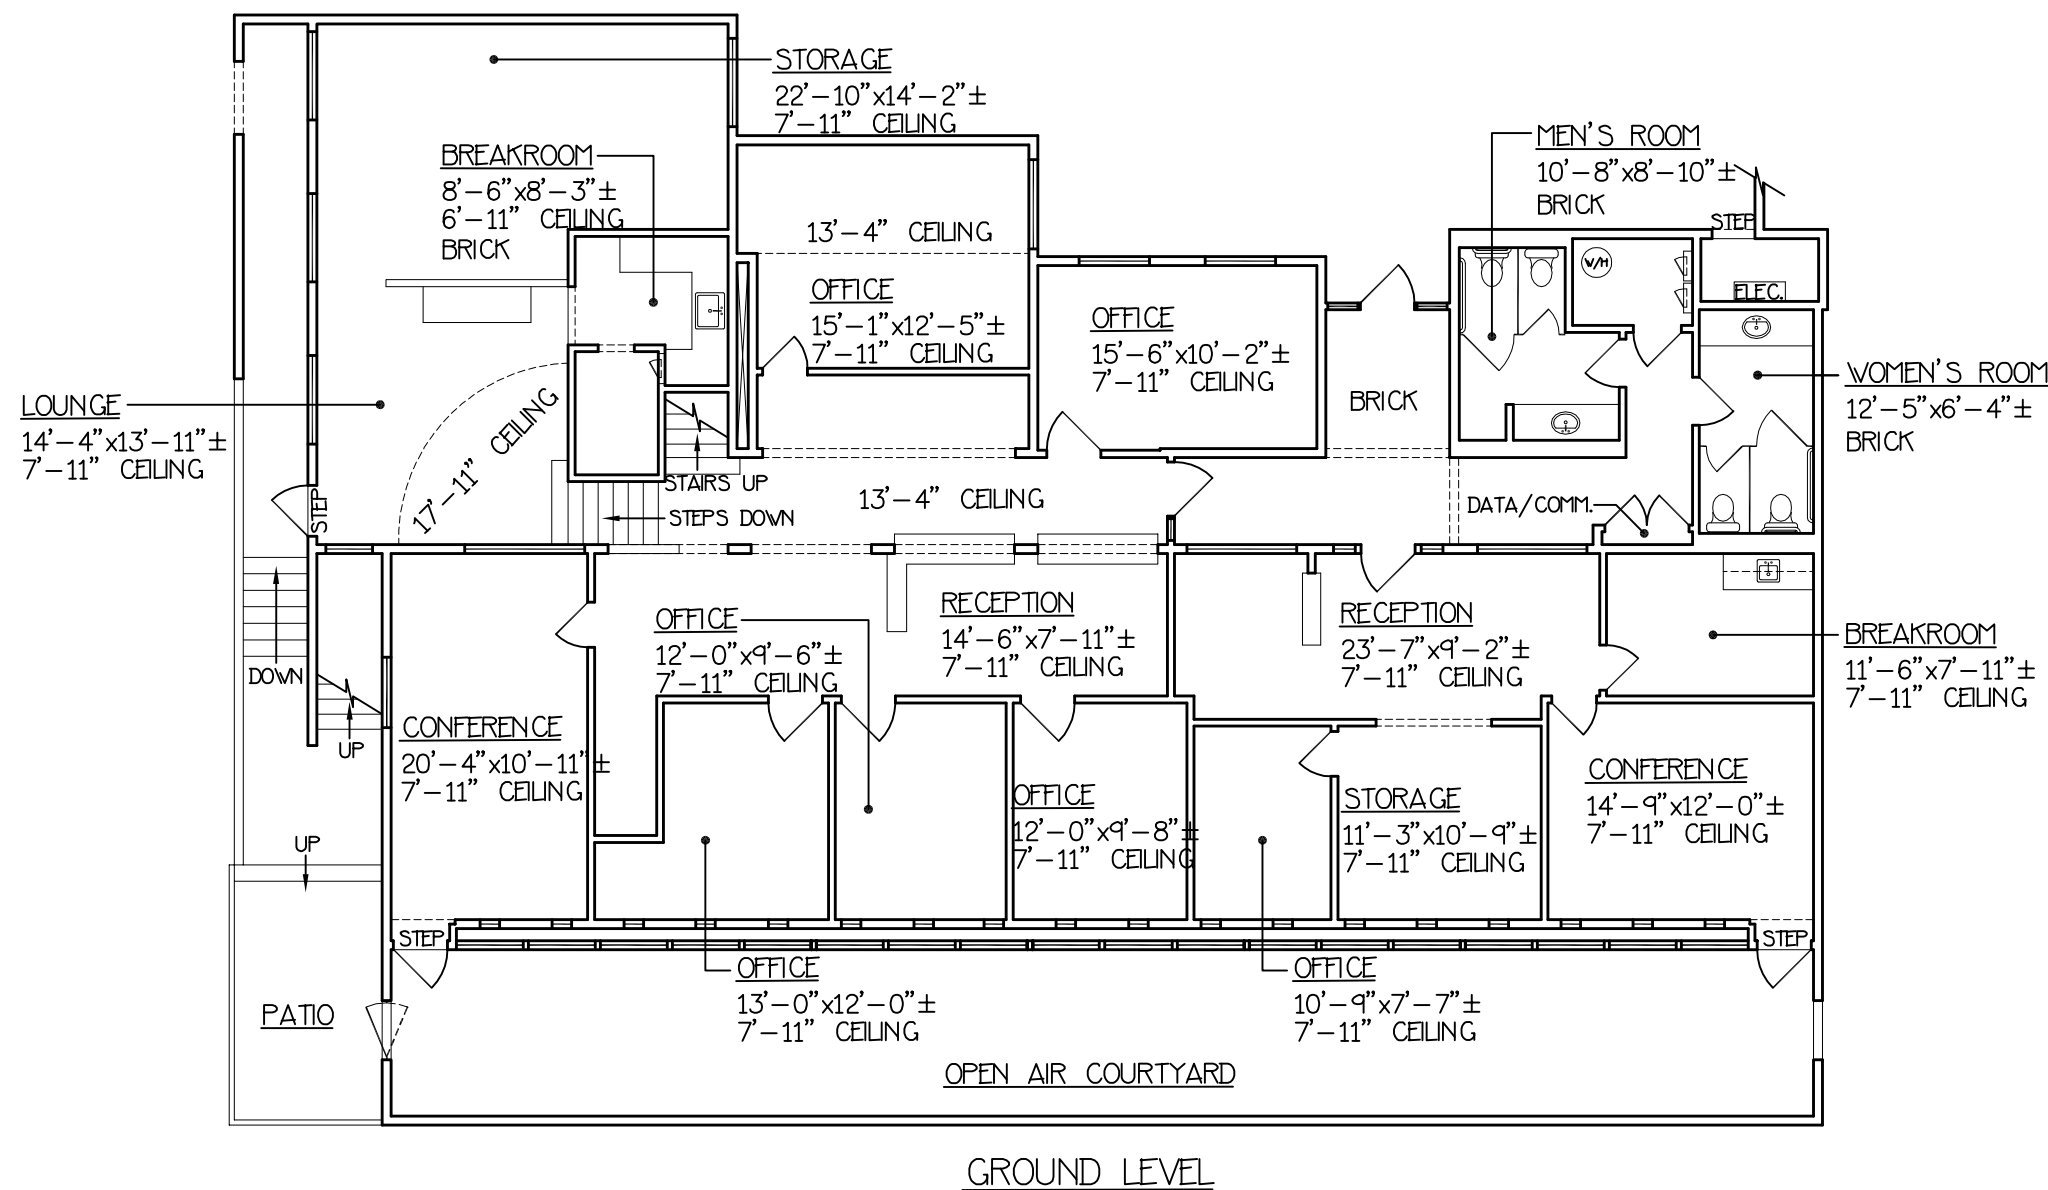

PROJECT:
3500 COMANCHE ROAD NE BLDG. F

DESCRIPTION:
AS-BUILT DRAWING

CLIENT:
MILLER ENGINEERING CONSULTANTS

SHEET #
01
OF 01

MEASURED BY JR
DESIGNED BY N.A.
DRAFTED BY JR
CHECKED BY P.M.
REVISED:

SCALE
3/32"=1'-0"

DATE
05/03/16

REFERENCE #
1
6
0
9
7

YCD DESIGNS
505-899-1199

ORIENTATION	MEASURED BY	JR	REFERENCE #	1
	DESIGNED BY	N.A.	REFERENCE #	6
	DRAFTED BY	JR	REFERENCE #	0
	CHECKED BY	P.M.	REFERENCE #	9
SCALE	DATE	05/03/16	REFERENCE #	7