
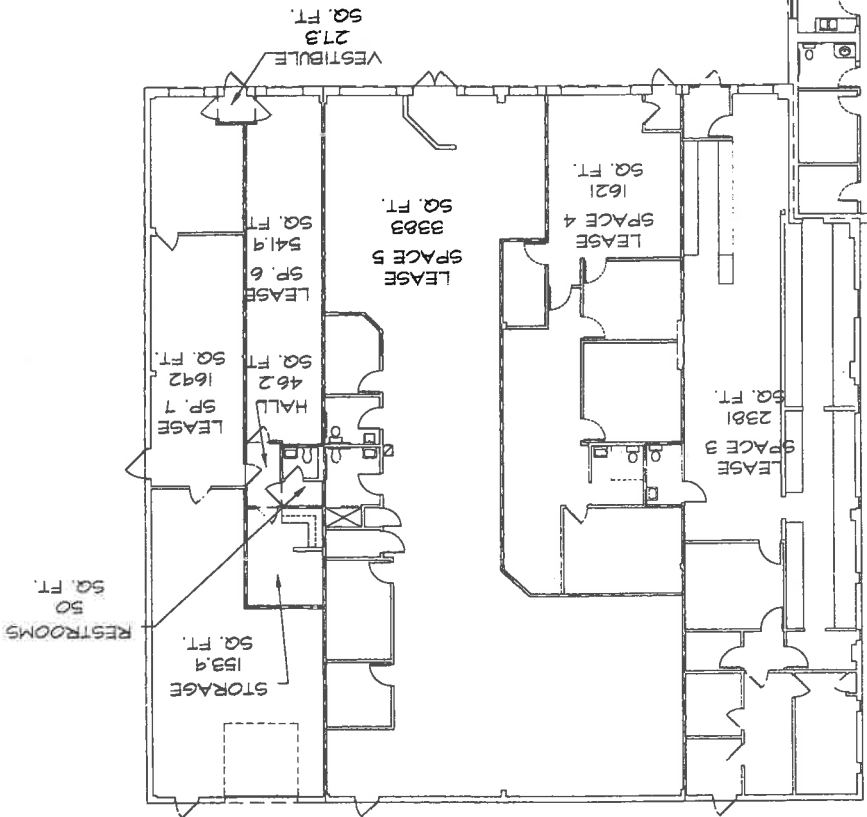


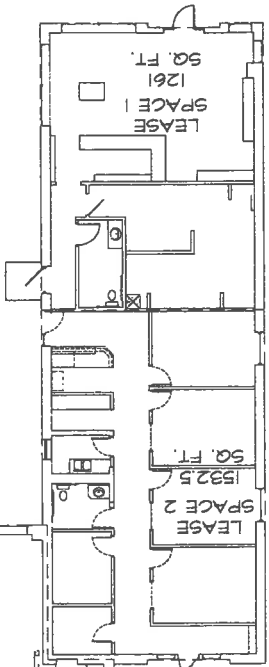

AS-BUILT PLAN
1/8" = 1'-0"

SHEET NO.
SER. NO.

102 E. CENTRAL ENTRANCE
DULUTH, MINNESOTA
REVISION DATE 02-12-08

SHEET TITLE

oarchitecture
31 West Superior St., Suite 201, Duluth, MN 55802
o architecture
Tel: (718) 728-4283

interior design
Tel: (718) 728-3581