

# 1,344 RSF +/- As Built Marketing Package

2750 Northaven Road Suite 208,  
Dallas, TX 75229

Sheet **A1**  
Of 01 Sheet(s)

LIDAR Verified  
Scale: Not to Scale  
Sheet Size: 8.5" x 11"  
Not For Construction




© 2025 HosScans, LLC.  
All right reserved.  
These drawings and any associated documents are protected under U.S. copyright law. No part of this work may be produced, distributed, or used in any form, by any method, for any purpose, without the prior written consent of HosScans, LLC. Unauthorized use is subject to legal action.

## Usable Square Foot Analysis

	SQFT	BUILDING PERCENTAGE
OFFICE AREA:	1,344	100%
TOTAL AREA:	1,344	100%

## Building Information

Deck Height:	13'-10" +/-
Clear Height:	12'-4" +/-
Ceiling Height:	8'-0" +/-
Sprinklered:	No
Mechanical Area:	N/A

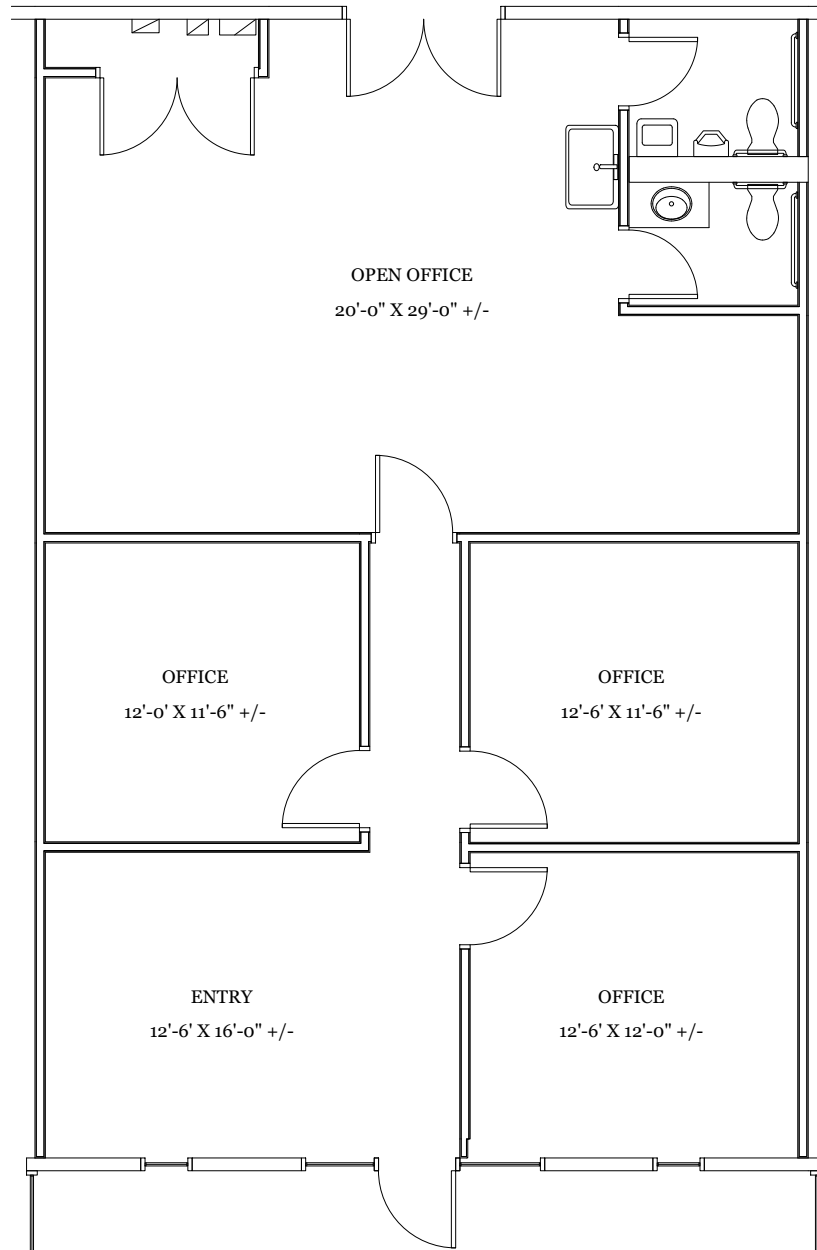

As Built Floor Plan for Marketing

