

ESTRELLA
MEDICAL
CENTER

9305 W THOMAS RD | PHOENIX, AZ 85037


Floor 04

Suite 455

AS-BUILT

1,721 SF

AVAILABLE

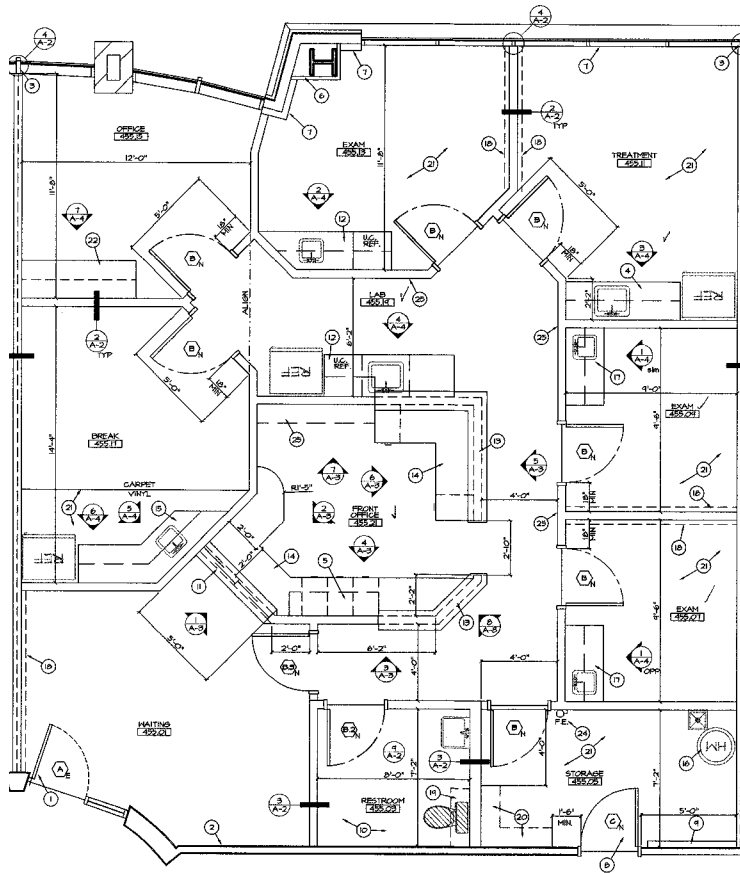

RACHAEL THOMPSON
Senior Vice President
602.513.5122
rachael.thompson@kidder.com

PERRY GABUZZI, CCIM
Senior Vice President
602.513.5116
perry.gabuzzi@kidder.com



View Portfolio

km Kidder
Mathews