


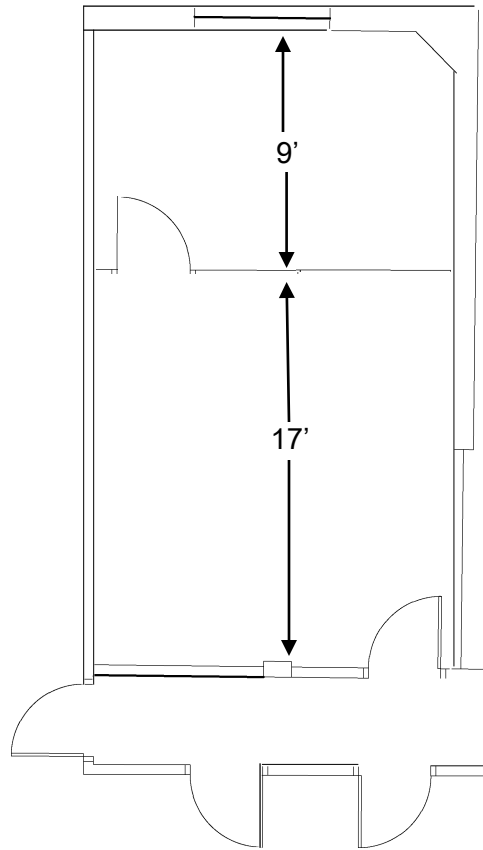

EXECUTIVE COMMONS
SUITE 100D
AS-BUILT PLAN