
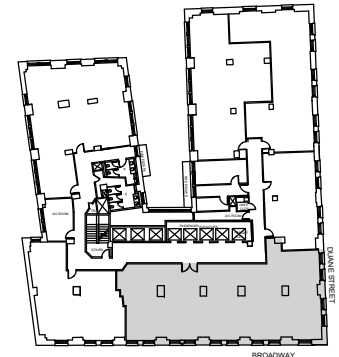


Suite 1405

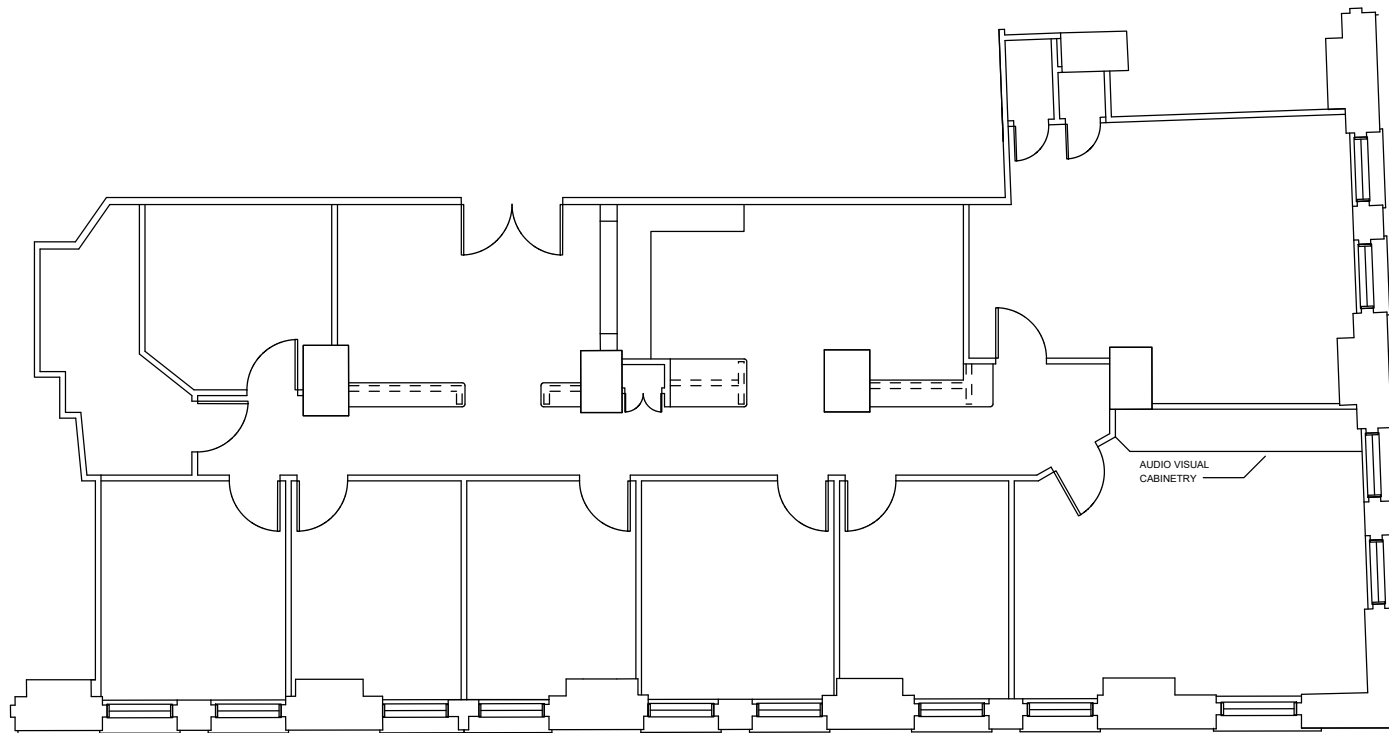

KEY PLAN: NOT TO SCALE