



GRAYMARK OFFICE BUILDING

16801 Addison Road, Addison, Texas

SUITE 325
3,681 RSF

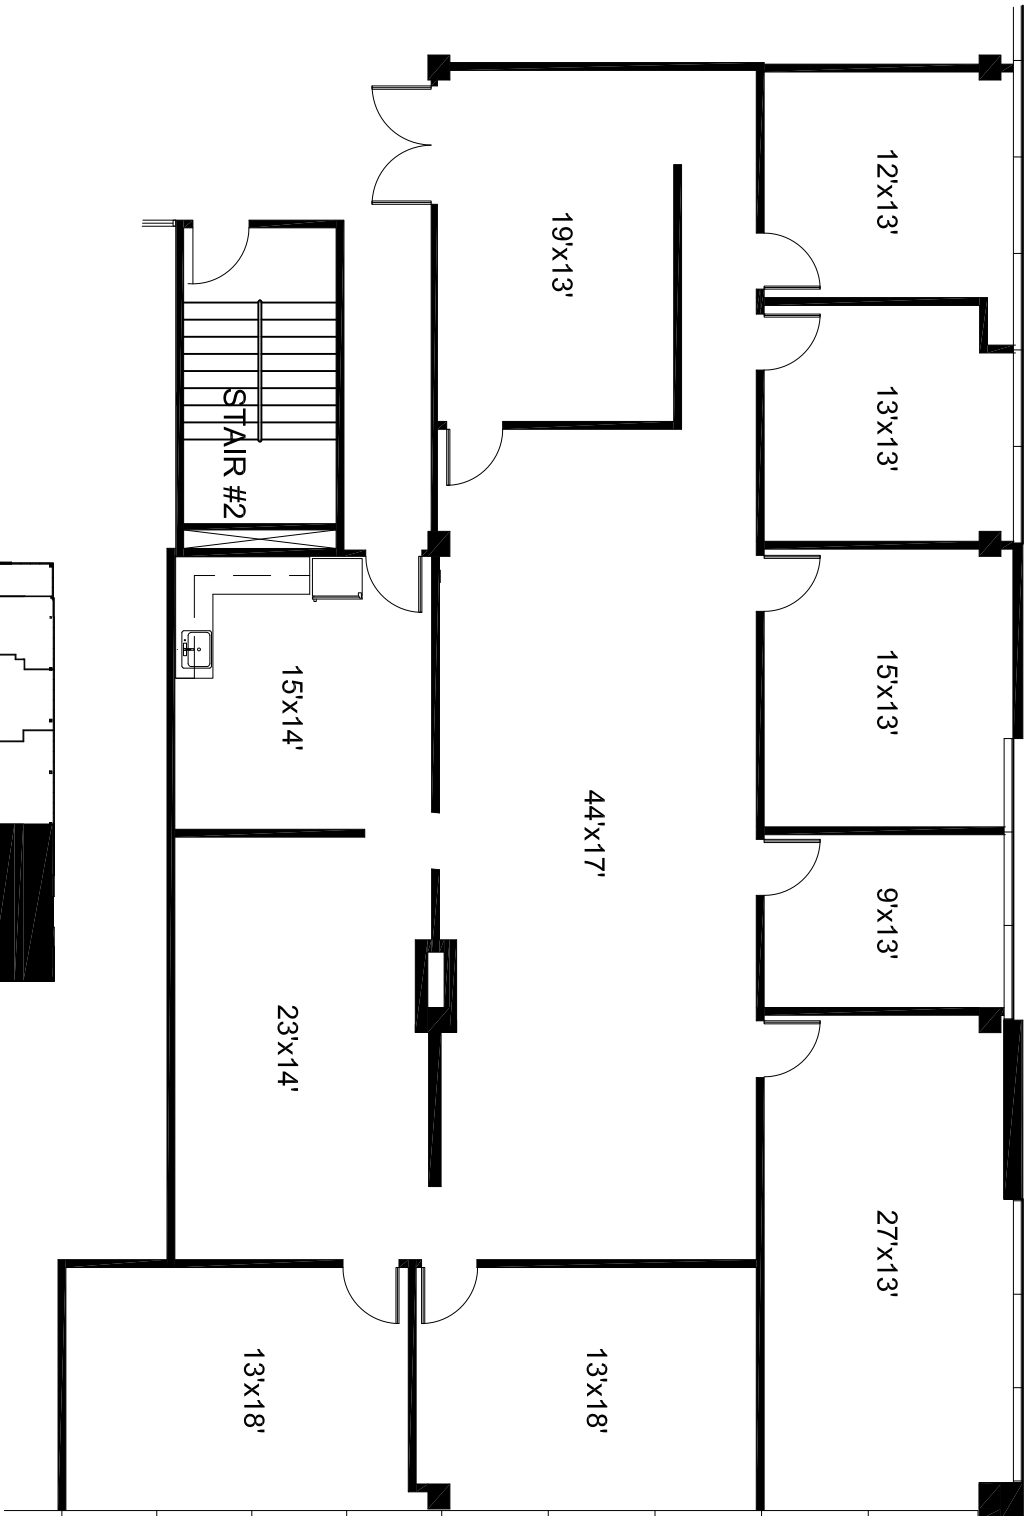

3RD FLOOR

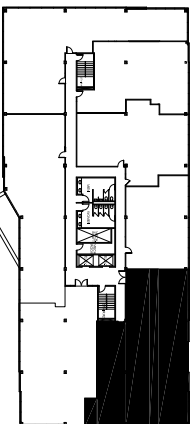

Scale: 3/32"=1'-0"

All dimensions and square footages are approximate.

August 29, 2025



DFW DESIGN DEPOT

(817) 929-8804