


**AS-BUILT PLAN**



**HYPOTHETICAL PLAN**

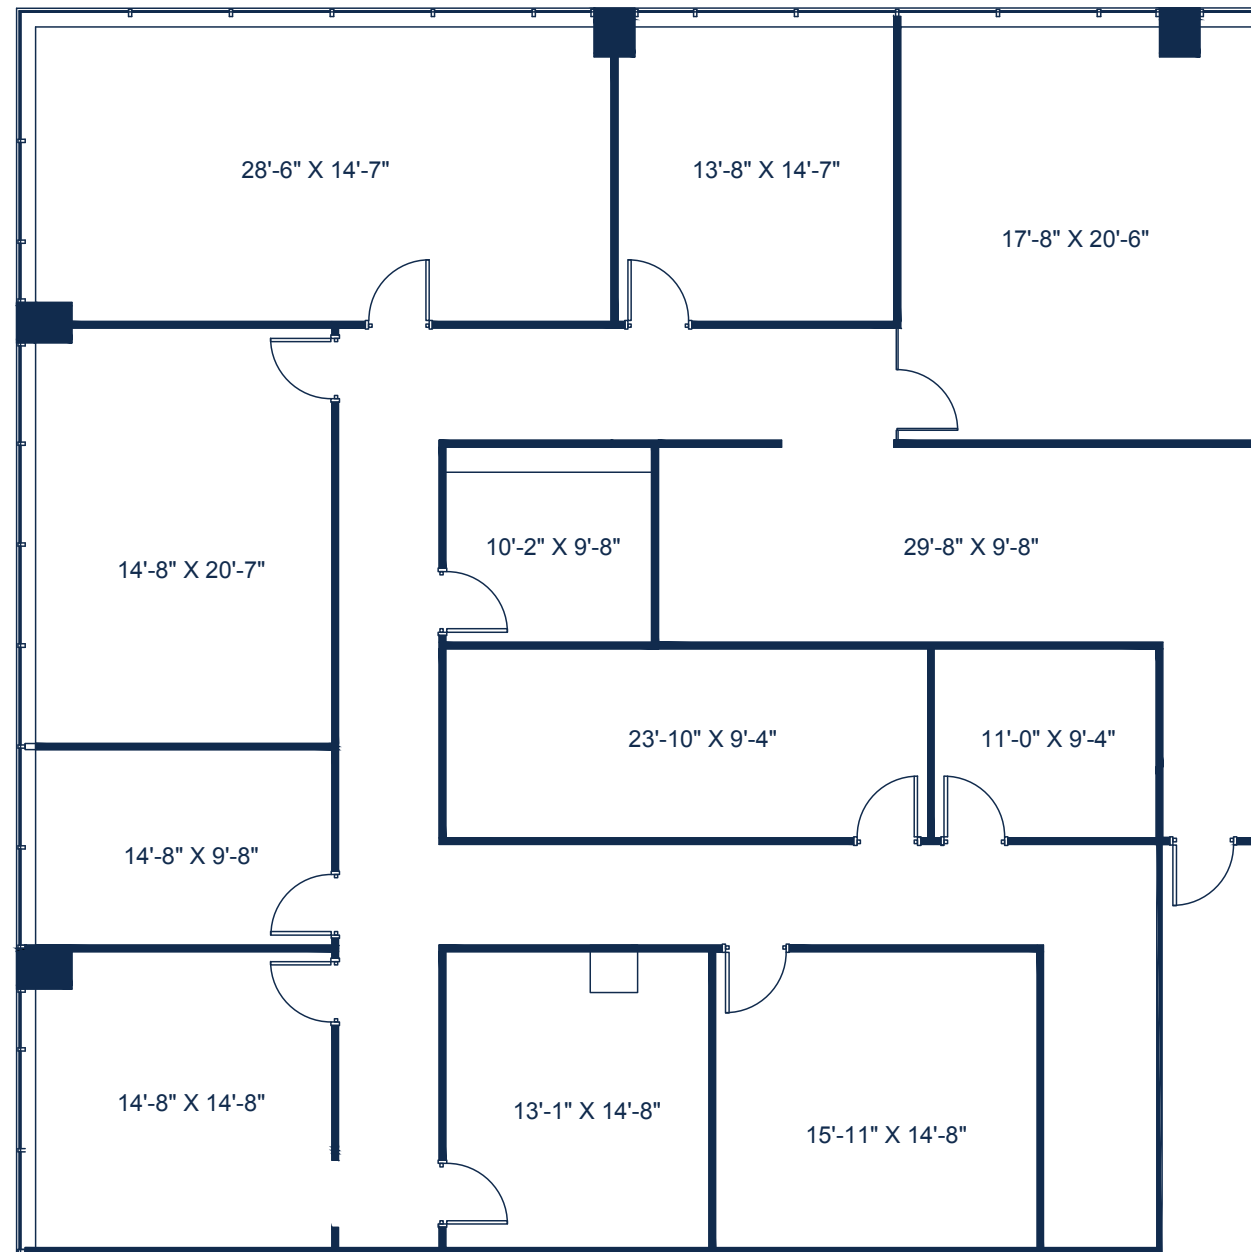