


***GARAGE'S ACROSS TEXAS***  
 GROUND FLOOR UNIT F5  
 OPTION A

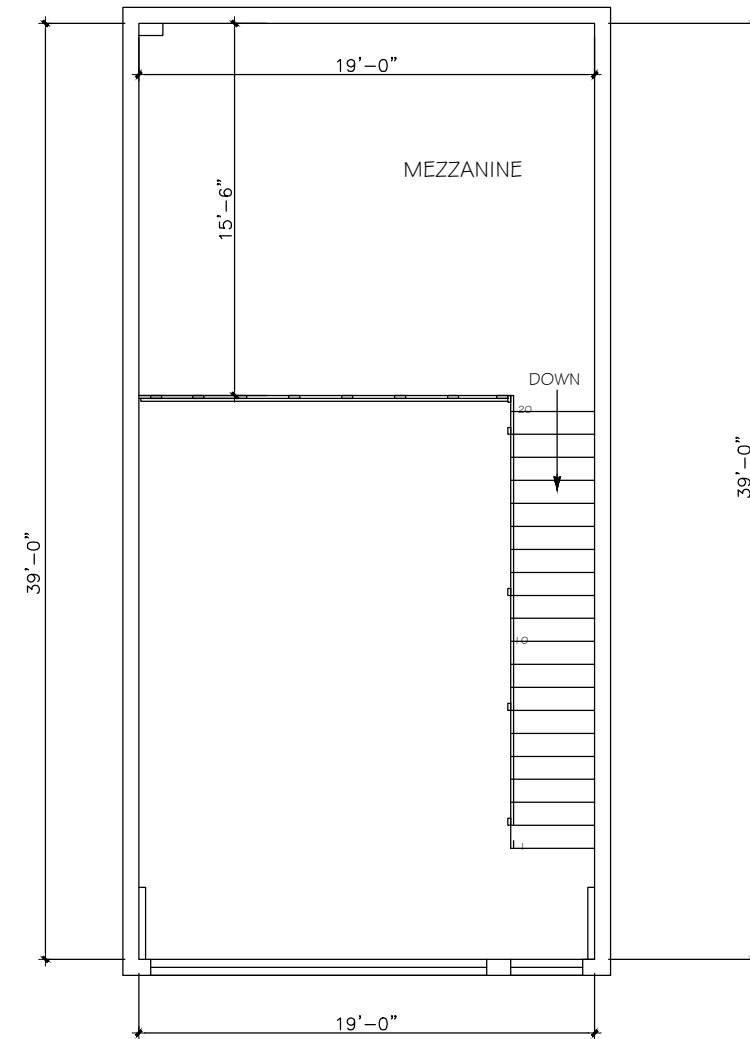

***GARAGE'S ACROSS TEXAS***  
 MEZZANINE UNITS F5  
 OPTION A

***GAT UNIT F5 AS-BUILT PLANS***

SCALE: 1/8" = 1'-0" When Printed on 11X17 Paper

3-27-23