




1450 N. Benson Ave.,
Upland, CA 91786 USA
www.anabioll.com - (909) 394-4728

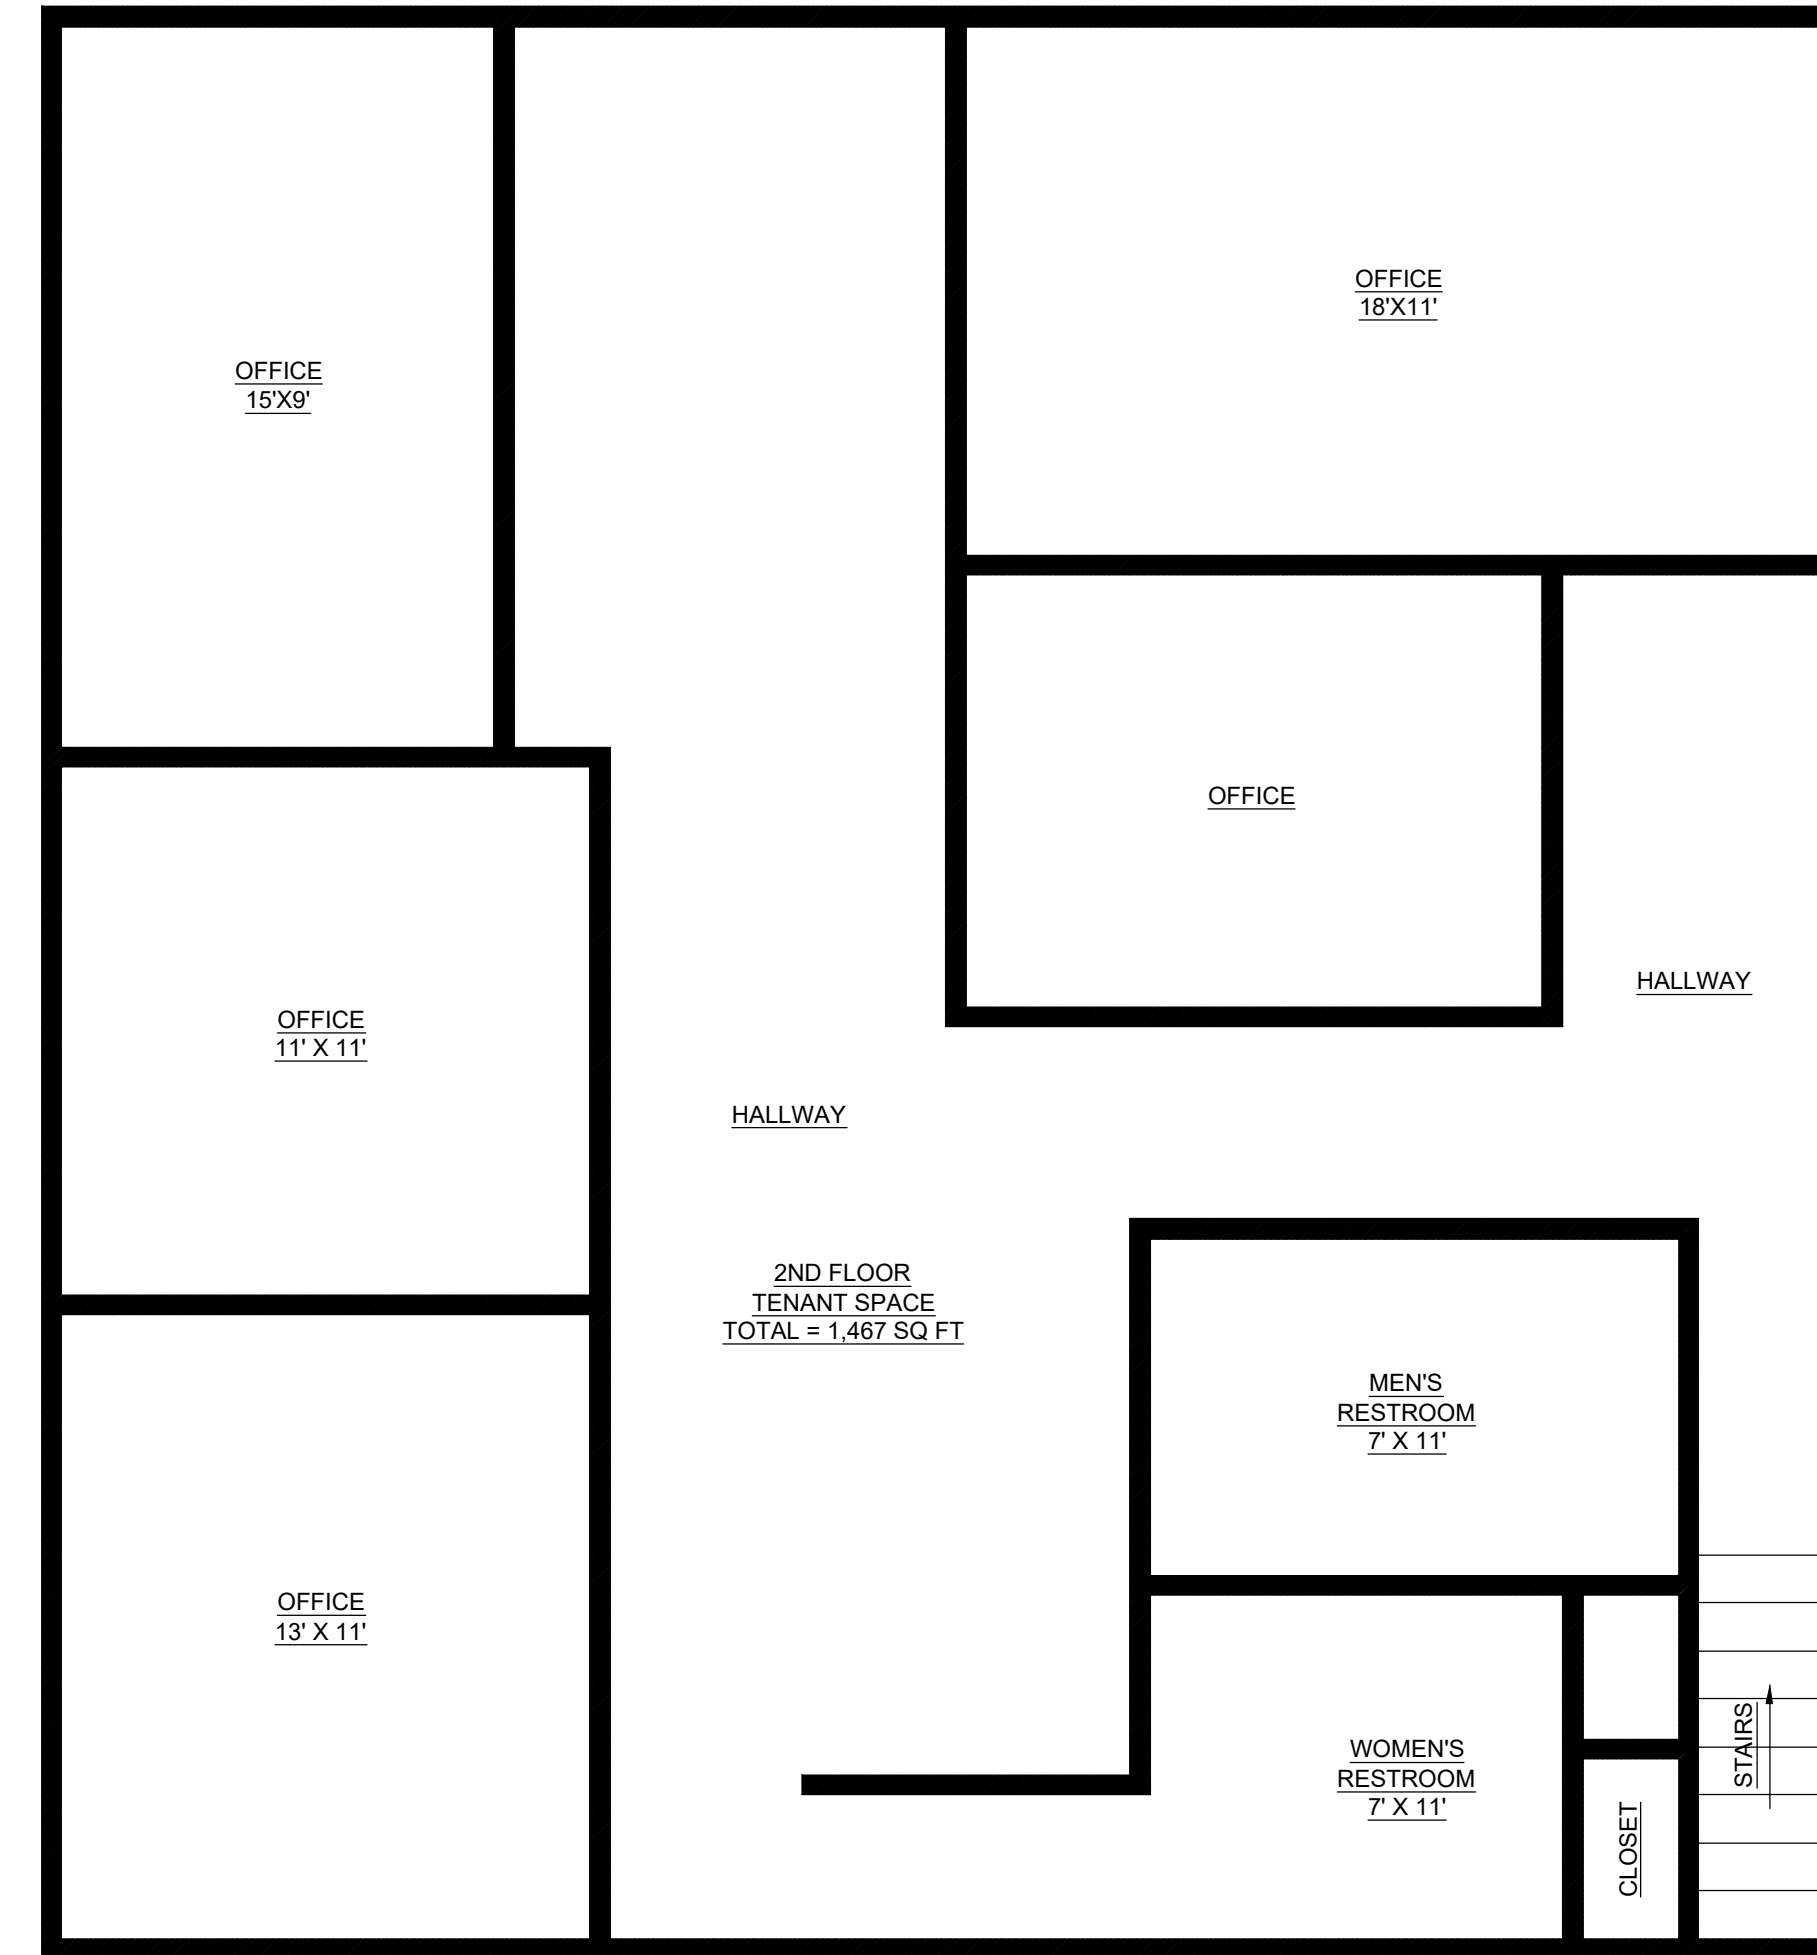

1 AS-BUILT PLAN

PROJECT FILE NAME:	2ND STORY VACANT TENANT SPACE	REVISION #:	01	DESIGNER:	DV	PAGE:	AS-BUILT
PROJECT ADDRESS:	2499 PALM RIDGE ROAD SANIBEL, FL	STORE #:	839	DATE:	11-13-2025	SCALE:	1/4" = 1'-0"



SEAL