

FOR MORE INFORMATION PLEASE CONTACT:

TIM OWENS

+1 425 462 6913
tim.owens@cbre.com

MARCUS YAMAMOTO

+1 206 292 6062
marcus.yamamoto@cbre.com

KATIE SMITH

+1 206 292 6012
katie.m.smith@cbre.com






Overlake

MEDICAL PAVILION

1231 116th Avenue NE • Bellevue, WA 98004

FLOOR 1
SUITE 150 • 1,451 SF
AS-BUILT

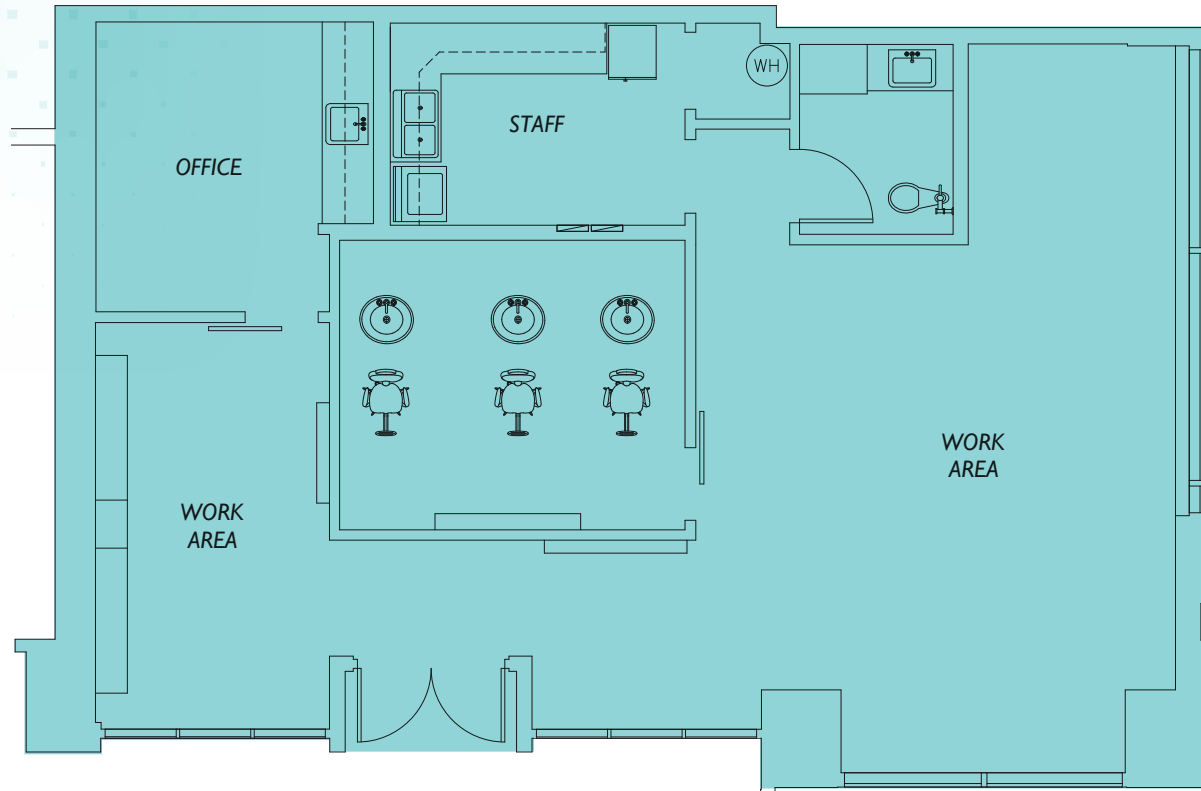

FOR MORE INFORMATION PLEASE CONTACT:

TIM OWENS

+1 425 462 6913

tim.owens@cbre.com

MARCUS YAMAMOTO

+1 206 292 6062

marcus.yamamoto@cbre.com

KATIE SMITH

+1 206 292 6012

katie.m.smith@cbre.com



HEALTHCARE
REALTY

CBRE

© 2025 CBRE, Inc. All rights reserved. This information has been obtained from sources believed reliable, but has not been verified for accuracy or completeness. You should conduct a careful, independent investigation of the property and verify all information. Any reliance on this information is solely at your own risk. CBRE and the CBRE logo are service marks of CBRE, Inc. All other marks displayed on this document are the property of their respective owners, and the use of such logos does not imply any affiliation with or endorsement of CBRE. Photos herein are the property of their respective owners. Use of these images without the express written consent of the owner is prohibited.