


Randolph Business Park

1510 Randolph Street
Suite 504
Carrollton, Texas 75006

Sheet **A6**
Of 9 Sheet(s)

Scale: Not to Scale
Sheet Size: 11" x 8.5"
Not For Construction

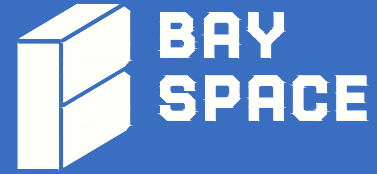


© 2025 HosScans, LLC.
All right reserved.
These drawings and any associated documents are protected under U.S. copyright law. No part of this work may be produced, distributed, or used in any form, by any method, for any purpose, without the prior written consent of HosScans, LLC. Unauthorized use is subject to legal action.

Usable Square Foot Analysis

OFFICE AREA:	867	89%
WAREHOUSE AREA:	109	11%
TOTAL AREA:	976	

Building Information

Deck Height:	12'0"
Clear Height:	10'0"
Ceiling Height:	7'10"
Sprinklered:	No
Mechanical Area:	N/A

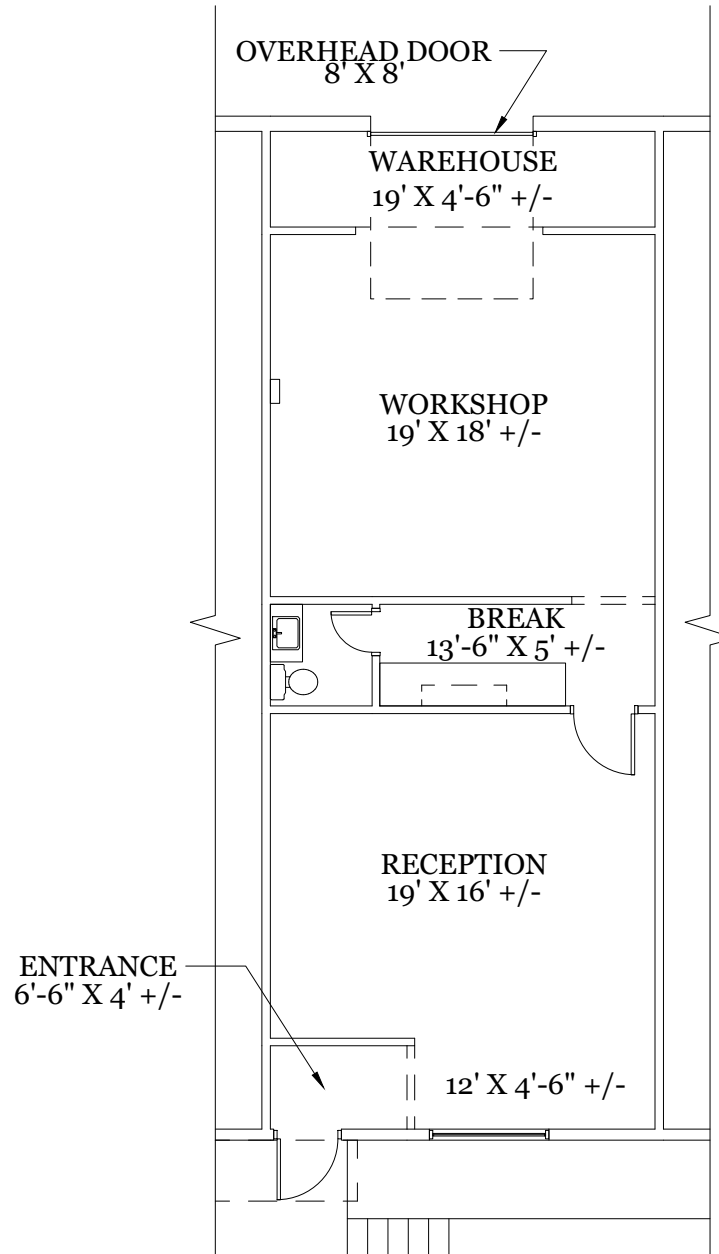

As Built Floor Plan for Marketing

