

## 2526 Manana Business Center As Built Marketing Package

Suite 110  
Dallas, TX 75220

Sheet **A9**  
Of 13 Sheet(s)

Scale: Not to Scale  
Sheet Size: 11" x 8.5"  
Not For Construction


© 2025 HosScans, LLC.  
All right reserved.  
These drawings and any associated documents are protected under U.S. copyright law. No part of this work may be produced, distributed, or used in any form, by any method, for any purpose, without the prior written consent of HosScans, LLC. Unauthorized use is subject to legal action.

### Usable Square Foot Analysis

	SQFT	BUILDING PERCENTAGE
OFFICE AREA:	1,813	60%
WAREHOUSE AREA:	1,212	40%
TOTAL AREA:	3,025	

### Building Information

Deck Height:	13'-0"
Clear Height:	11'-0"
Ceiling Height:	9'-0"
Sprinklered:	No
Mechanical Area:	N/A

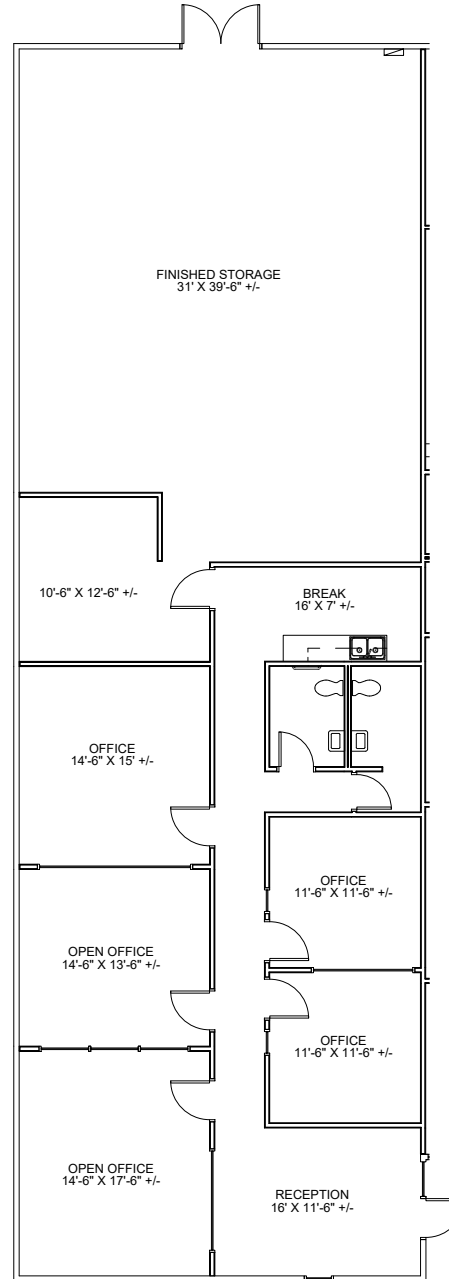

As Built Floor Plan for Marketing

