


Note: Crane Capacities and locations should all be verified. Indicated information was taken from the face of the crane beams.
 Dimensions and square footages are approximate and should be field verified.

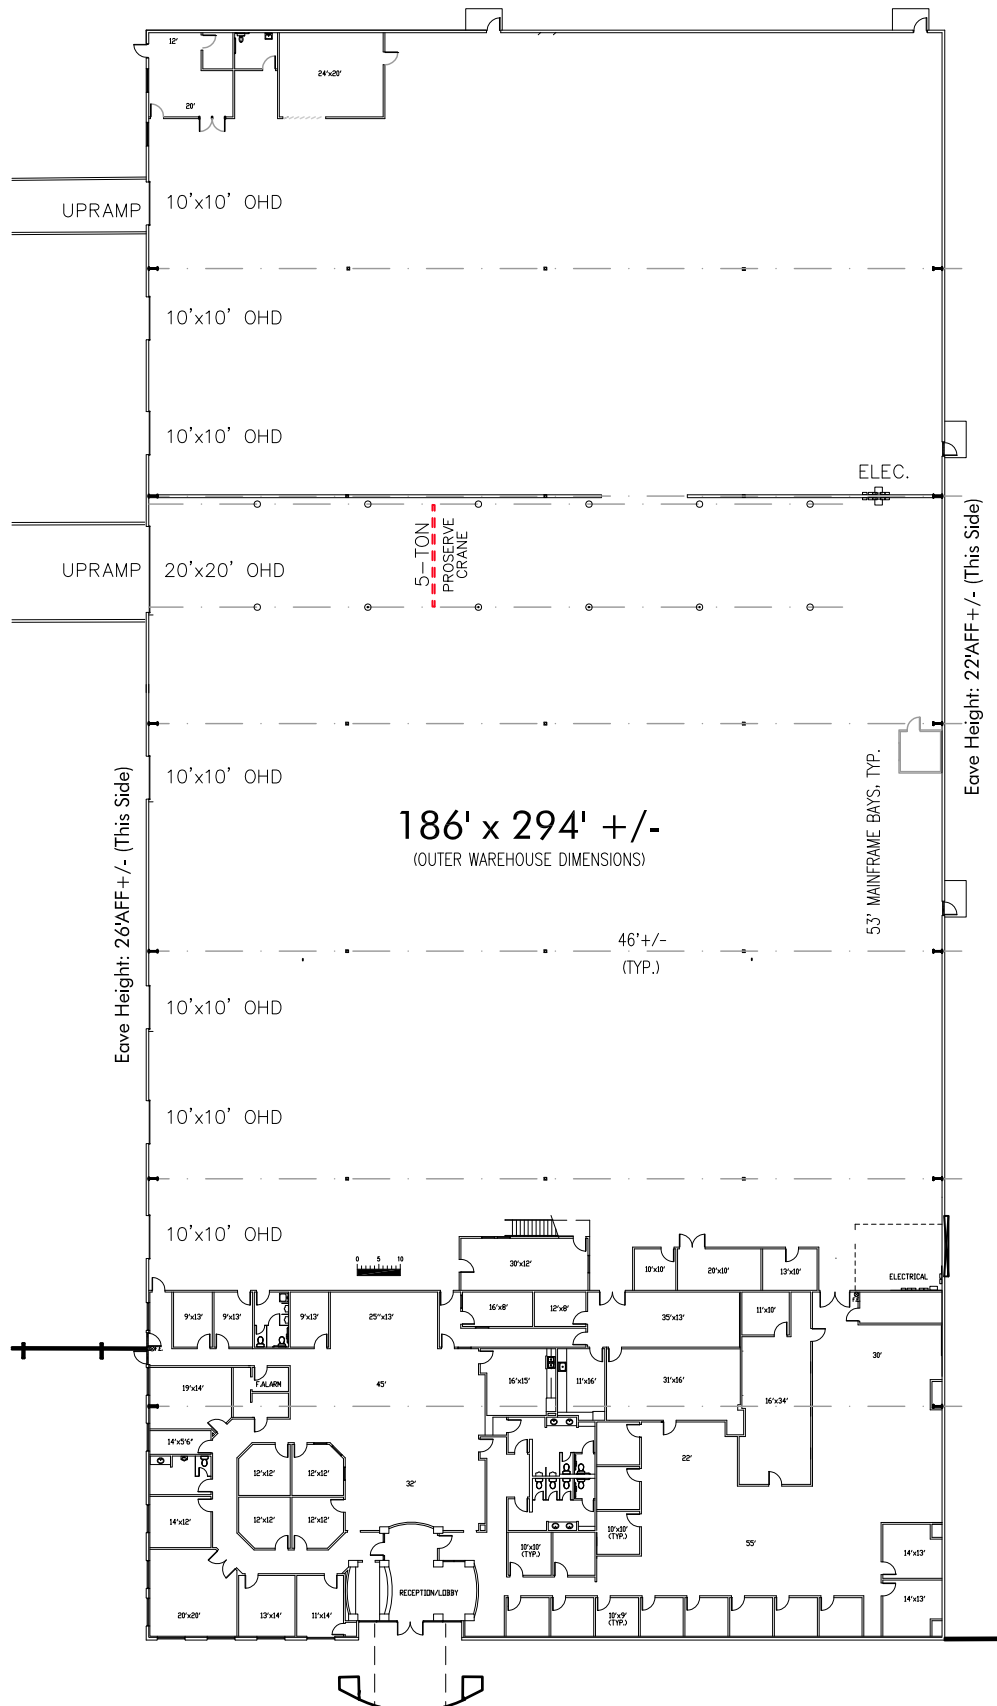

Eave Height: Refer to Plan

15,149 S.F. Main Office
 818 S.F. WH Ofc Area 1
 1,034 S.F. WH Ofc Area 2
 52,748 Warehouse Area
 70,130 S.F. Total Building

10600 W Sam Houston Pkwy N


Houston, Texas

Harry Gendel Architects




DATE:	ISSUE/REVISION:	DRAWING: A1
04/21/2025	AS-BUILT	
JOB#:	TITLE:	SITE PLAN AND FLOOR PLAN
FILE:		


Enlarged Plan at Rear Warehouse Offices:

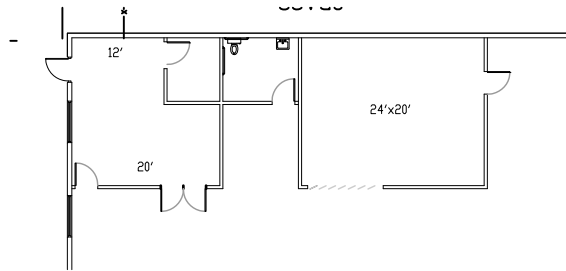

Enlarged Plan at Mezz. Office:

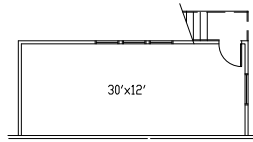

Enlarged Plan at Main Offices:

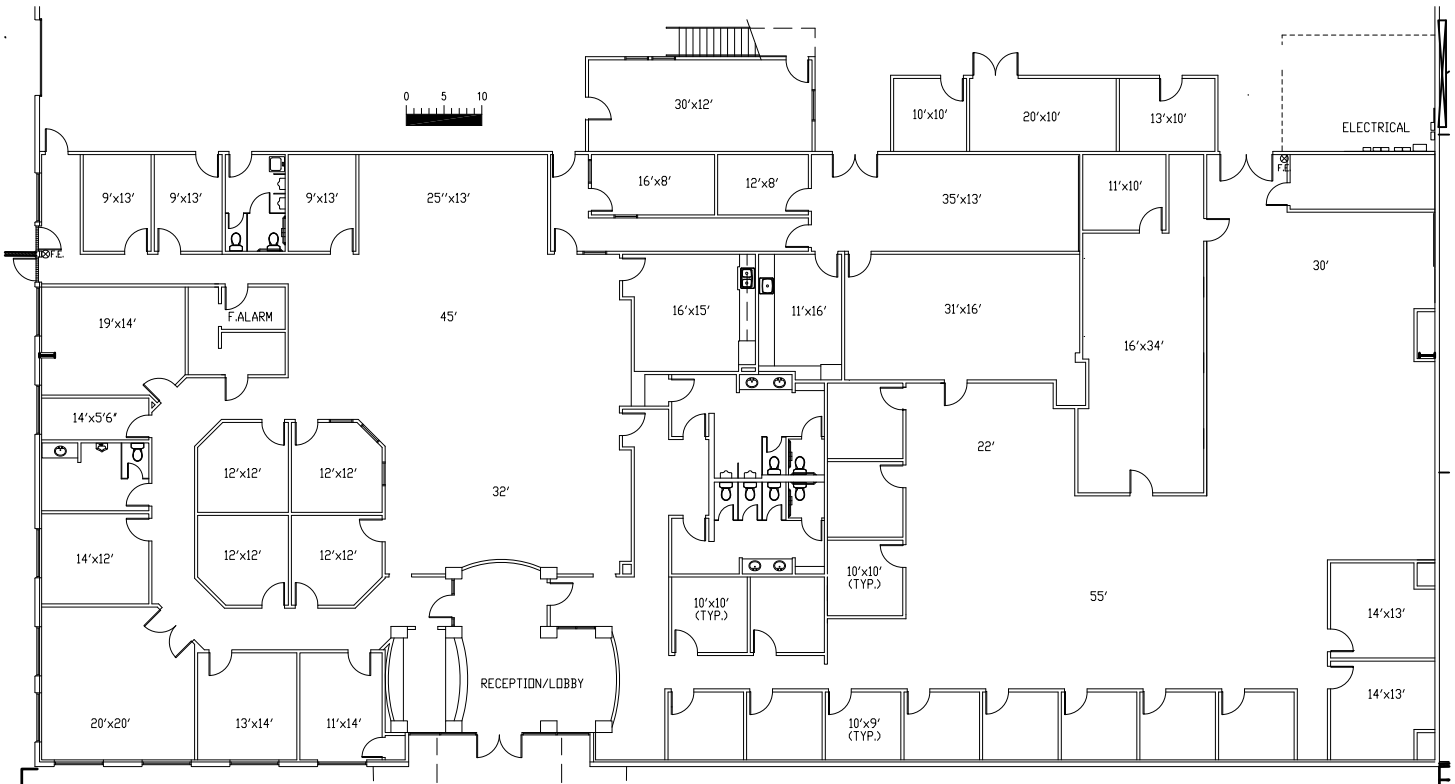

Note: All dimensions are approximate and should be field verified.

10600 W Sam Houston Pkwy N Houston, TX	DATE:	ISSUE/REVISION:	DRAWING: A2
		04/21/2025 AS-BUILT	
HarryGendelArchitects	JOB#:	TITLE: PLAN AT OFFICES AND MEZZANINE	
	FILE:		