


## Property Key

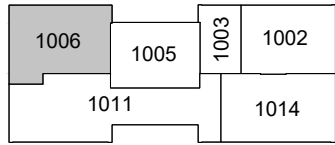

## WMG ICOT BC As Built Marketing Package

13830-13923 58th Street North, Clearwater, FL 33760

Building: 10

Suite: 1006

Sheet: A-4




# BAY SPACE

Scale: Not to Scale  
Sheet Size: 8.5" x 11"  
Not For Construction

Total Area - 2,347 SF

## Building Information

DECK HEIGHT:	N/A
CEILING HEIGHT:	8'-11"
CLEAR HEIGHT:	8'-11"
SPRINKLERED:	No

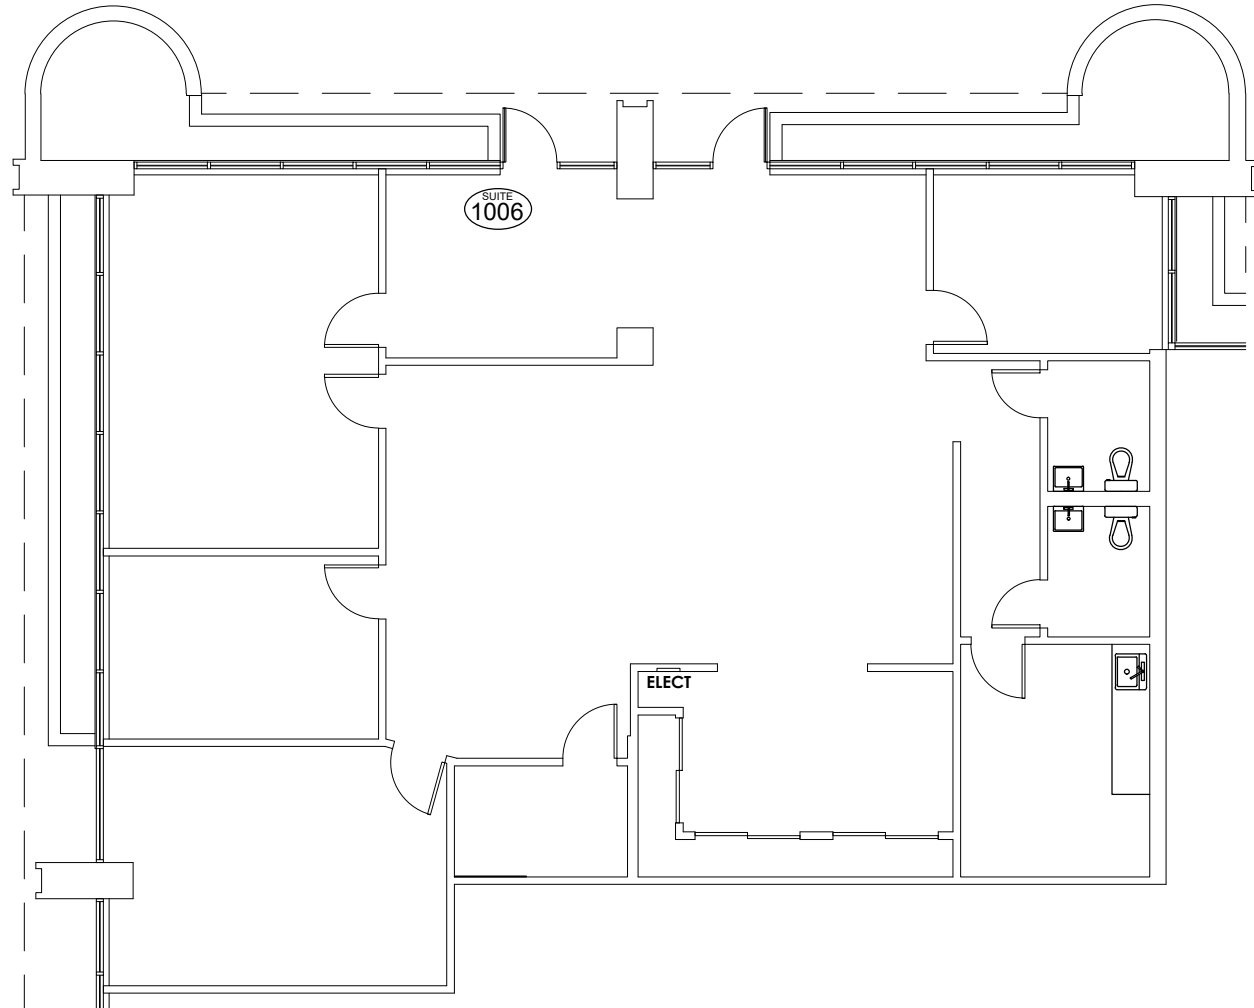

As Built Floor Plan for Marketing