


Flex Space Demising Options

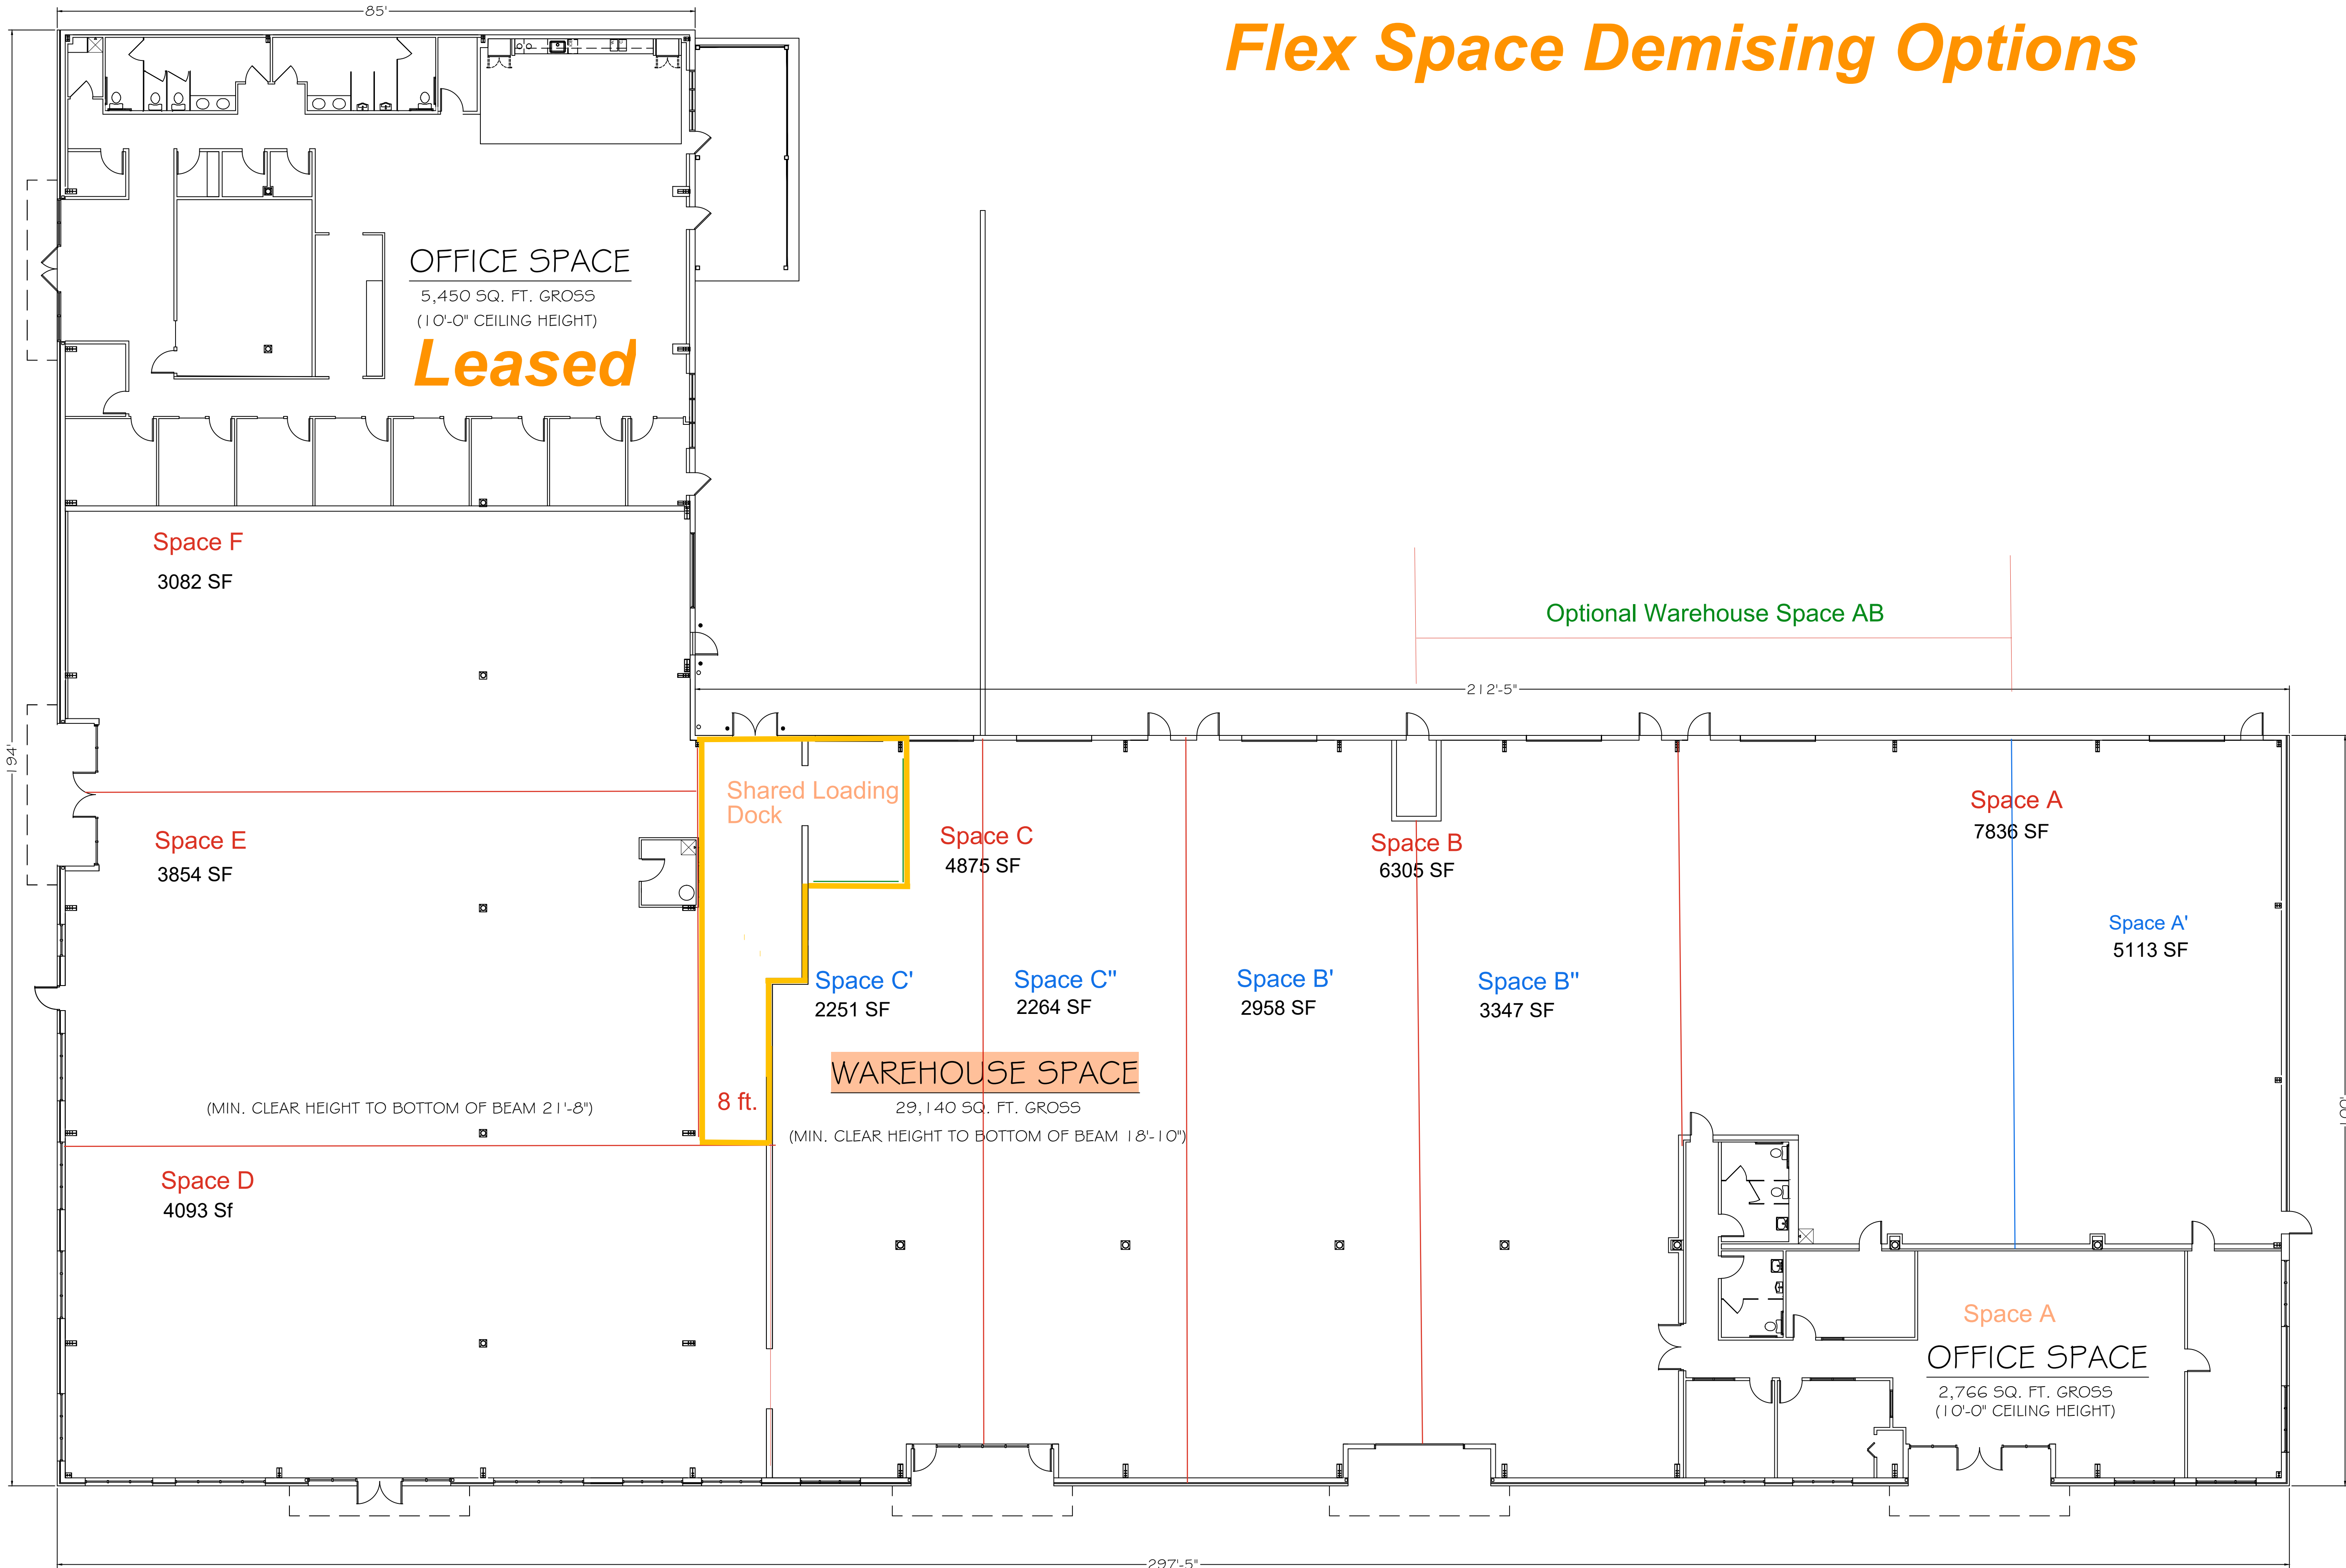

SHADY ELM FLEX BUILDING
131 FROGALE COURT
FREDERICK COUNTY, VA

ROBERT J. DEAN
ARCHITECTURAL DRAFTING AND DESIGN
WINCHESTER, VA
(540) 664-1638

ALL DRAWINGS IN THIS SET
ARE FOR DESIGN CONCEPT
ONLY. ALL STRUCTURAL
CONCEPTS BY OTHERS
ALL DIMENSIONS TO BE
VERIFIED BEFORE
CONSTRUCTION. NOTIFY
OWNER FOR
NECESSARY ADJUSTMENTS
AND MODIFICATIONS.

JOB #2529

DATE
SEPTEMBER 18, 2025
AS BUILT

REVISIONS

OVERALL
FLOOR PLAN
A1