


As Built

RSF

Suite 217

1,299

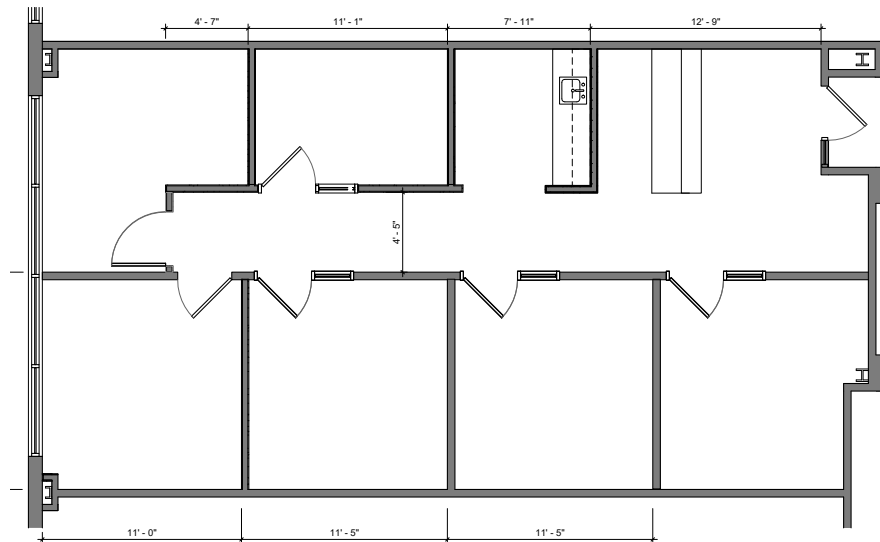

For leasing information contact

Rachael Thompson

602.513.5122

rachael.thompson@kidder.com

Perry Gabuzzi, CCIM

602.513.5116

perry.gabuzzi@kidder.com

stapleymedicalcenter.com

