






LASALLE PLAZA

Minneapolis, Minnesota

SUITE 0214 - SUITE AS-BUILT PLAN (348 RSF)

1/4" = 1'-0"

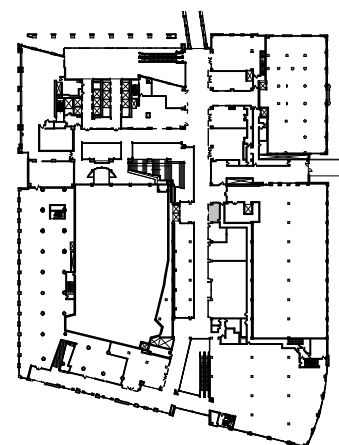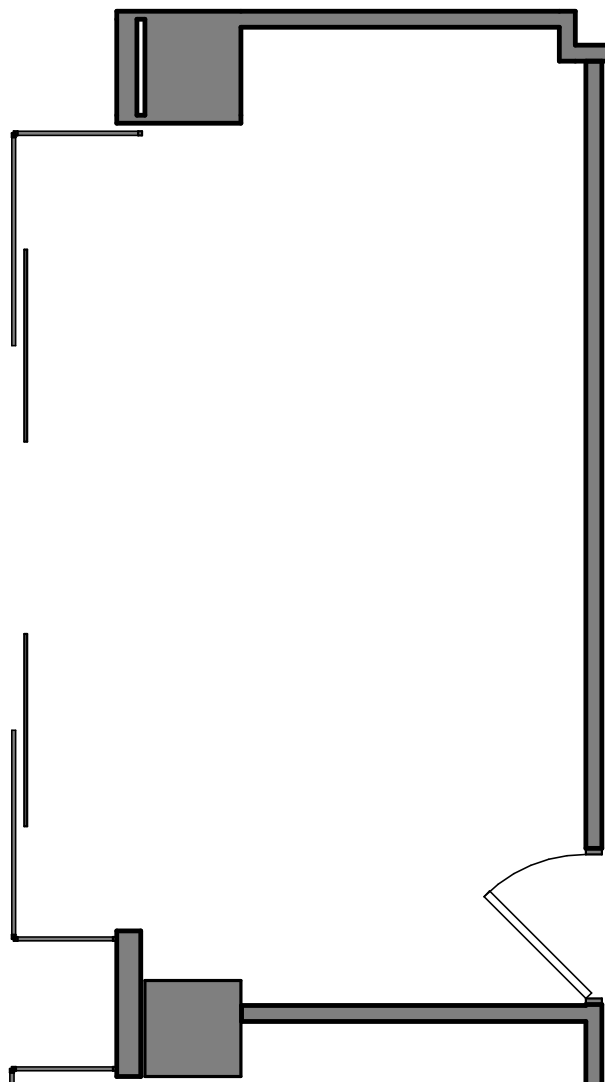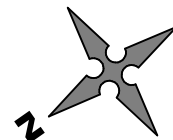

NELSON
Issue Date: 09/05/2023

For Information, Contact:
Brent Jacobson: 612-355-2609
Ben Krsnak: 612-355-2608
Julie Yeazle: 612-817-6315

HEMPEL
REAL ESTATE

FLOOR 2