


FILE: C:\Bentley\Local\TREHQ_22_aharragan\SSXG5.rvt
 DATE: 11/13/2025 5:52:33 AM

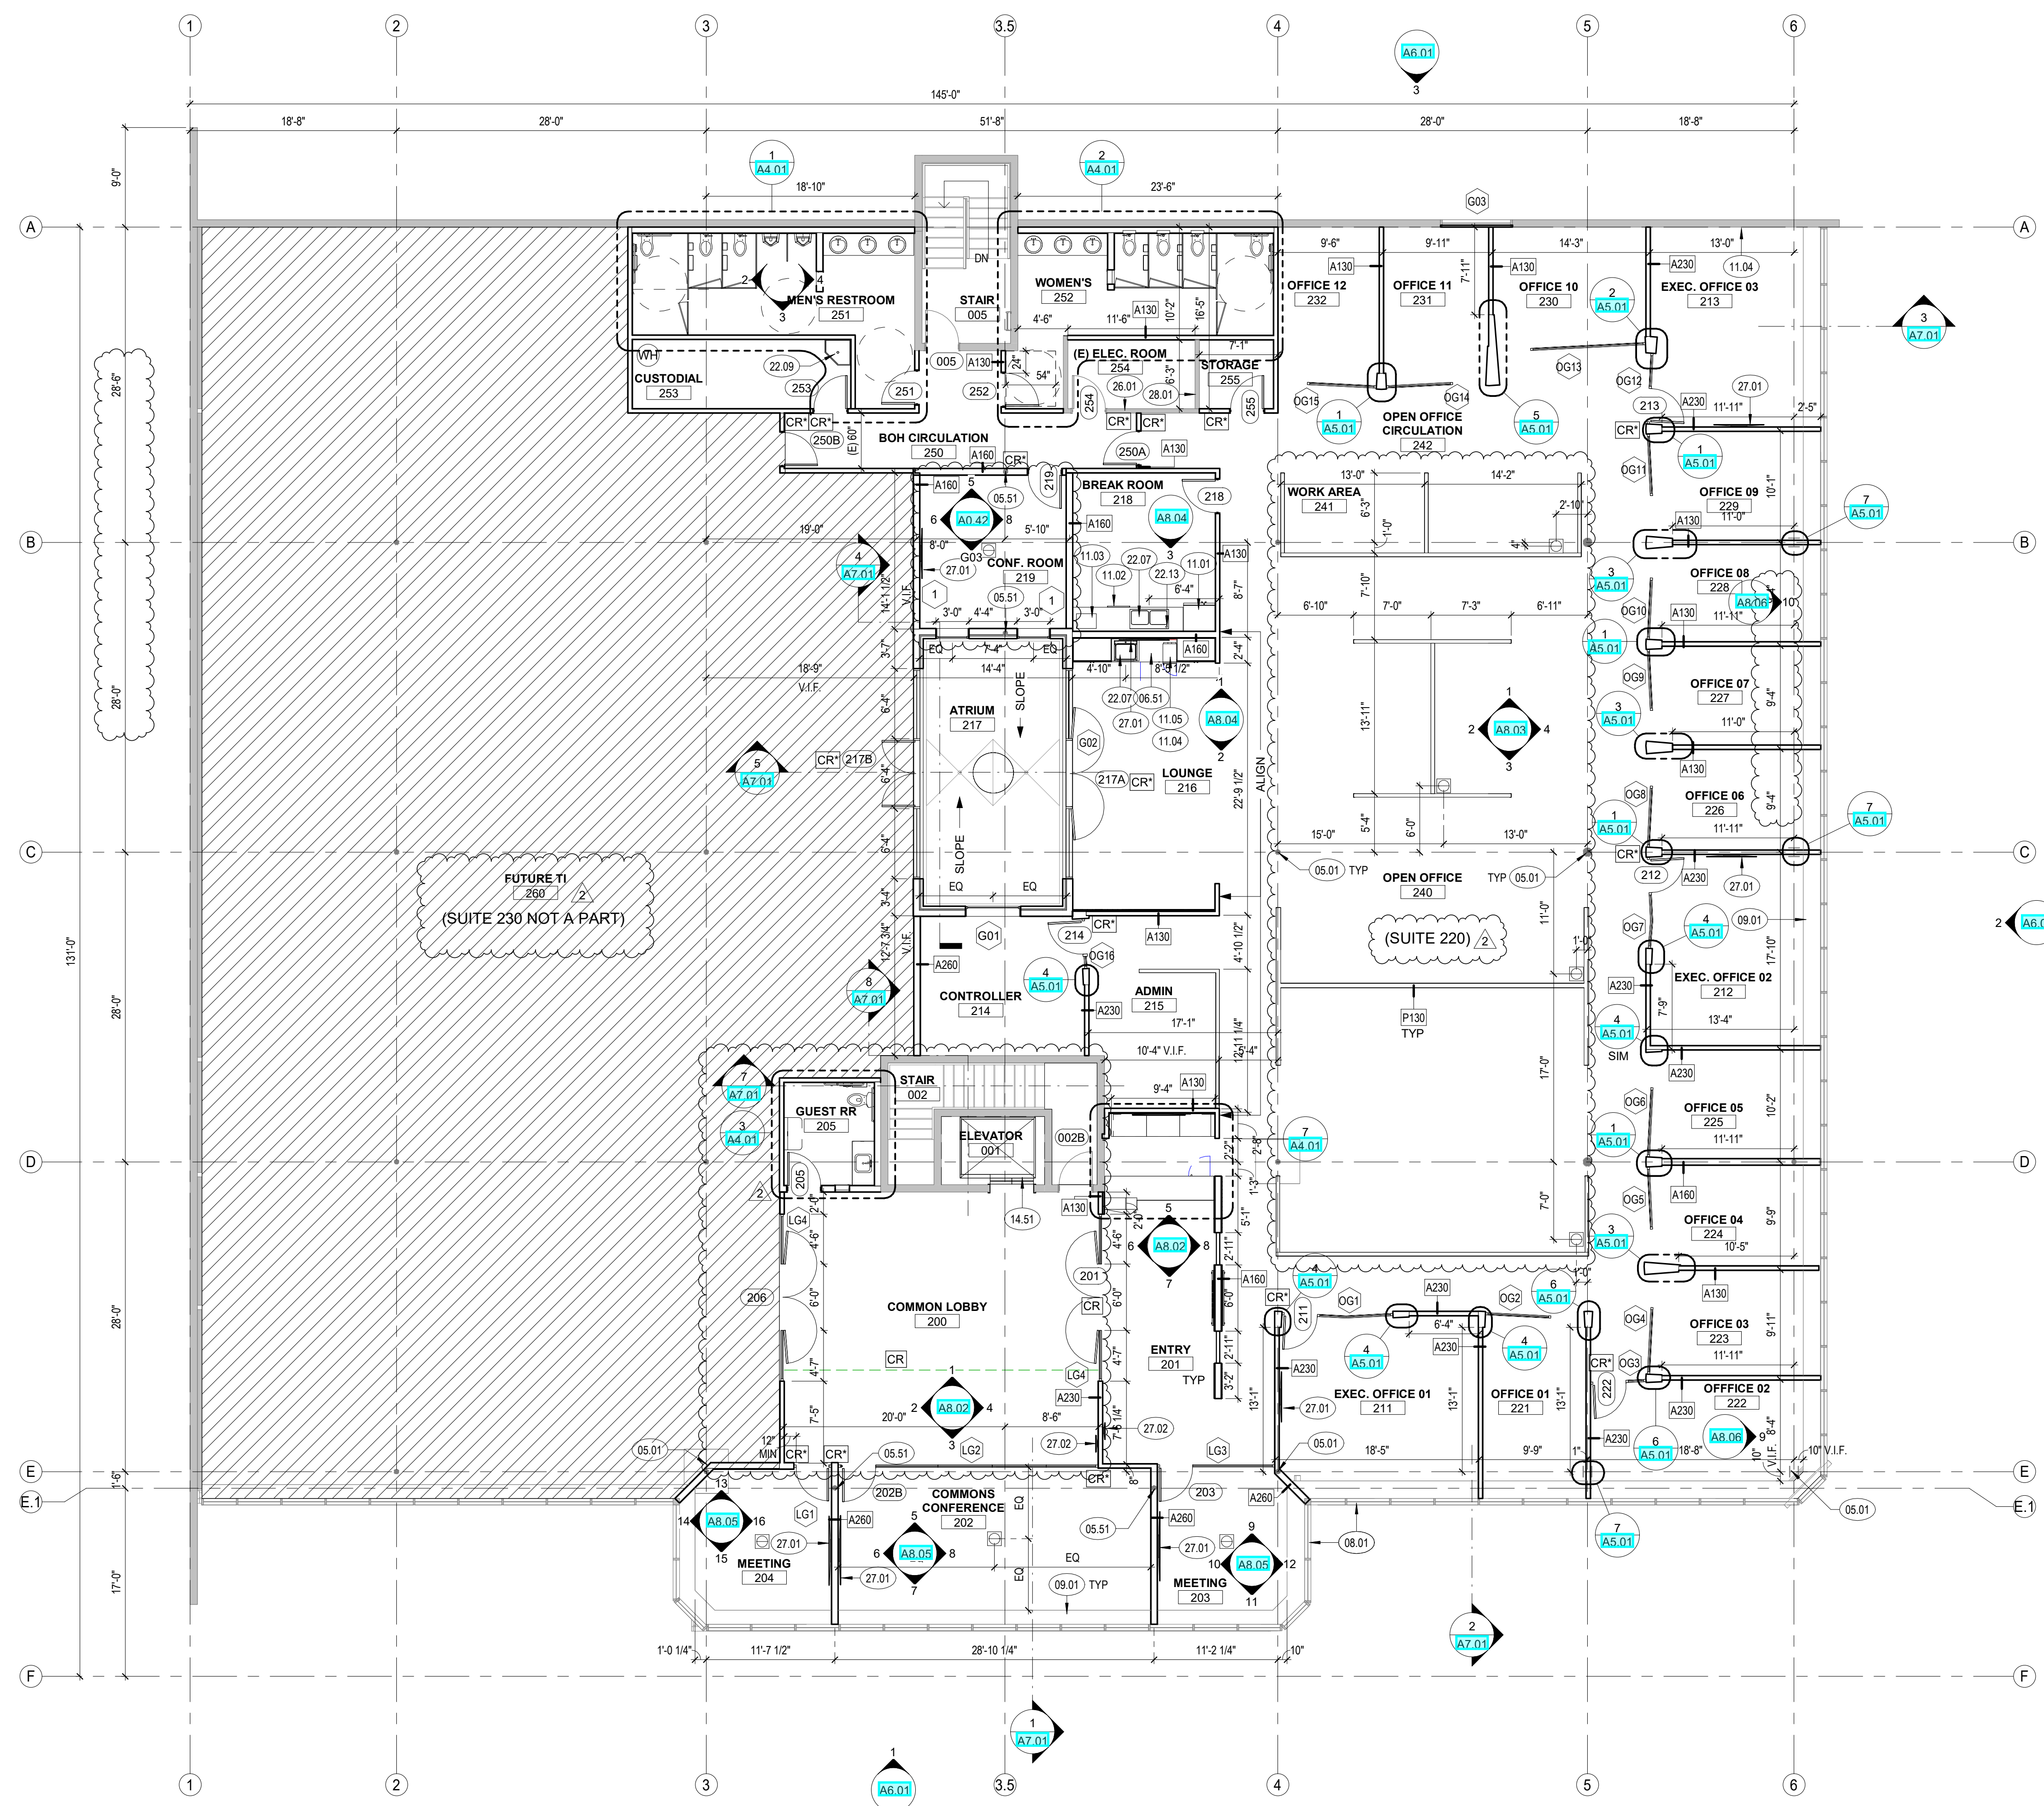

LEVEL 2 FLOOR PLAN 1/8" = 1'-0" 1

GENERAL PLAN NOTES

- ROOM AND DOOR REFERENCE NUMBERS ARE FOR CONSTRUCTION COORDINATION ONLY. CONTRACTOR SHALL COORDINATE WITH OWNER FOR FINAL ROOM & DOOR IDENTIFICATION.
- DO NOT SCALE DIMENSIONS FROM DRAWINGS. ANY UNKNOWN DIMENSION SHALL BE OBTAINED FROM DESIGN PROFESSIONALS VIA REQUEST FOR INFORMATION (RFI).
- ALL DIMENSIONS ARE TO FACE OF STUD. GRID LINES AND FACE OF MASONRY W/ELL WALL U.N.O. ALL DIMENSIONS TO EXISTING WALLS ARE TO FACE OF WALL ASSEMBLY U.N.O.
- ALL 36" WIDE INTERIOR SWING DOORS SHALL BE LOCATED 2" FROM CENTER OF DOOR TO PERPENDICULAR SURFACE OF ADJACENT WALL AT DOOR JAMB U.N.O.
- CONTRACTOR SHALL FIELD VERIFY ALL EXISTING CONDITIONS PRIOR TO COMMENCING WORK.
- CONTRACTOR SHALL NOTIFY ARCHITECT OF ANY DISCREPANCY, INACCURACY OR CONFLICTING INFORMATION BEFORE EXECUTION OF WORK.
- REFER TO WALL TYPE SCHEDULE A0.10 FOR ADDITIONAL INFORMATION.
- CONTRACTOR SHALL FIELD COORDINATE LOCATION, SIZE AND TYPE OF BLOCKING FOR INSTALLATION OF SIGNAGE, PLUMBING FIXTURES, MILLWORK, ETC. ALL CONCEALED WOOD SHALL BE FIRE RETARDANT TREATED (F.R.T.).
- PROVIDE IN-WALL REINFORCEMENT FOR ALL WALL MOUNTED FURNITURE AND EQUIPMENT AS REQUIRED.
- LEVEL 2 FLOOR SLAB IS 2HR RATED. SUBMIT UL DETAILS FOR PENETRATIONS WHERE THEY OCCUR.

PLAN GRAPHICS LEGEND

- INDICATES EXISTING PARTITION TO REMAIN
- - - - - INDICATES SCOPE OF WORK TO BE INCLUDED IN THIS PERMIT
- CR CARD READER (HARD WIRED), RE: ELECTRICAL DRAWINGS
- CR* CARD READER (WIFI) BY OWNER
- ⊠ FLOOR DATA / POWER OUTLET, LOCATE IN CENTER OF ROOM UNLESS DIMENSIONED OTHERWISE, RE: ELECTRICAL DRAWINGS

KEYNOTE LEGEND

NUMBER	DESCRIPTION
05.01	EXISTING STRUCTURAL COLUMN, PROTECT IN PLACE.
05.51	INSTALL COLUMN PER STRUCTURAL DRAWINGS.
06.51	MILLOWRK, SEE ENLARGED PLANS, DETAILS AND MATERIAL LEGEND.
08.01	EXISTING GLAZING.
09.01	EXISTING GYPSUM BOARD LEDGE, RE-FINISH AND PAINT PER SCHEDULE.
11.01	REFRIGERATOR, O.F.O.I.
11.02	DISHWASHER, O.F.O.I.
11.03	MICROWAVE, O.F.O.I.
11.04	UNDERCOUNTER REFRIGERATOR, O.F.O.I.
11.05	UNDERCOUNTER ICE MAKER, O.F.O.I.
14.51	INSTALL NEW OTIS HYDRONIFT ELEVATOR PER MFR SPECIFICATIONS, REFER TO STRUCTURAL AND ELECTRICAL DRAWINGS.
22.07	COUNTERTOP MOUNTED KITCHEN SINK AND FAUCET, RE: PLUMBING DRAWINGS.
22.09	CUSTODIAL SINK, RE: PLUMBING DRAWINGS.
22.13	RO SPIGGET.
28.01	EXISTING ELECTRICAL PANELS, REFER TO ELECTRICAL DRAWINGS.
27.01	TV MONITOR LOCATION, RE: ELECTRICAL DRAWINGS.
27.02	DIGITAL SCHEDULING DISPLAY, RE: ELECTRICAL DRAWINGS.
28.01	EXISTING FIRE ALARM TO BE RECONFIGURED TO NEW LAYOUT. SUBMIT DELEGATED SUBMITTAL.

TRE BUILDERS
 TRE BUILDERS
 7265 DEAN MARTIN DR
 SUITE 130 LAS VEGAS
 NV 89118
 F T 702.914.0360

ARCHITECT
PGAL
 PGAL, LLC
 7373 Peak Dr.
 Suite 170
 Las Vegas, NV 89128
 T 713 622 1444
 F 713 622 1444
 www.pgal.com

CONSULTANT

CONSULTANT NAME
 Address Line 1
 Address Line 2
 Address Line 3
 T Phone
 F Fax

REGISTRATION
 Copyright © 2024

BENJAMIN GIRARDIN
 REGISTERED
 No. 5878
 1/10/2025
 ARCHITECT
 STATE OF NEVADA

DRAWING HISTORY

NO.	DATE	DESCRIPTION
1	11/22/2024	PERMIT SUBMITTAL
2	01/10/2025	PERMIT REVIEW RESPONSE

KEY PLAN

PROJECT NAME
 TRE BUILDERS
 HQ

PROJECT LOCATION
 333 6TH STREET
 LAS VEGAS NV
 89101

PROJECT NUMBER
 1008194

SHEET TITLE
 LEVEL 2 FLOOR
 PLAN

SHEET NUMBER
 A2.02