


1 **Reduced As-built**
Suite 100- Level 2

Scale: 1/8" = 1'-0"

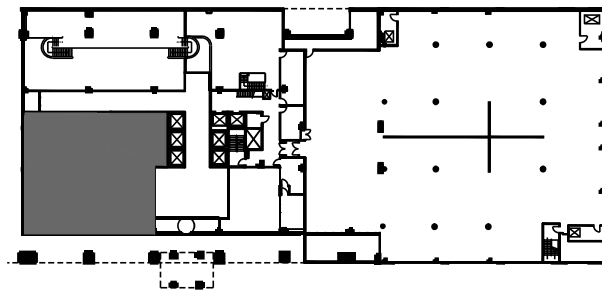

Proximity Plan

Suite 100

The Chancery

2,573 RSF (Suite 100 TOTAL 4,959 RSF)