


Floorplan - Suite 140  
1000 Crawford Place, Mount Laurel, NJ

1,522 Rentable.

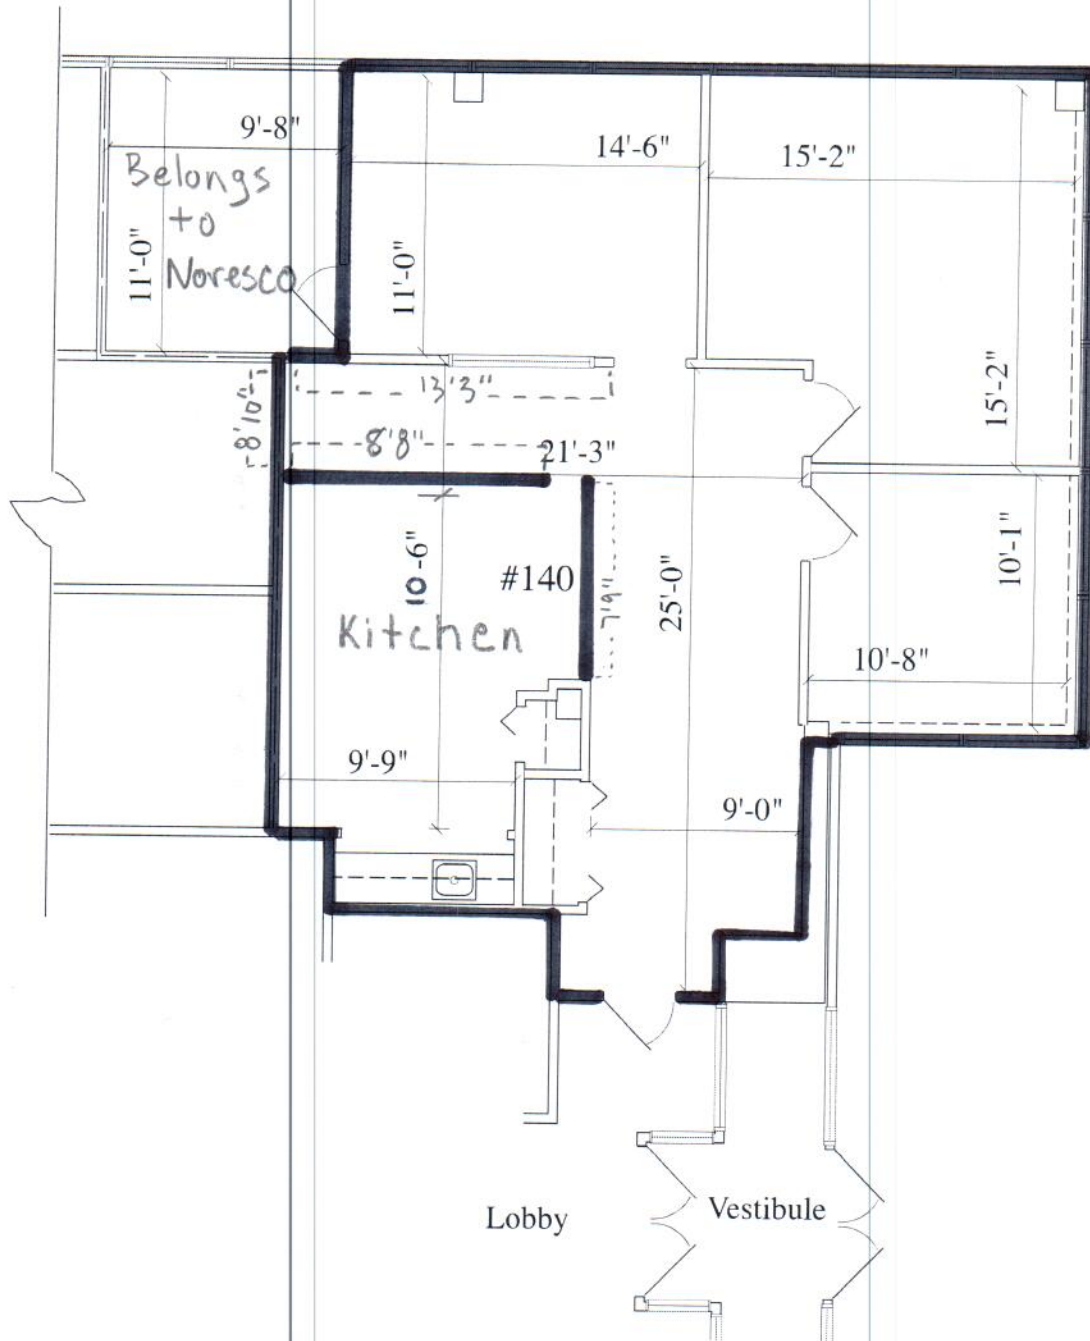

For more information:

Rebecca Ting, SIOR  
+1 856 234 9600  
rebecca.ting@naimertz.com

Julie Kronfeld, SIOR  
+1 856 802 6516  
julie.kronfeld@naimertz.com