


ESTRELLA  
MEDICAL  
CENTER

Floor 04

Suite 490  
AS-BUILT

1,401 SF  
AVAILABLE

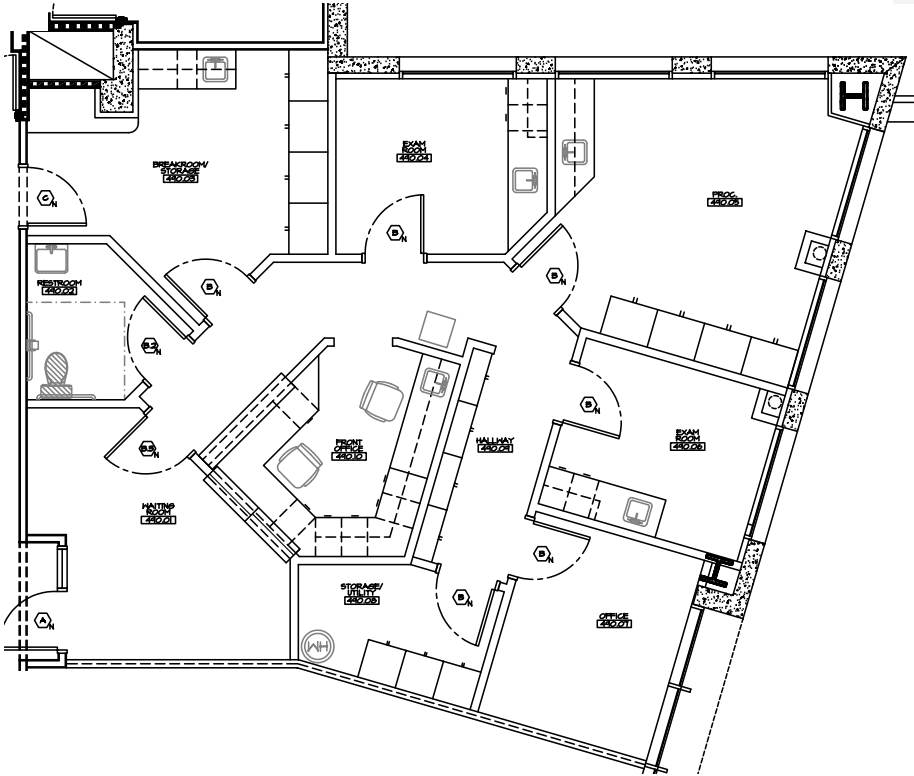

**RACHAEL THOMPSON**  
Senior Vice President  
602.513.5122  
rachael.thompson@kidder.com

**PERRY GABUZZI, CCIM**  
Senior Vice President  
602.513.5116  
perry.gabuzzi@kidder.com