


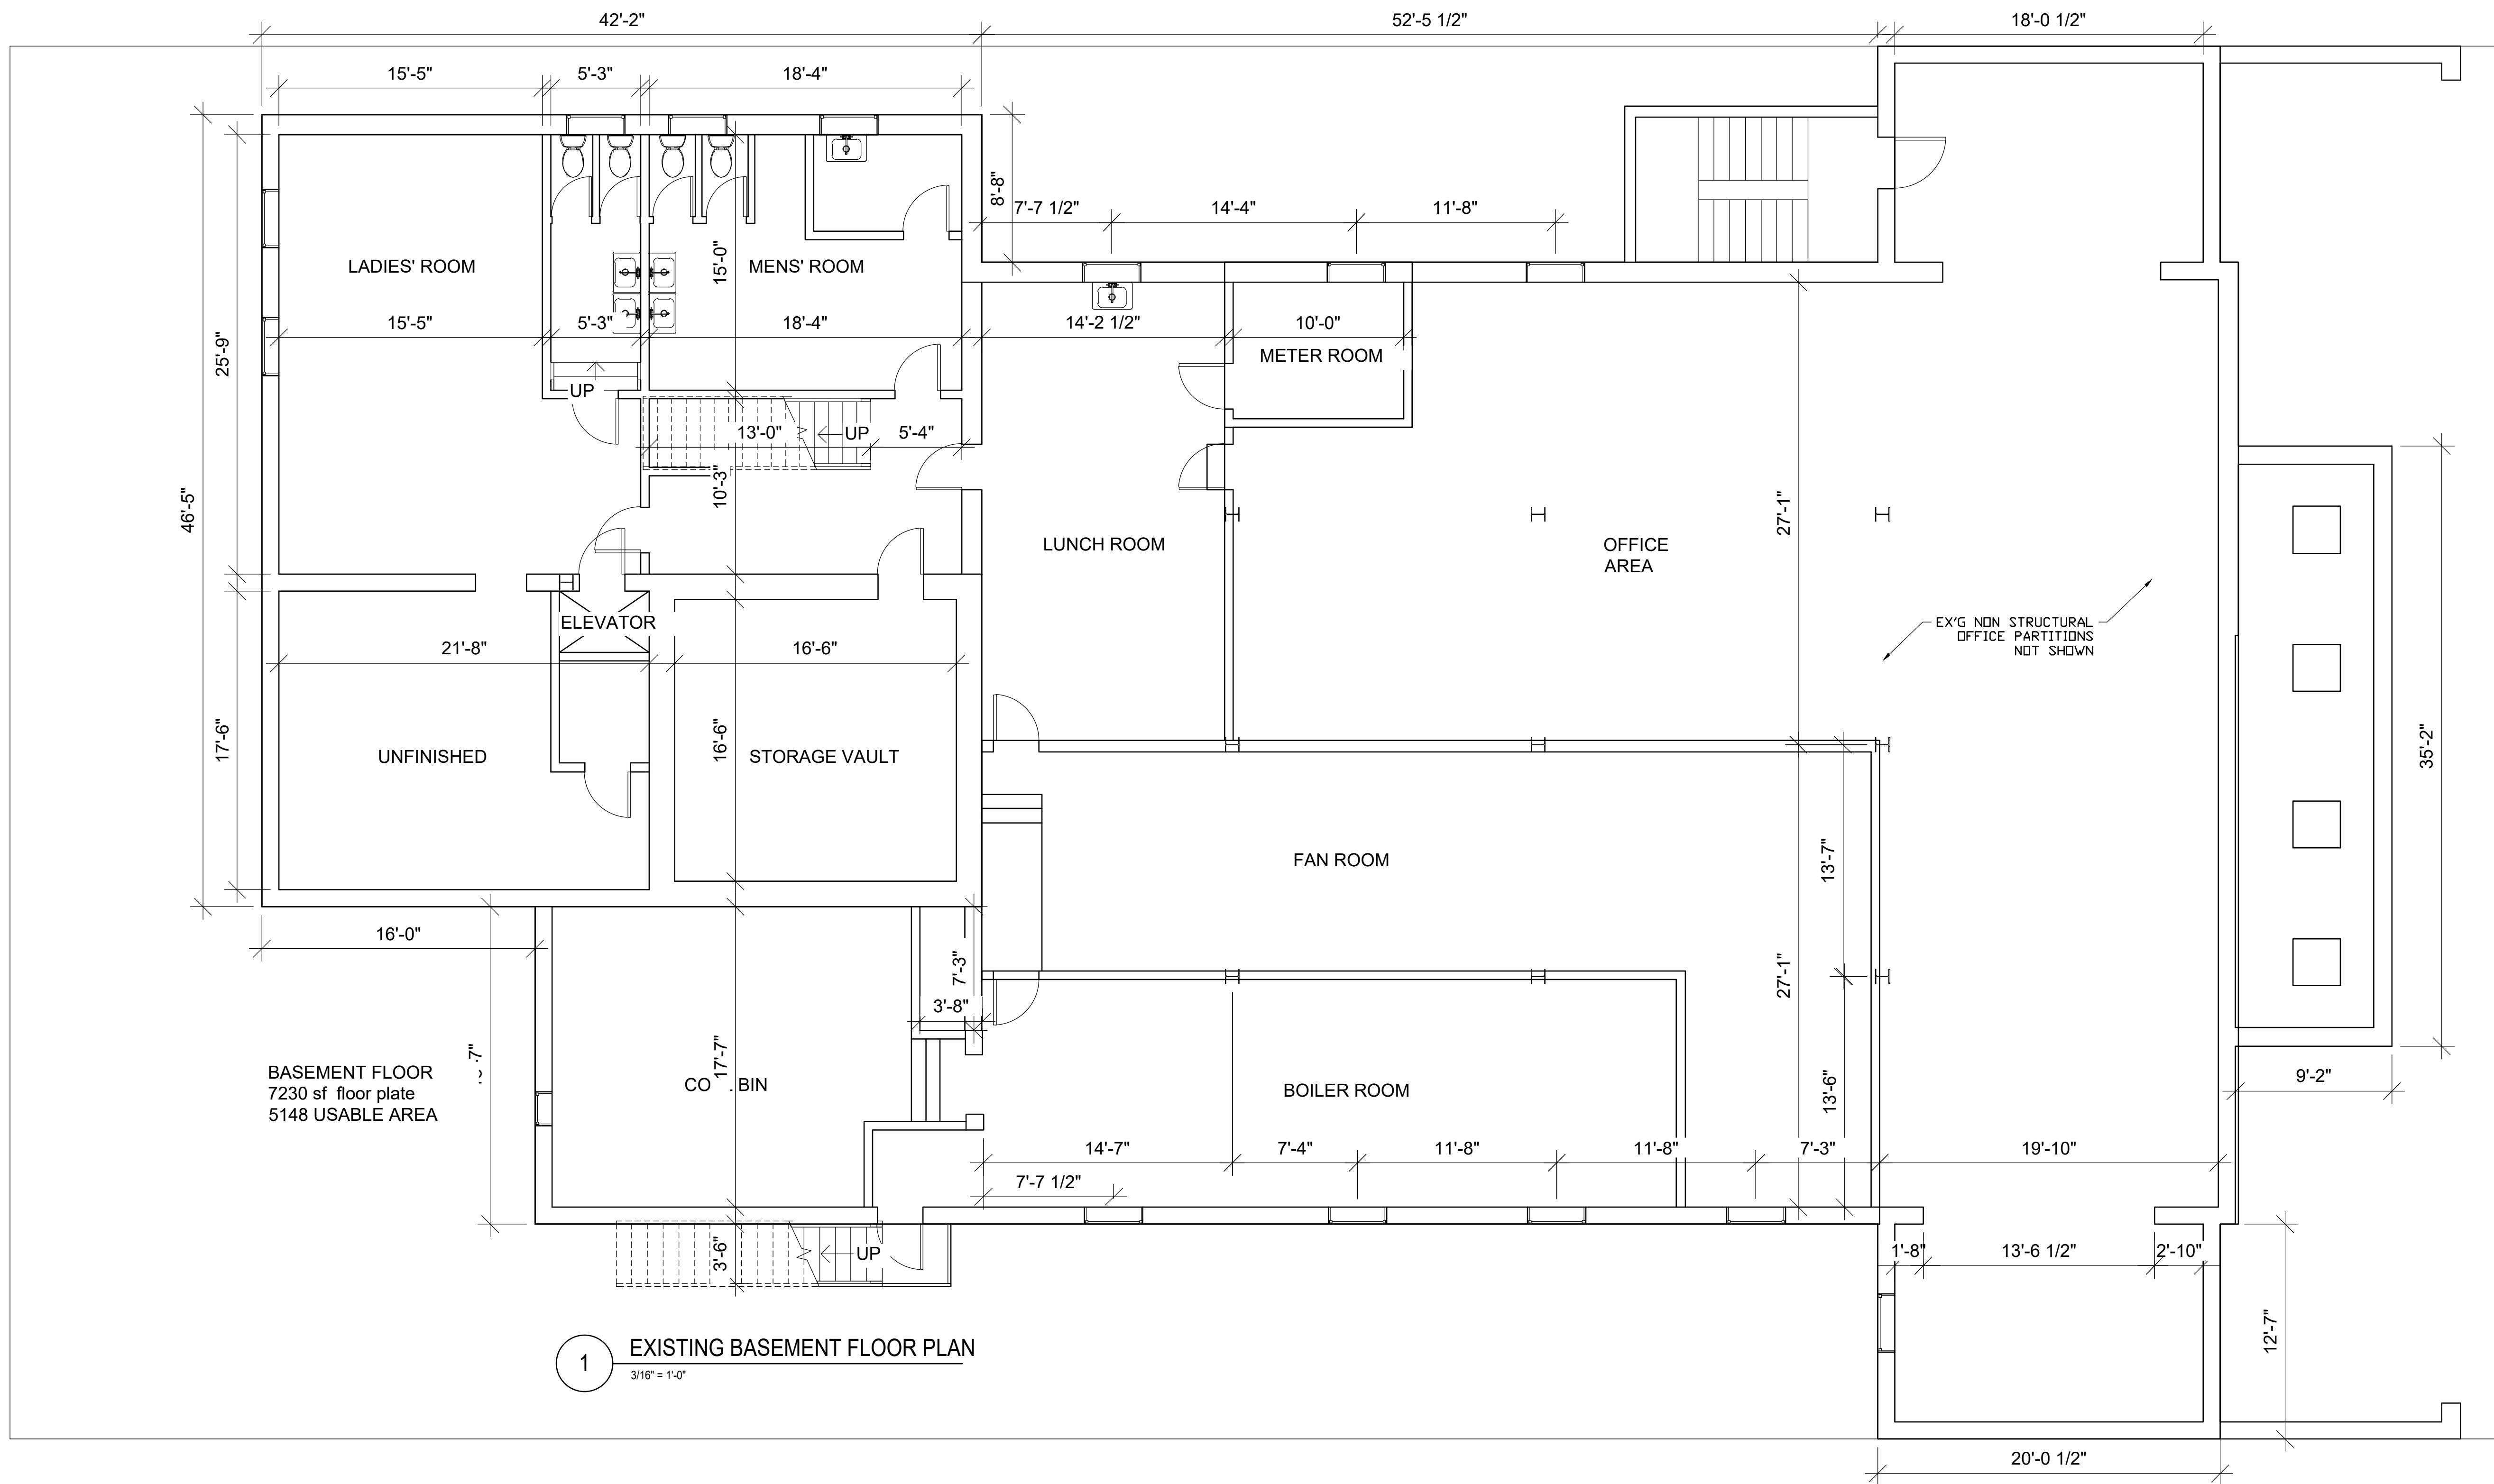

Location

460 WEST BROADWAY
S BOSTON, MASS


One Billings Road Quincy, MA 02171
617-786-7727 fax 617-786-7715

No.	Revision Date

Project No: 2023146
Scale: AS NOTED
Date: 09-12-2023
Drawn By: SL

Drawing Name

EXISTING
BASEMENT
PLAN

Sheet No.

D-1.1

Location

460 WEST BROADWAY
S BOSTON, MASS



Choo
& Company, Inc.

One Billings Road Quincy, MA 02171
617-786-7727 fax 617-786-7715

No.	Revision Date


Project No: 2023146
Scale: AS NOTED
Date: 09-12-2023
Drawn By: SL

Drawing Name


EXISTING
FIRST FL
PLAN

Sheet No.

D-1.2

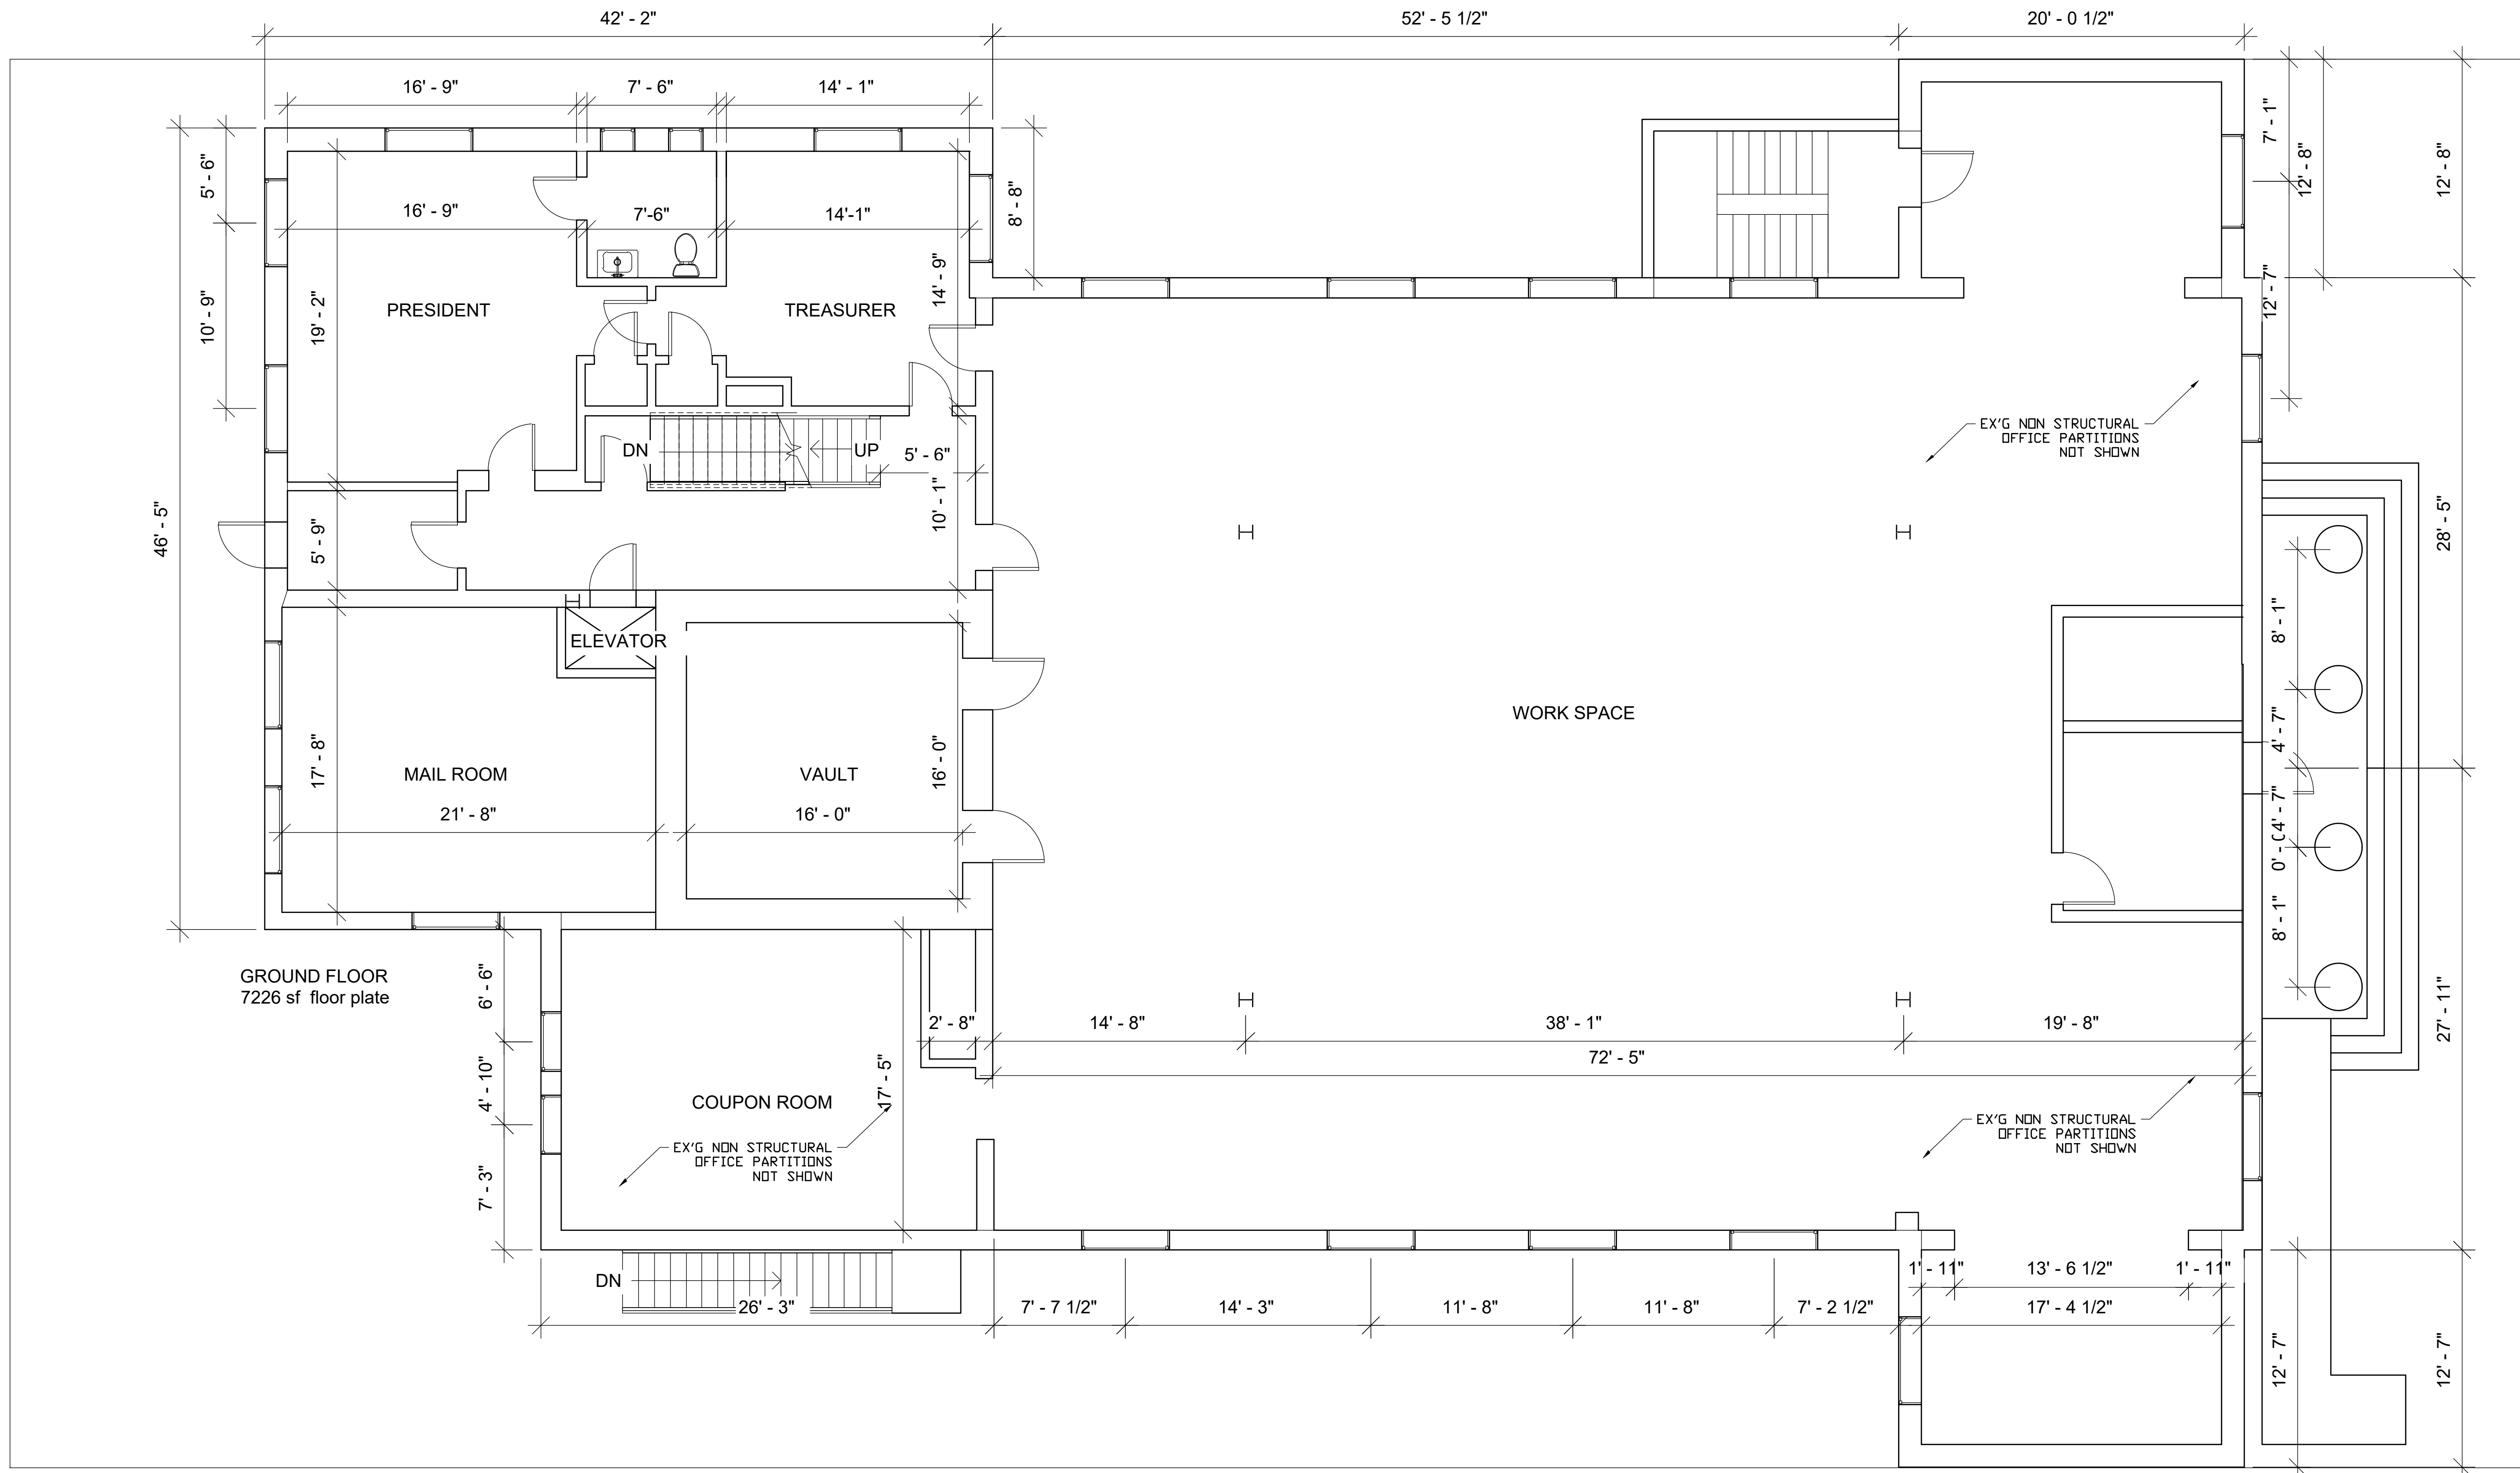


2 EXISTING FIRST FLOOR PLAN
1/4" = 1'-0"

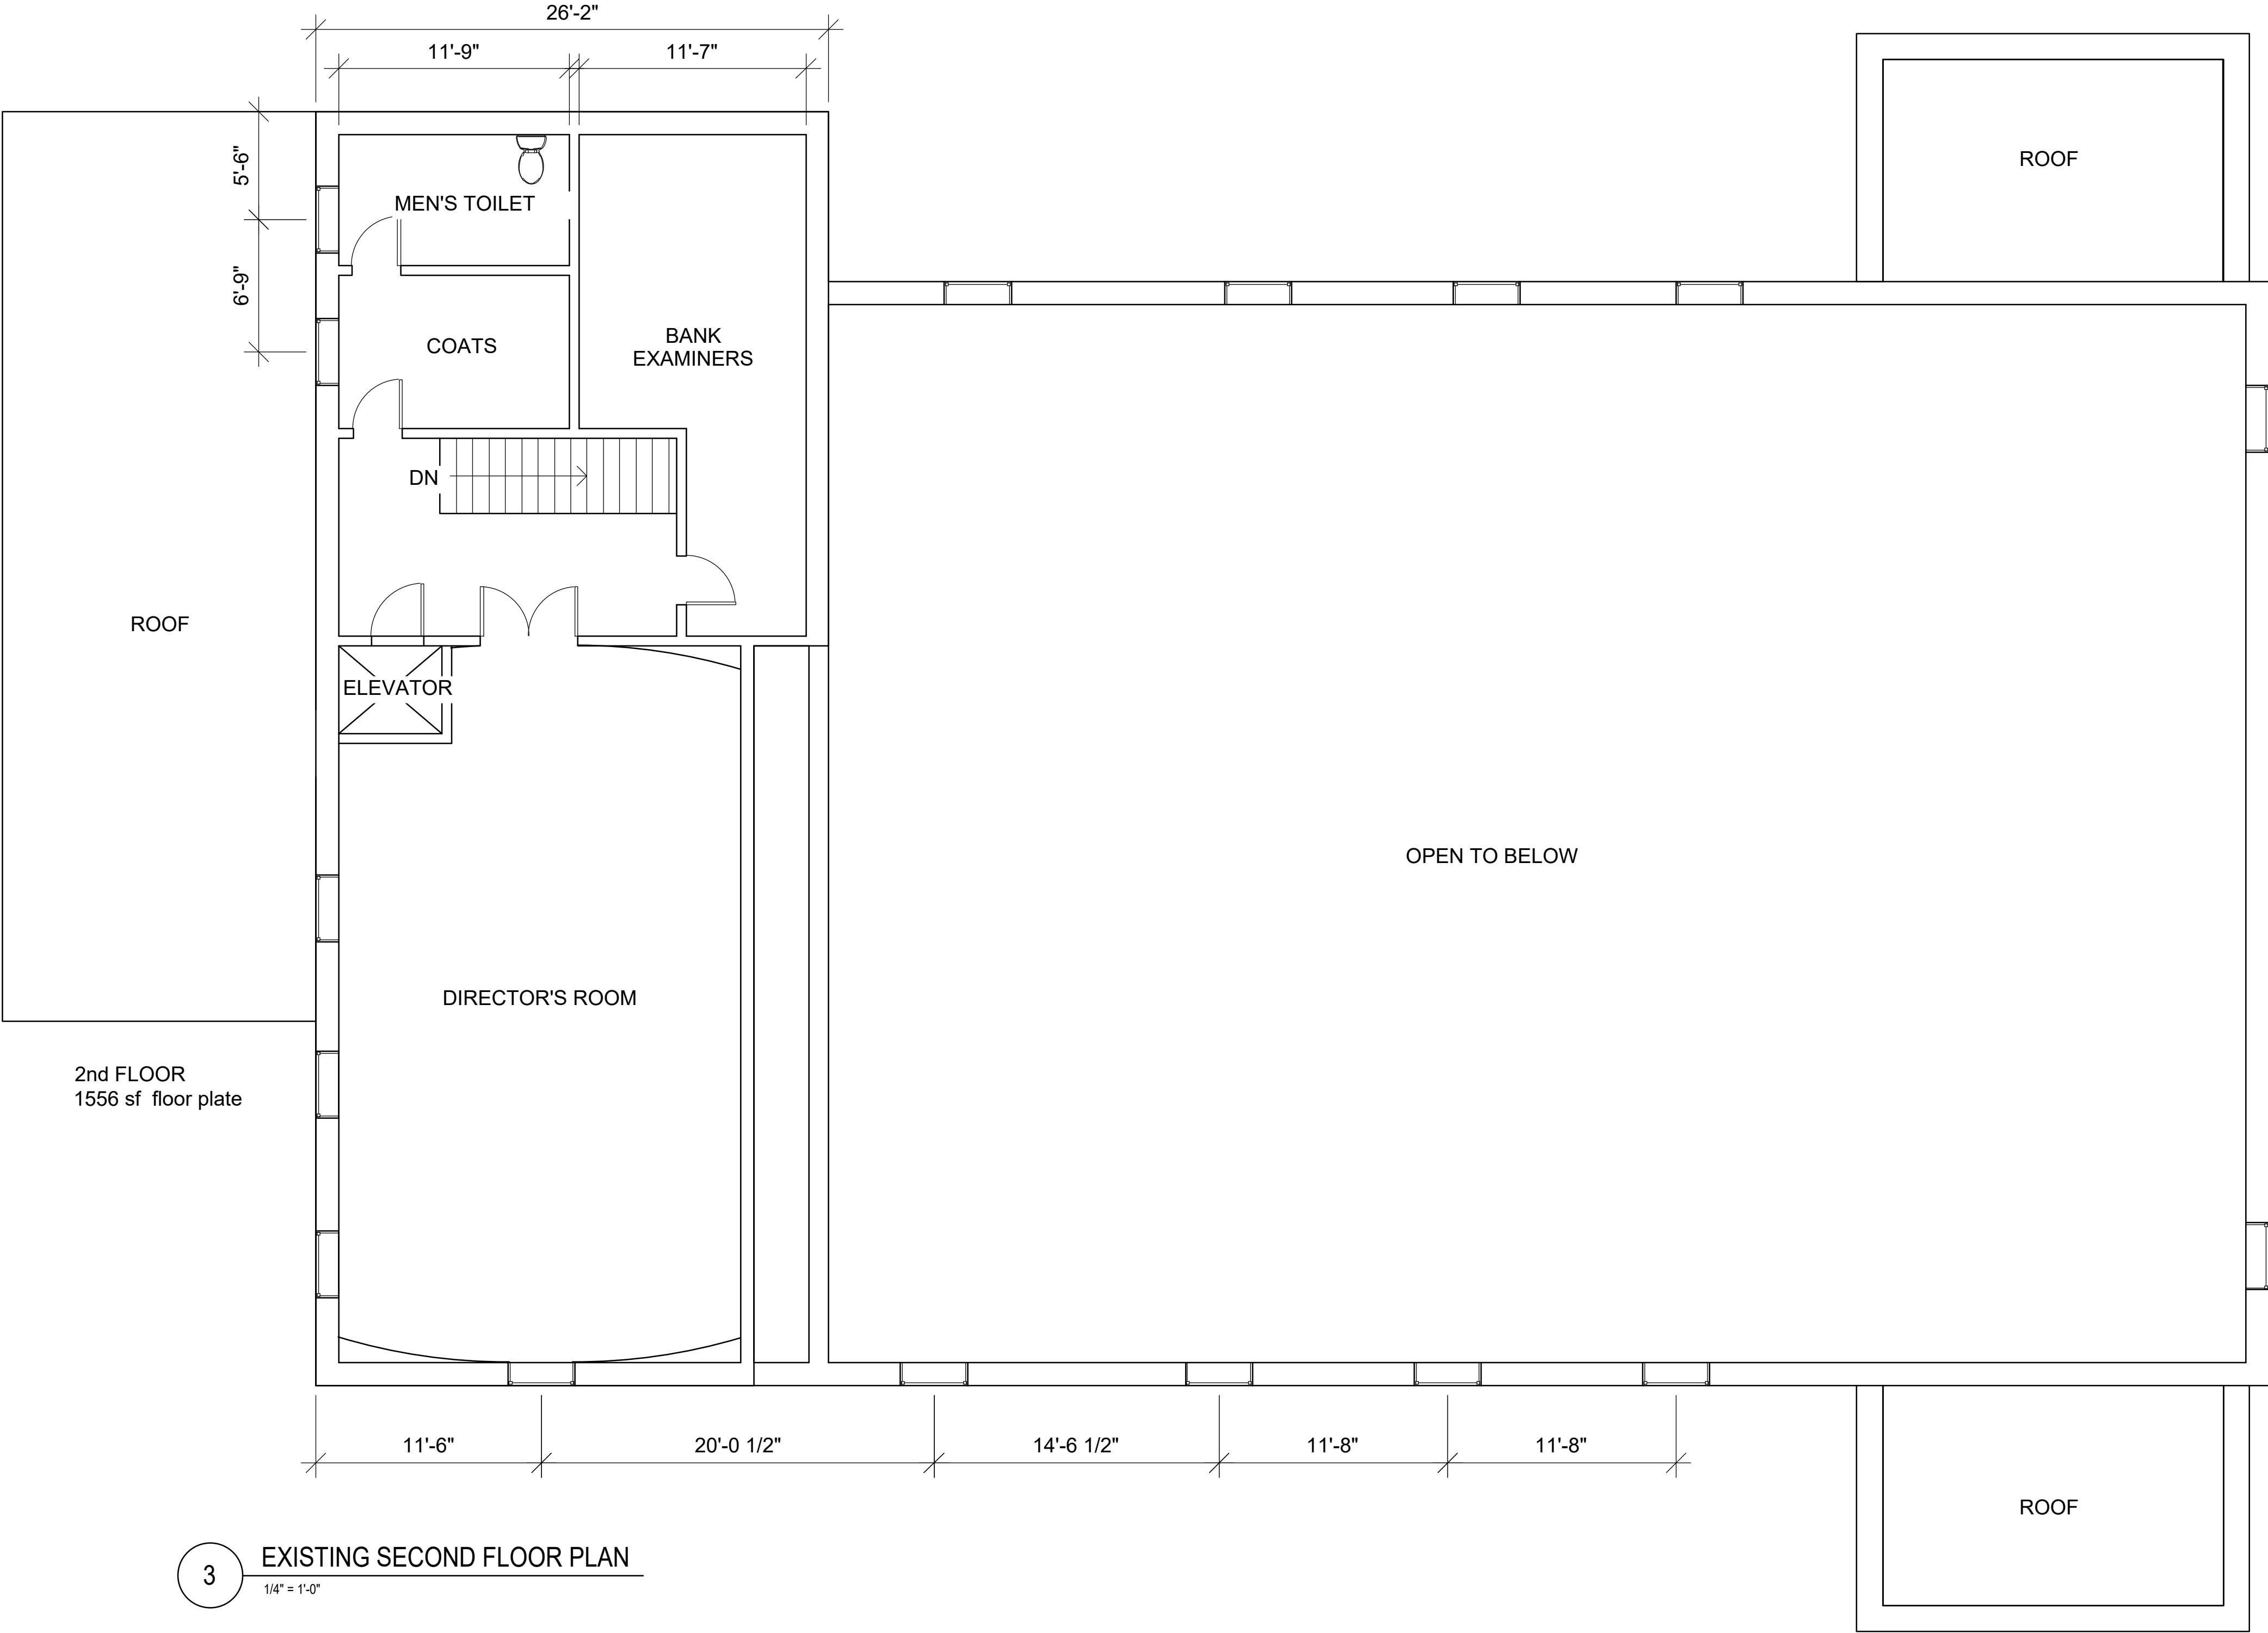

3 EXISTING SECOND FLOOR PLAN
1/4" = 1'-0"

Location

460 WEST BROADWAY
S BOSTON, MASS

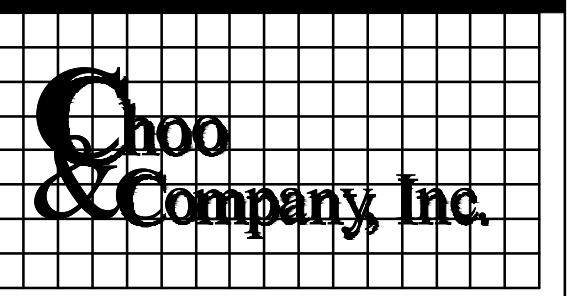

Choo
& Company, Inc.

One Billings Road Quincy, MA 02171
617-786-7727 fax 617-786-7715

No.	Revision Date

Project No: 2023146
Scale: AS NOTED
Date: 09-12-2023
Drawn By: SL

Drawing Name

EXISTING
BASEMENT
PLAN

Sheet No.

D-1.3