

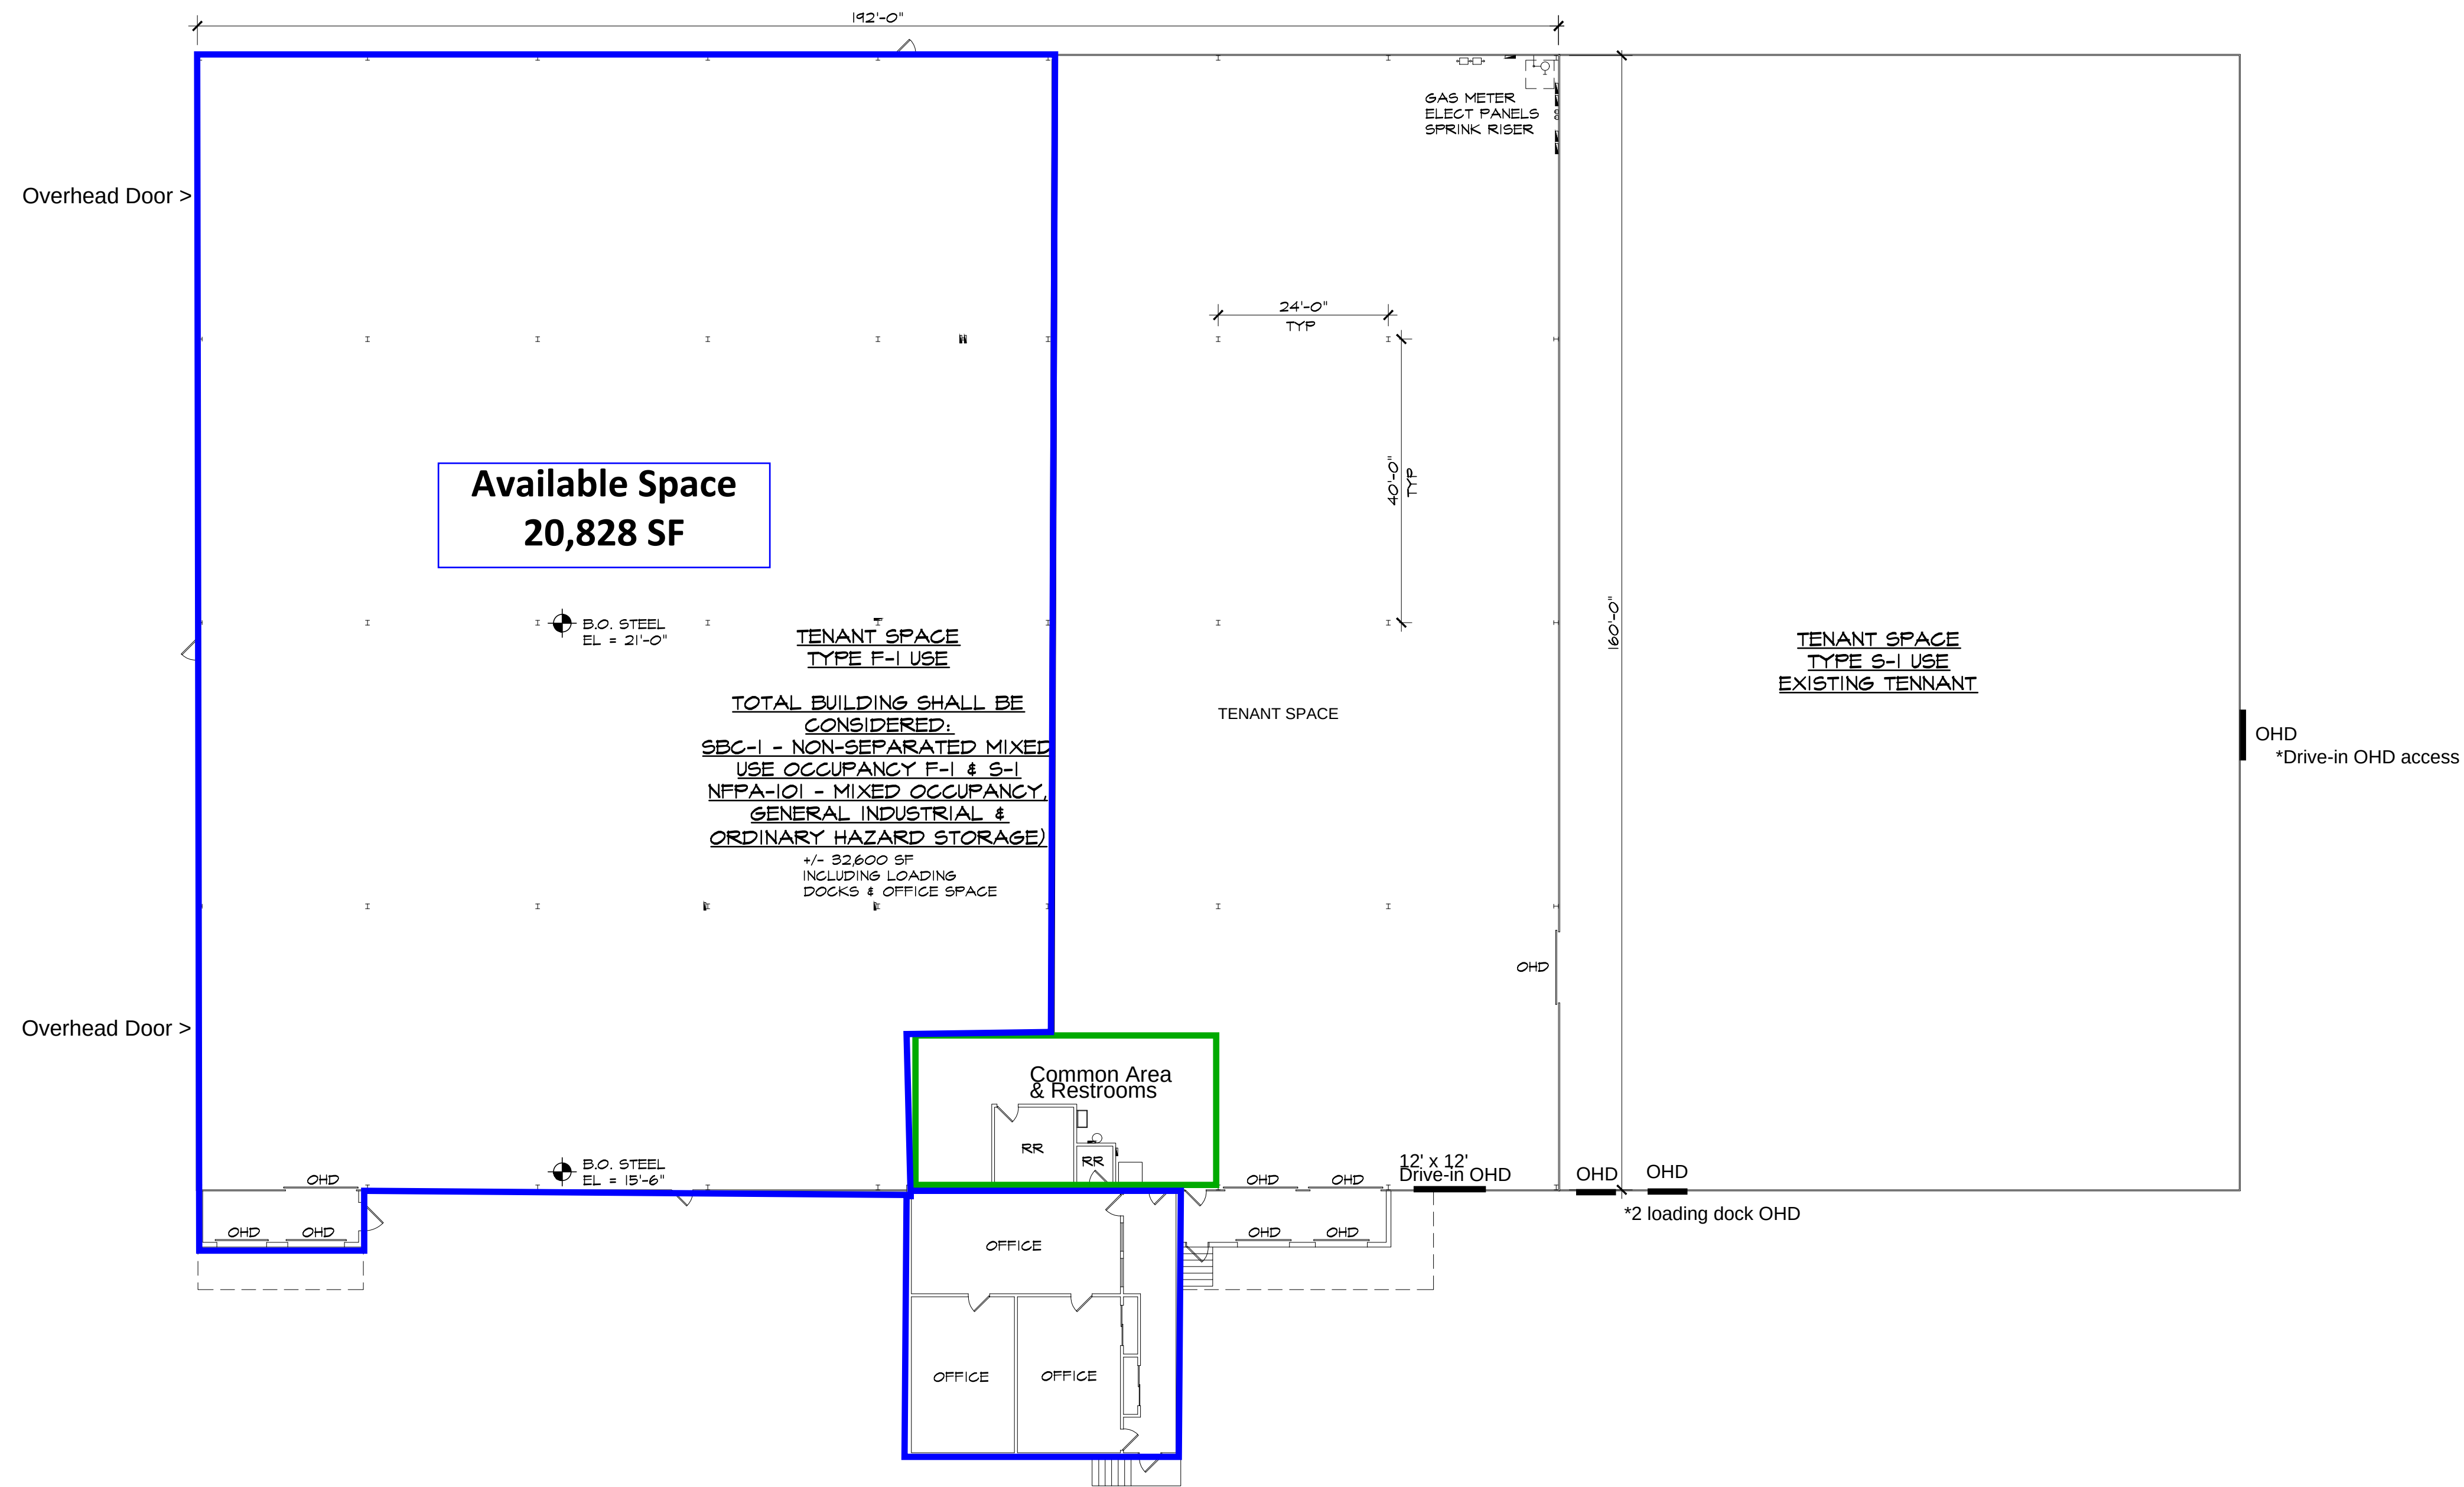


©AHARONIAN & ASSOCIATES INC 2023

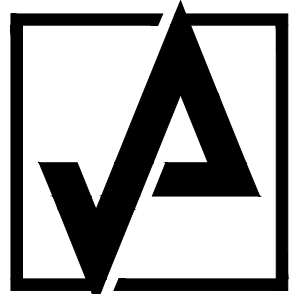

1 EXISTING FLOOR PLAN  
SCALE: 1/16" = 1'-0"

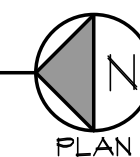

AHARONIAN  
& ASSOCIATES, INC.  
ARCHITECTS

310 George Washington Highway  
Suite 100  
Smithfield, Rhode Island  
02917

T: 401-232-5020  
F: 401-232-5080  
WWW.ARCH-ENG.COM

DISCLAIMER

OWNERSHIP AND USE OF DOCUMENTS, DRAWINGS AND SPECIFICATIONS ARE INSTRUMENTS OF PROFESSIONAL SERVICE AND SHALL REMAIN THE PROPERTY OF THE ARCHITECT. THESE DOCUMENTS ARE NOT TO BE USED, IN WHOLE OR IN PART, FOR ANY OTHER PROJECTS OR PURPOSES OR BY ANY OTHER PARTIES THAN THOSE PROPERLY AUTHORIZED BY CONTRACT WITHOUT THE EXPRESS WRITTEN AUTHORIZATION OF THE ARCHITECT.

REVISIONS

| △<br>NUMBER | REMARKS | DATE |
|-------------|---------|------|
|             |         |      |
|             |         |      |
AS-BUILT

PROJECT TITLE

289 KILVERT ST  
WARWICK, RI 02886  
Kent County

DRAWING TITLE

EXISTING FLOOR  
PLAN

|                      |                  |
|----------------------|------------------|
| DATE<br>MAY 16, 2023 | PROJ NO<br>23103 |
| DRAWN BY<br>DH       | CHECKED BY<br>DH |

DRAWING NUMBER

X1.1