
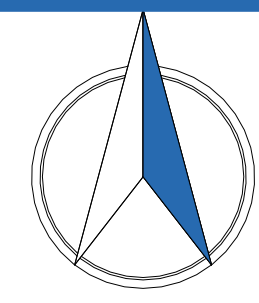



Property Key

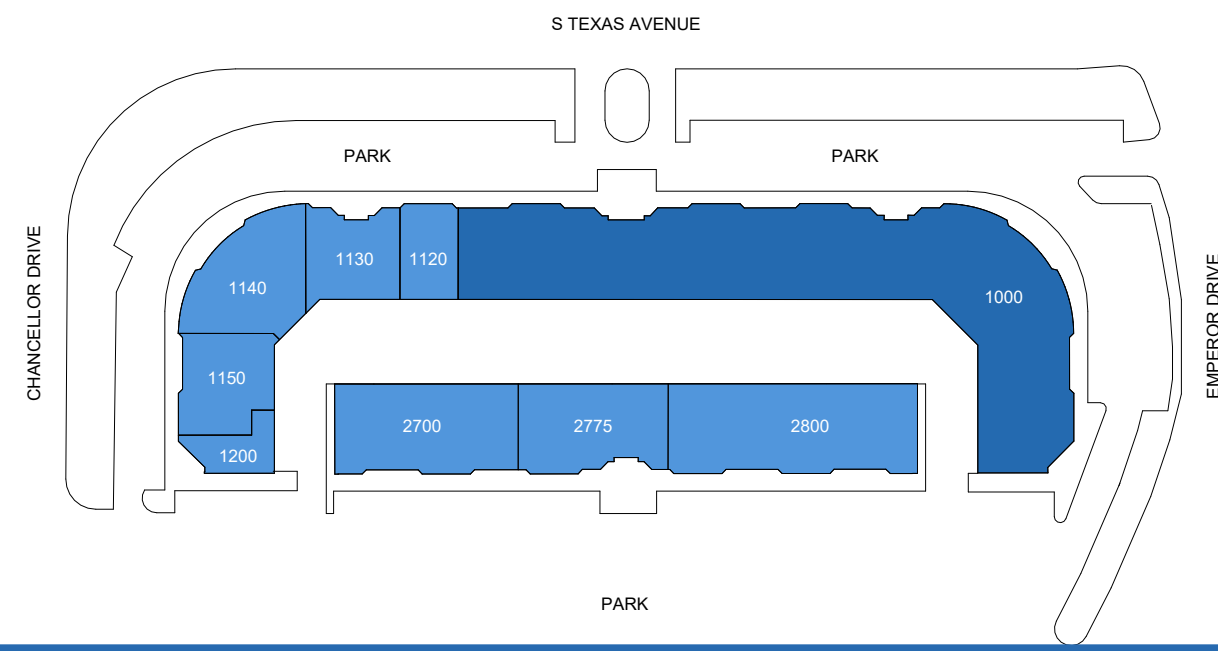

Lakefront As Built Marketing Package

6101 Chancellor Dr, Orlando, FL 32809, US

Building: 6101
Suite: 1000
Sheet **E1**

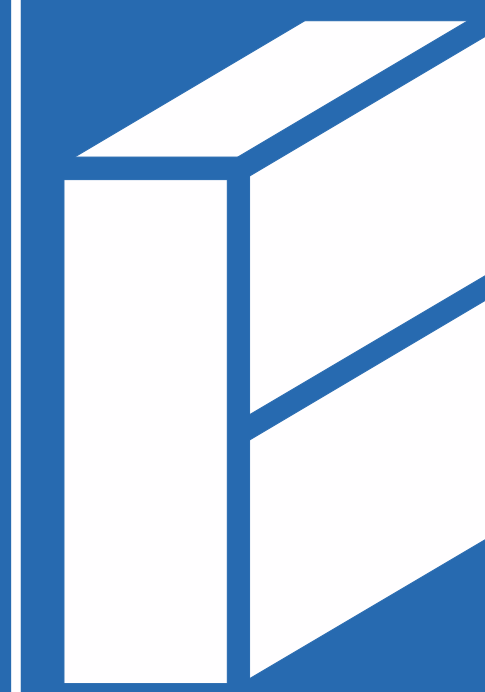

BAY SPACE


Scale: Not to Scale
Sheet Size: 42" x 30"
Not For Construction

Usable Square Foot Analysis

Office Area	46,886	100 %
Warehouse Area	0	0%
Total Area	46,886	

Building Information

Deck Height:	N/A	
Clear Height:	8' - 10 3/4"	
Ceiling Height:	8' - 10 3/4"	
Sprinklered:	<input checked="" type="checkbox"/> Yes	<input type="checkbox"/> No
Mechanical Area:	100 SQFT	

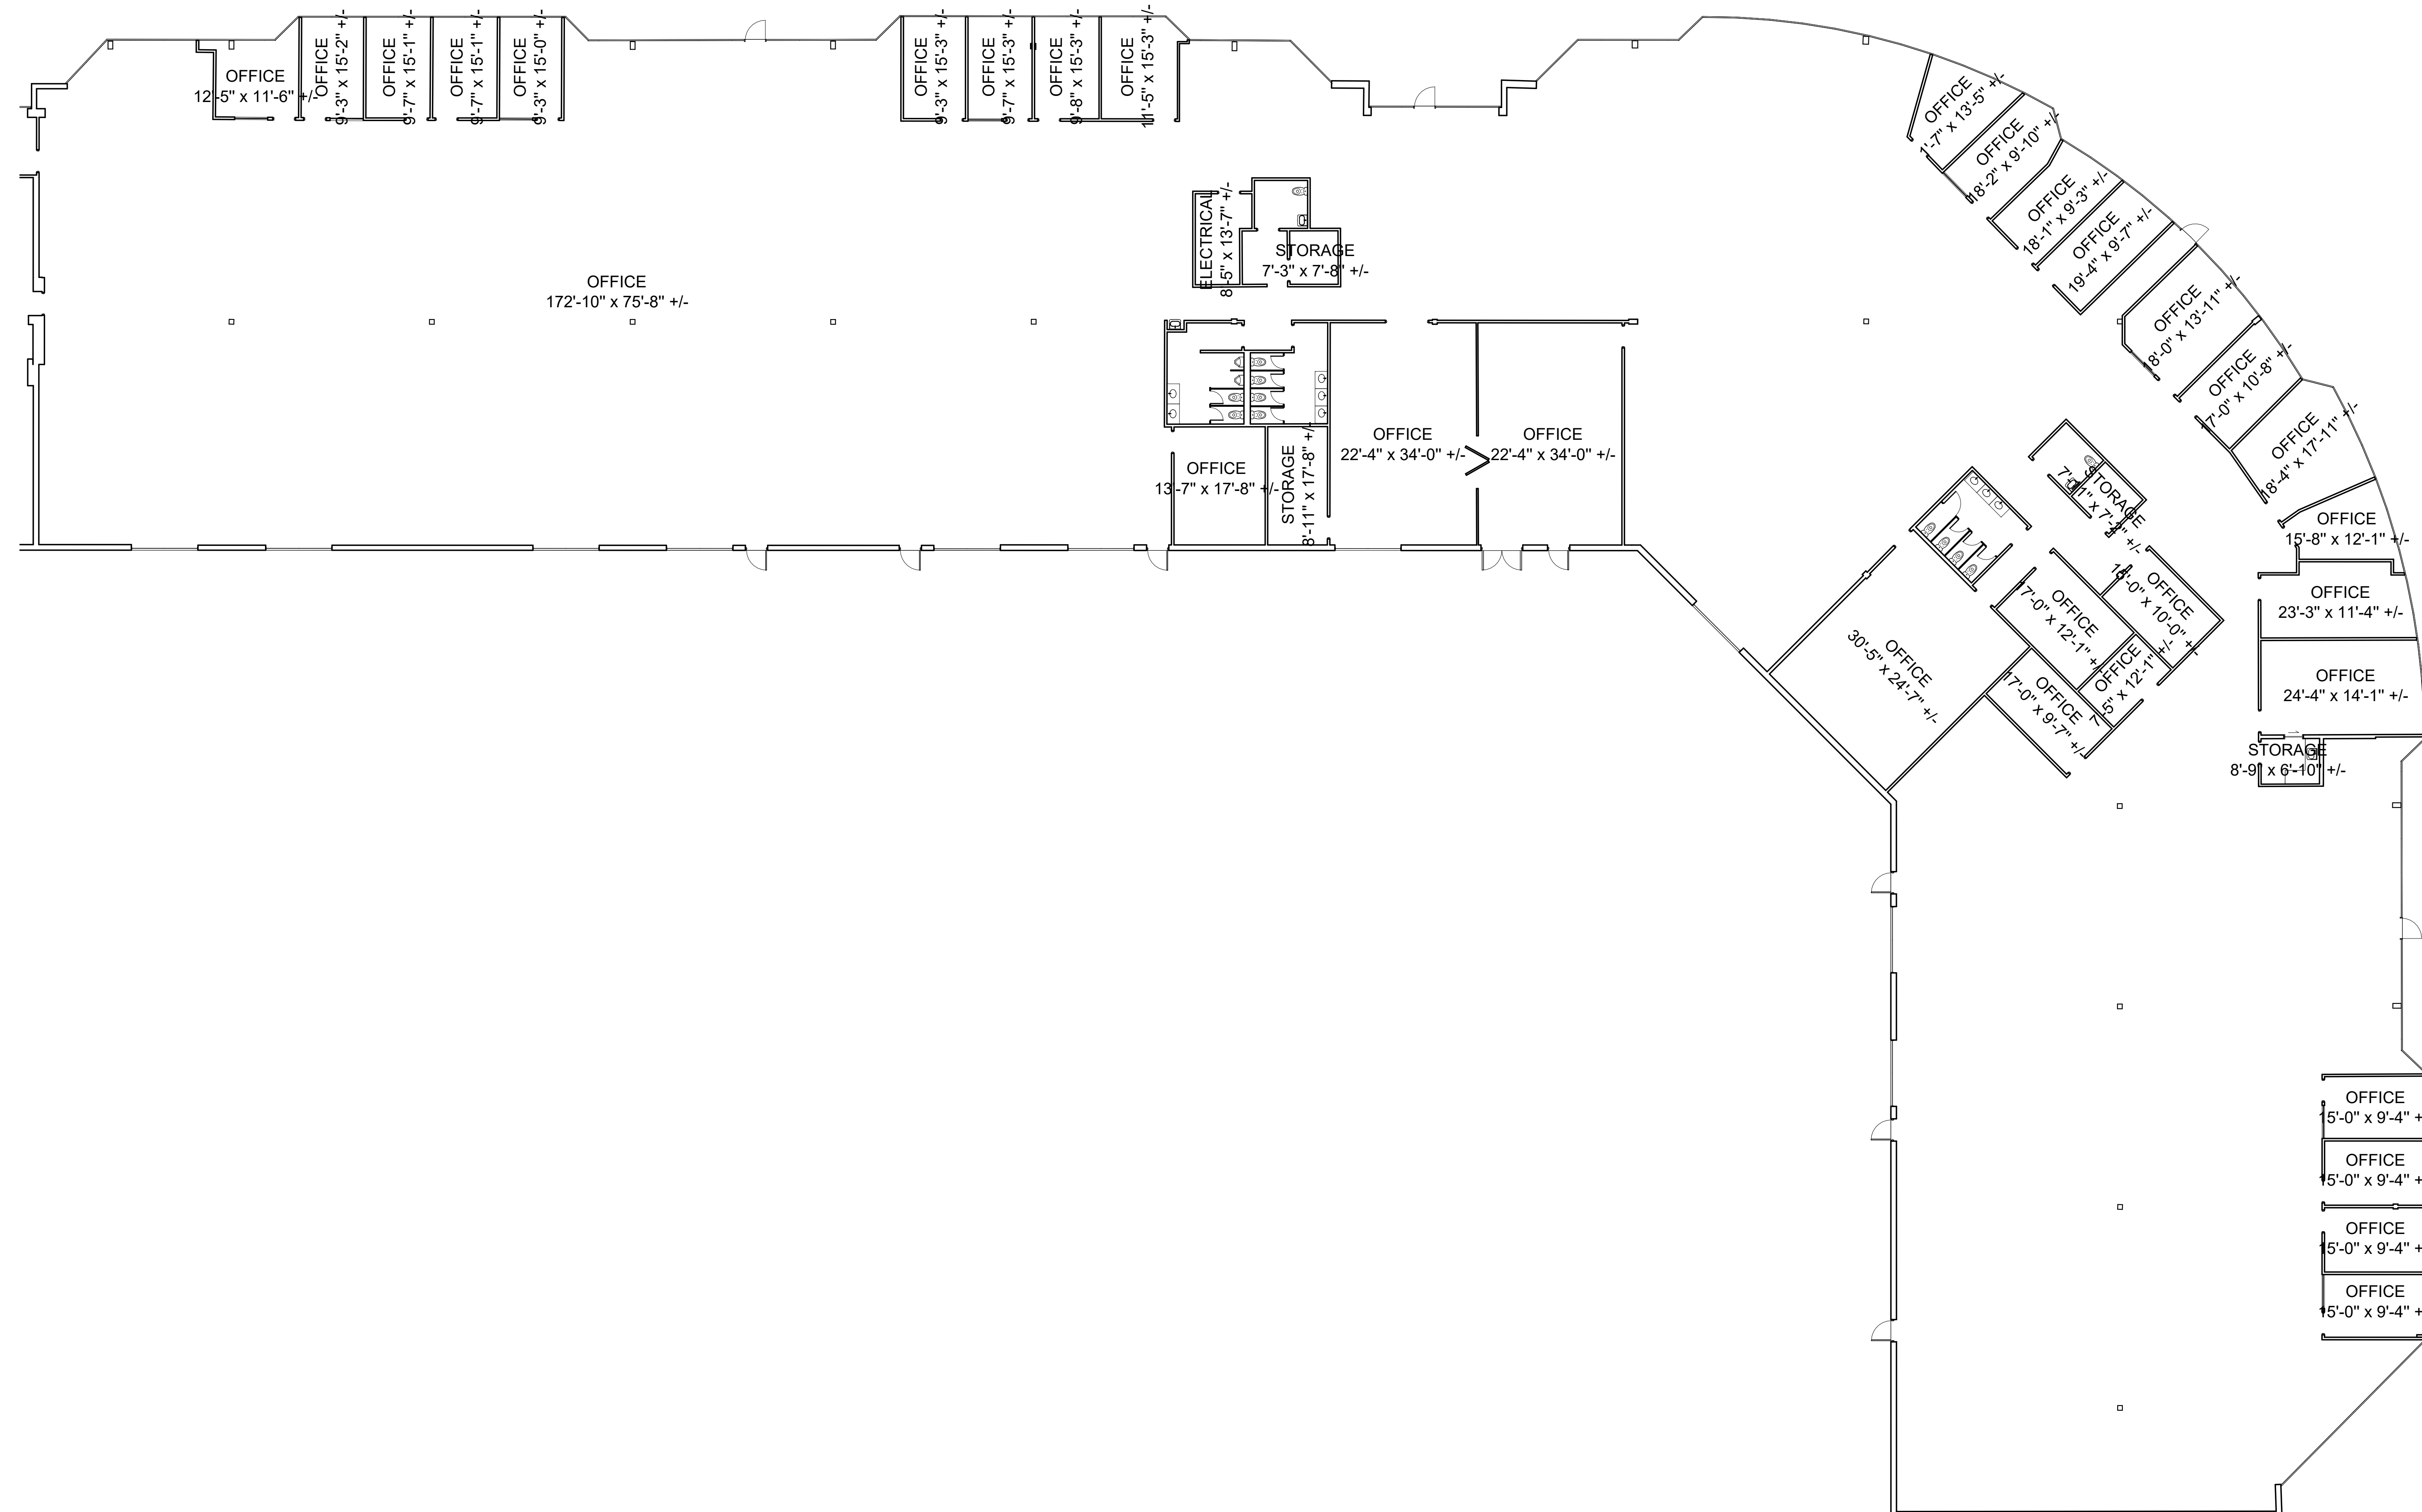

1000
1 : 140

