


Property Key

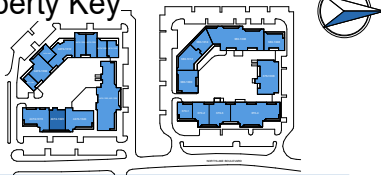

Alt Springs As Built Marketing Package

474 Northlake Blvd, Alt Springs, FL 32701, US

Building: 474

Suite: 1020

Sheet **E1**

Scale: Not to Scale
Sheet Size: 42" x 30"
Not For Construction




Usable Square Foot Analysis

Office Area	3,915	100 %
Warehouse Area	0	0%
Total Area	3,915	

Building Information

Deck Height:	13' - 6 1/2"
Clear Height:	10' - 5"
Ceiling Height:	8' - 9"
Sprinklered:	<input checked="" type="checkbox"/> Yes <input type="checkbox"/> No
Mechanical Area:	0 SQFT

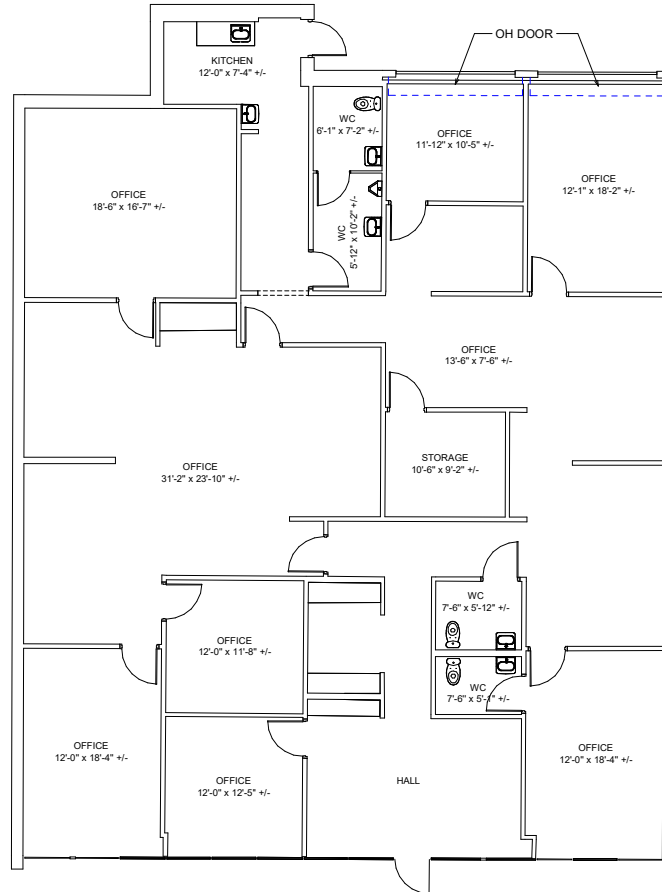

As Built Floor Plan for Marketing

